


This map is not intended to provide legal dimensions or locations of ownership lines.

**RECEIVED**  
**FEB 25 2015**  
**OWRD**

- Pipelines**
- 12 inch
  - 10 inch
  - 6 inch
  - 8 inch

Well 1, MALH 723 (repairs MALH 53474) is located in T18S, R41E, Section 26 in the NW SE; 1,360 feet west and 1,740 feet north of the SE corner of section 26.

Well 2, MALH 53231 is located in T18S, R41E, Section 25 in the SW NW; 850 feet east and 3,340 feet north of the SW Corner.

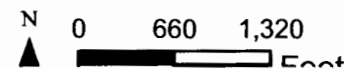

Groundwater Permit Application

Bill and Cindy

6-18002