


G-18003 Woodburn Organic Farms amended map

RECEIVED

SEP 22 2015



WATER RESOURCES DEPT
SALEM, OREGON

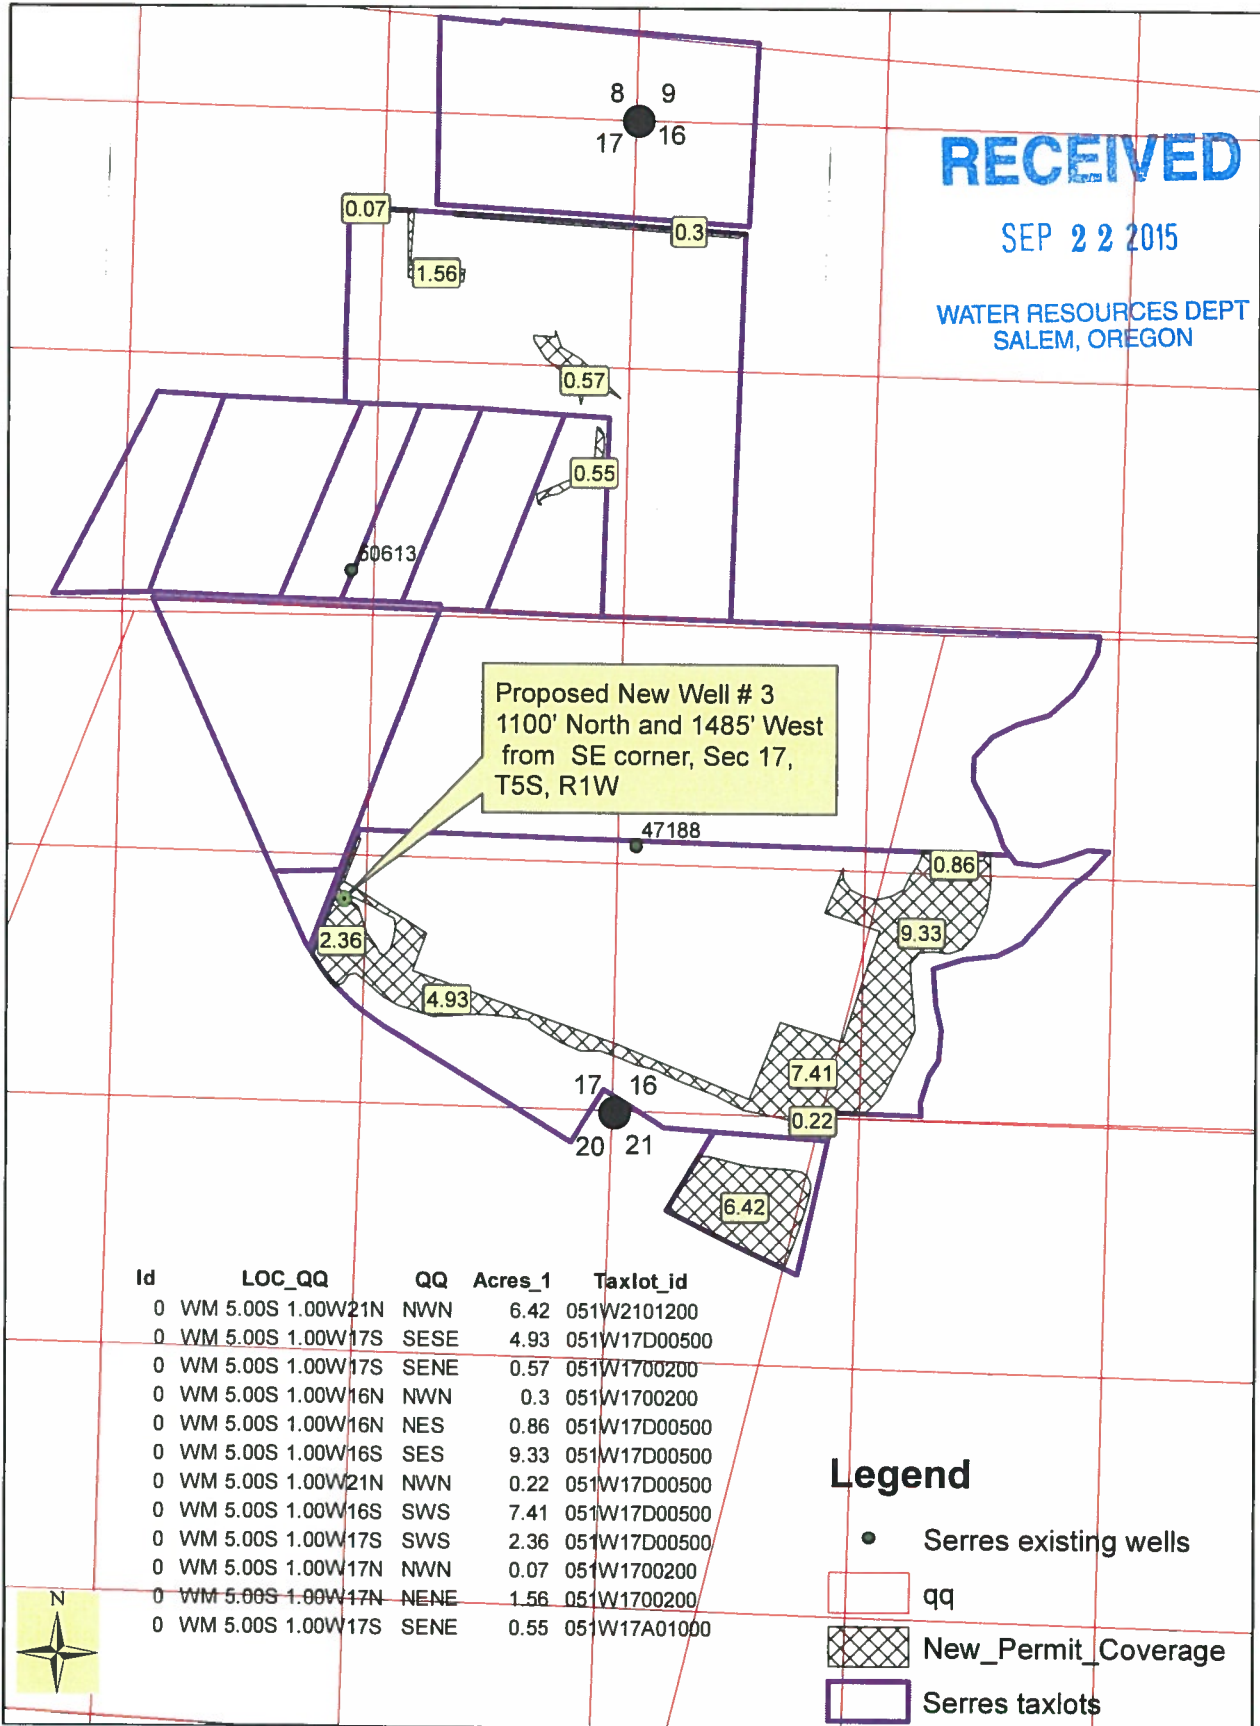

0 330 660 1,320 Feet

FID	Shape *	Id	project_na	LOC_QQ	QQ	prisup	Acres_1	Taxlot_Id
75	Polygon	0	serres permit	WM 5.00S 1.00W17SENE		PRI	1.89	051W17A01000
76	Polygon	0	serres permit	WM 5.00S 1.00W17NESE		PRI	3	051W1700300
77	Polygon	0	serres permit	WM 5.00S 1.00W21NWNW		PRI	6.42	051W2101200
78	Polygon	0	serres permit	WM 5.00S 1.00W17SESE		PRI	4.93	051W17D00500
79	Polygon	0	serres permit	WM 5.00S 1.00W17SENE		PRI	0.57	051W1700200
80	Polygon	0	serres permit	WM 5.00S 1.00W16NWNW		PRI	0.3	051W1700200
81	Polygon	0	serres permit	WM 5.00S 1.00W16NESW		PRI	0.86	051W17D00500
82	Polygon	0	serres permit	WM 5.00S 1.00W16SESW		PRI	9.33	051W17D00500
83	Polygon	0	serres permit	WM 5.00S 1.00W21NWNW		PRI	0.22	051W17D00500
84	Polygon	0	serres permit	WM 5.00S 1.00W16SWSW		PRI	7.41	051W17D00500
85	Polygon	0	serres permit	WM 5.00S 1.00W17SWSE		PRI	2.36	051W17D00500
86	Polygon	0	serres permit	WM 5.00S 1.00W17NWNE		PRI	0.07	051W1700200
87	Polygon	0	serres permit	WM 5.00S 1.00W17NENE		PRI	1.56	051W1700200

38.92 ✓ = 0.49 cfs

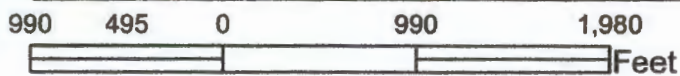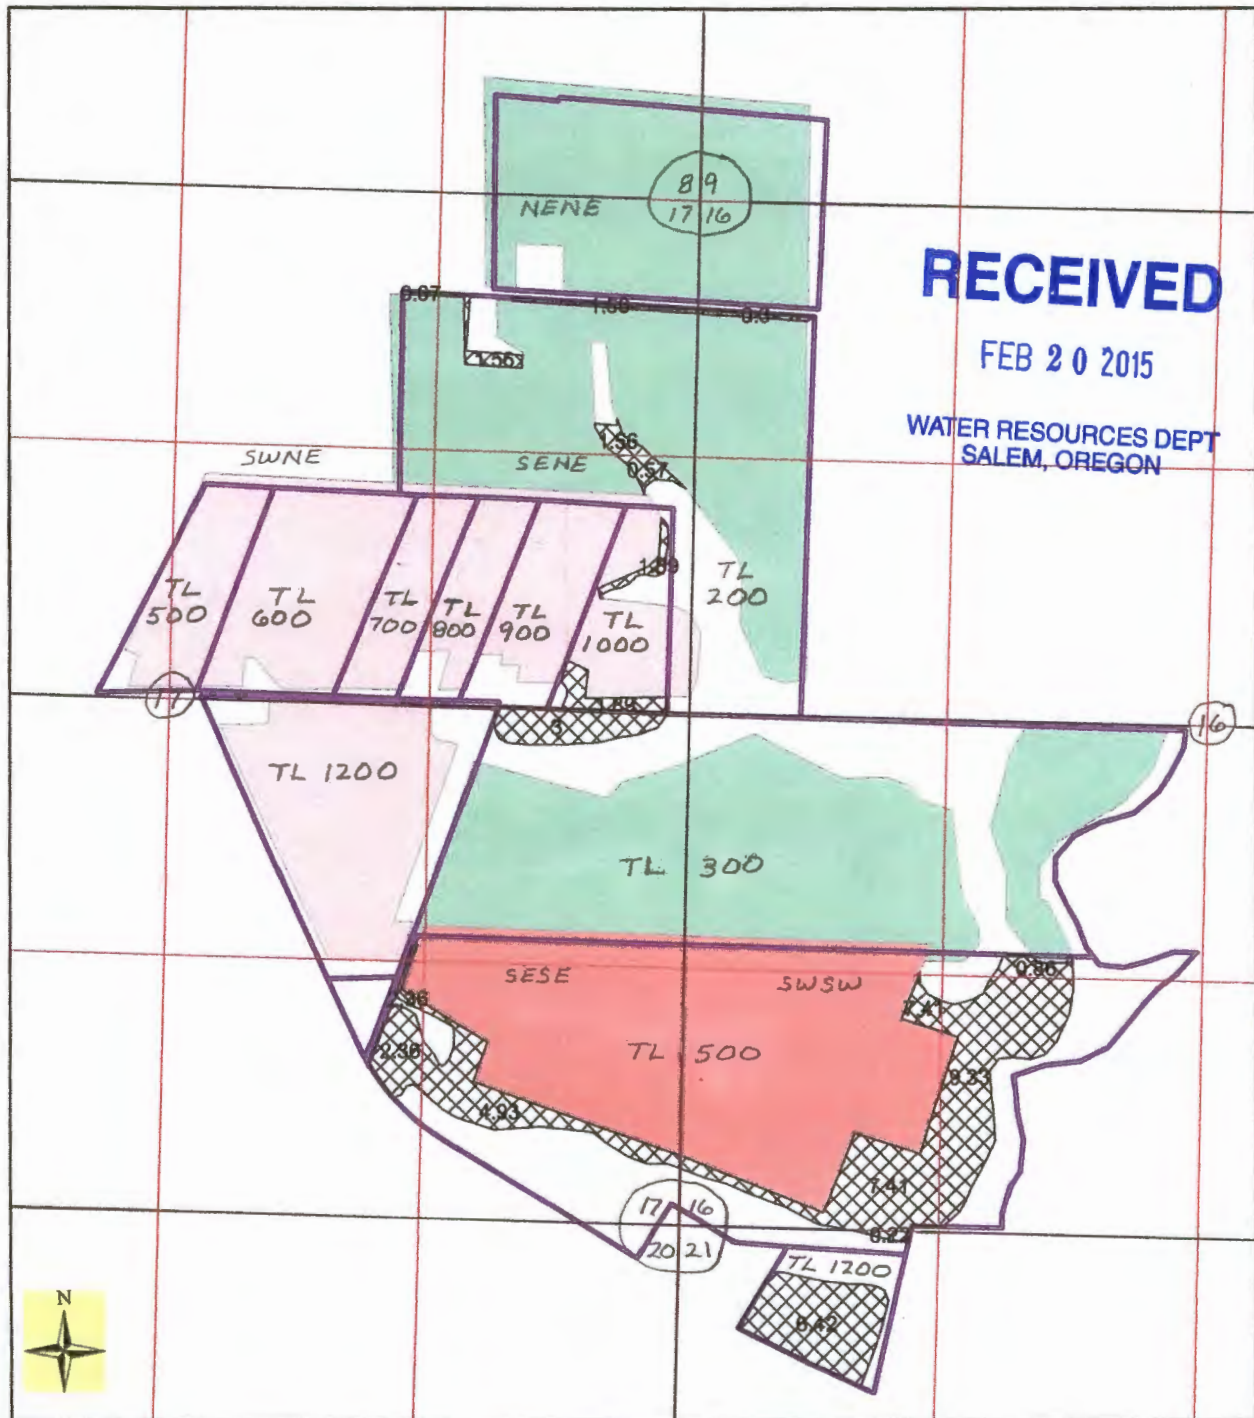

G-18003