

G-16006

Diamond west LLC


GROUND WATER APPLICATION MAP


This map is for the purpose of identifying the water right location only and is not intended to provide legal dimensions or location of property ownership lines

LEGEND

- Well
- Pivot Center
- Scale 4 in = 1 mile
- Primary

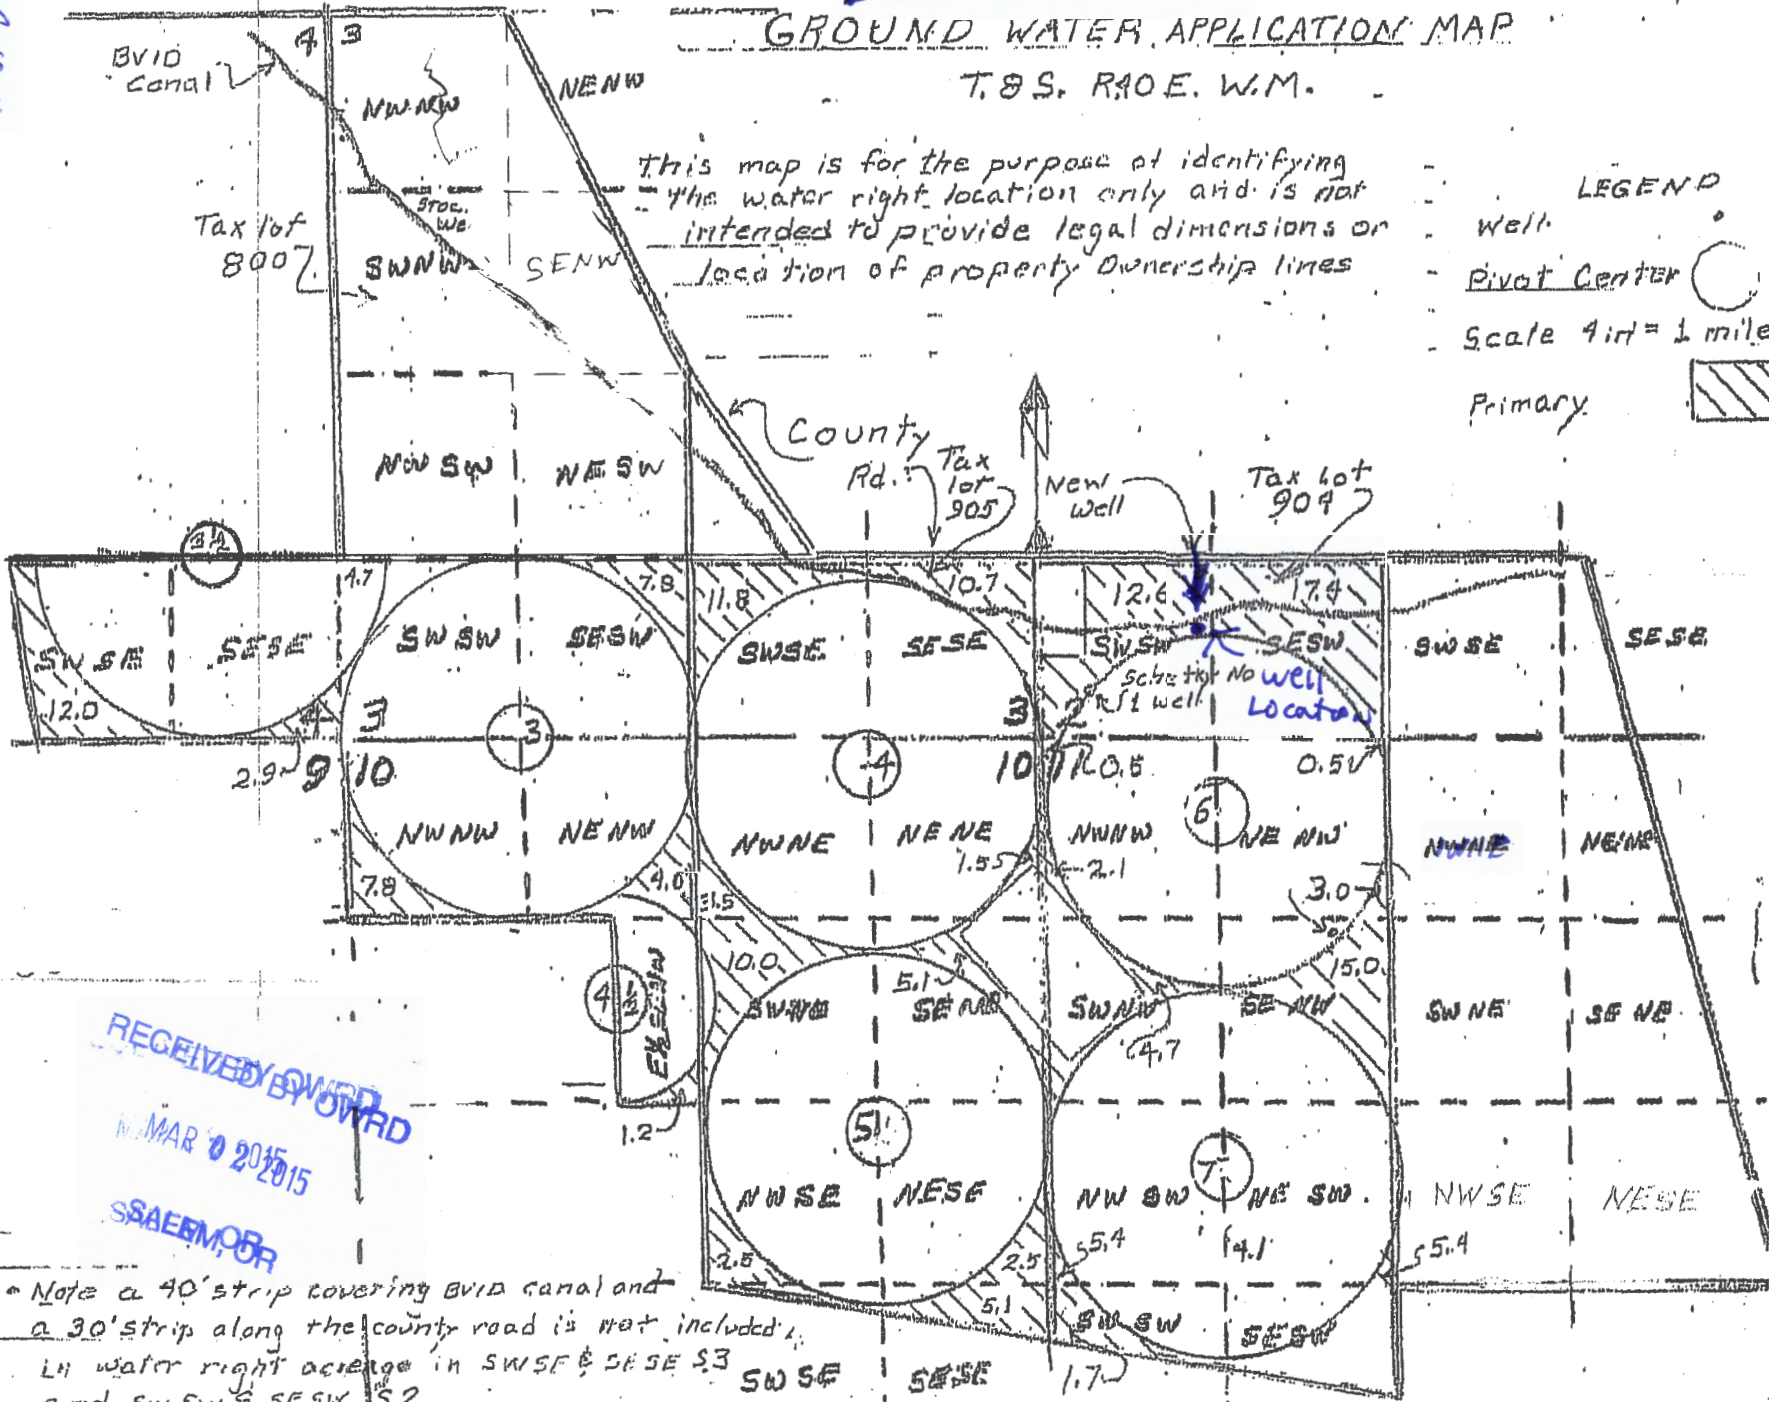

RECEIVED BY OWRD

MAR 0 2015

SSAEBM/DR

Note a 40' strip covering BVID canal and a 30' strip along the county road is not included.
 LH water right acreage in SWSE & SESE §3 and SW SW & SE SW §2

G-10005

Diamond west LLC


GROUND WATER APPLICATION MAP

T. 8 S. R. 40 E. W.M.

This map is for the purpose of identifying the water right location only and is not intended to provide legal dimensions or location of property ownership lines

LEGEND

- Well
- Pivot Center
- Primary

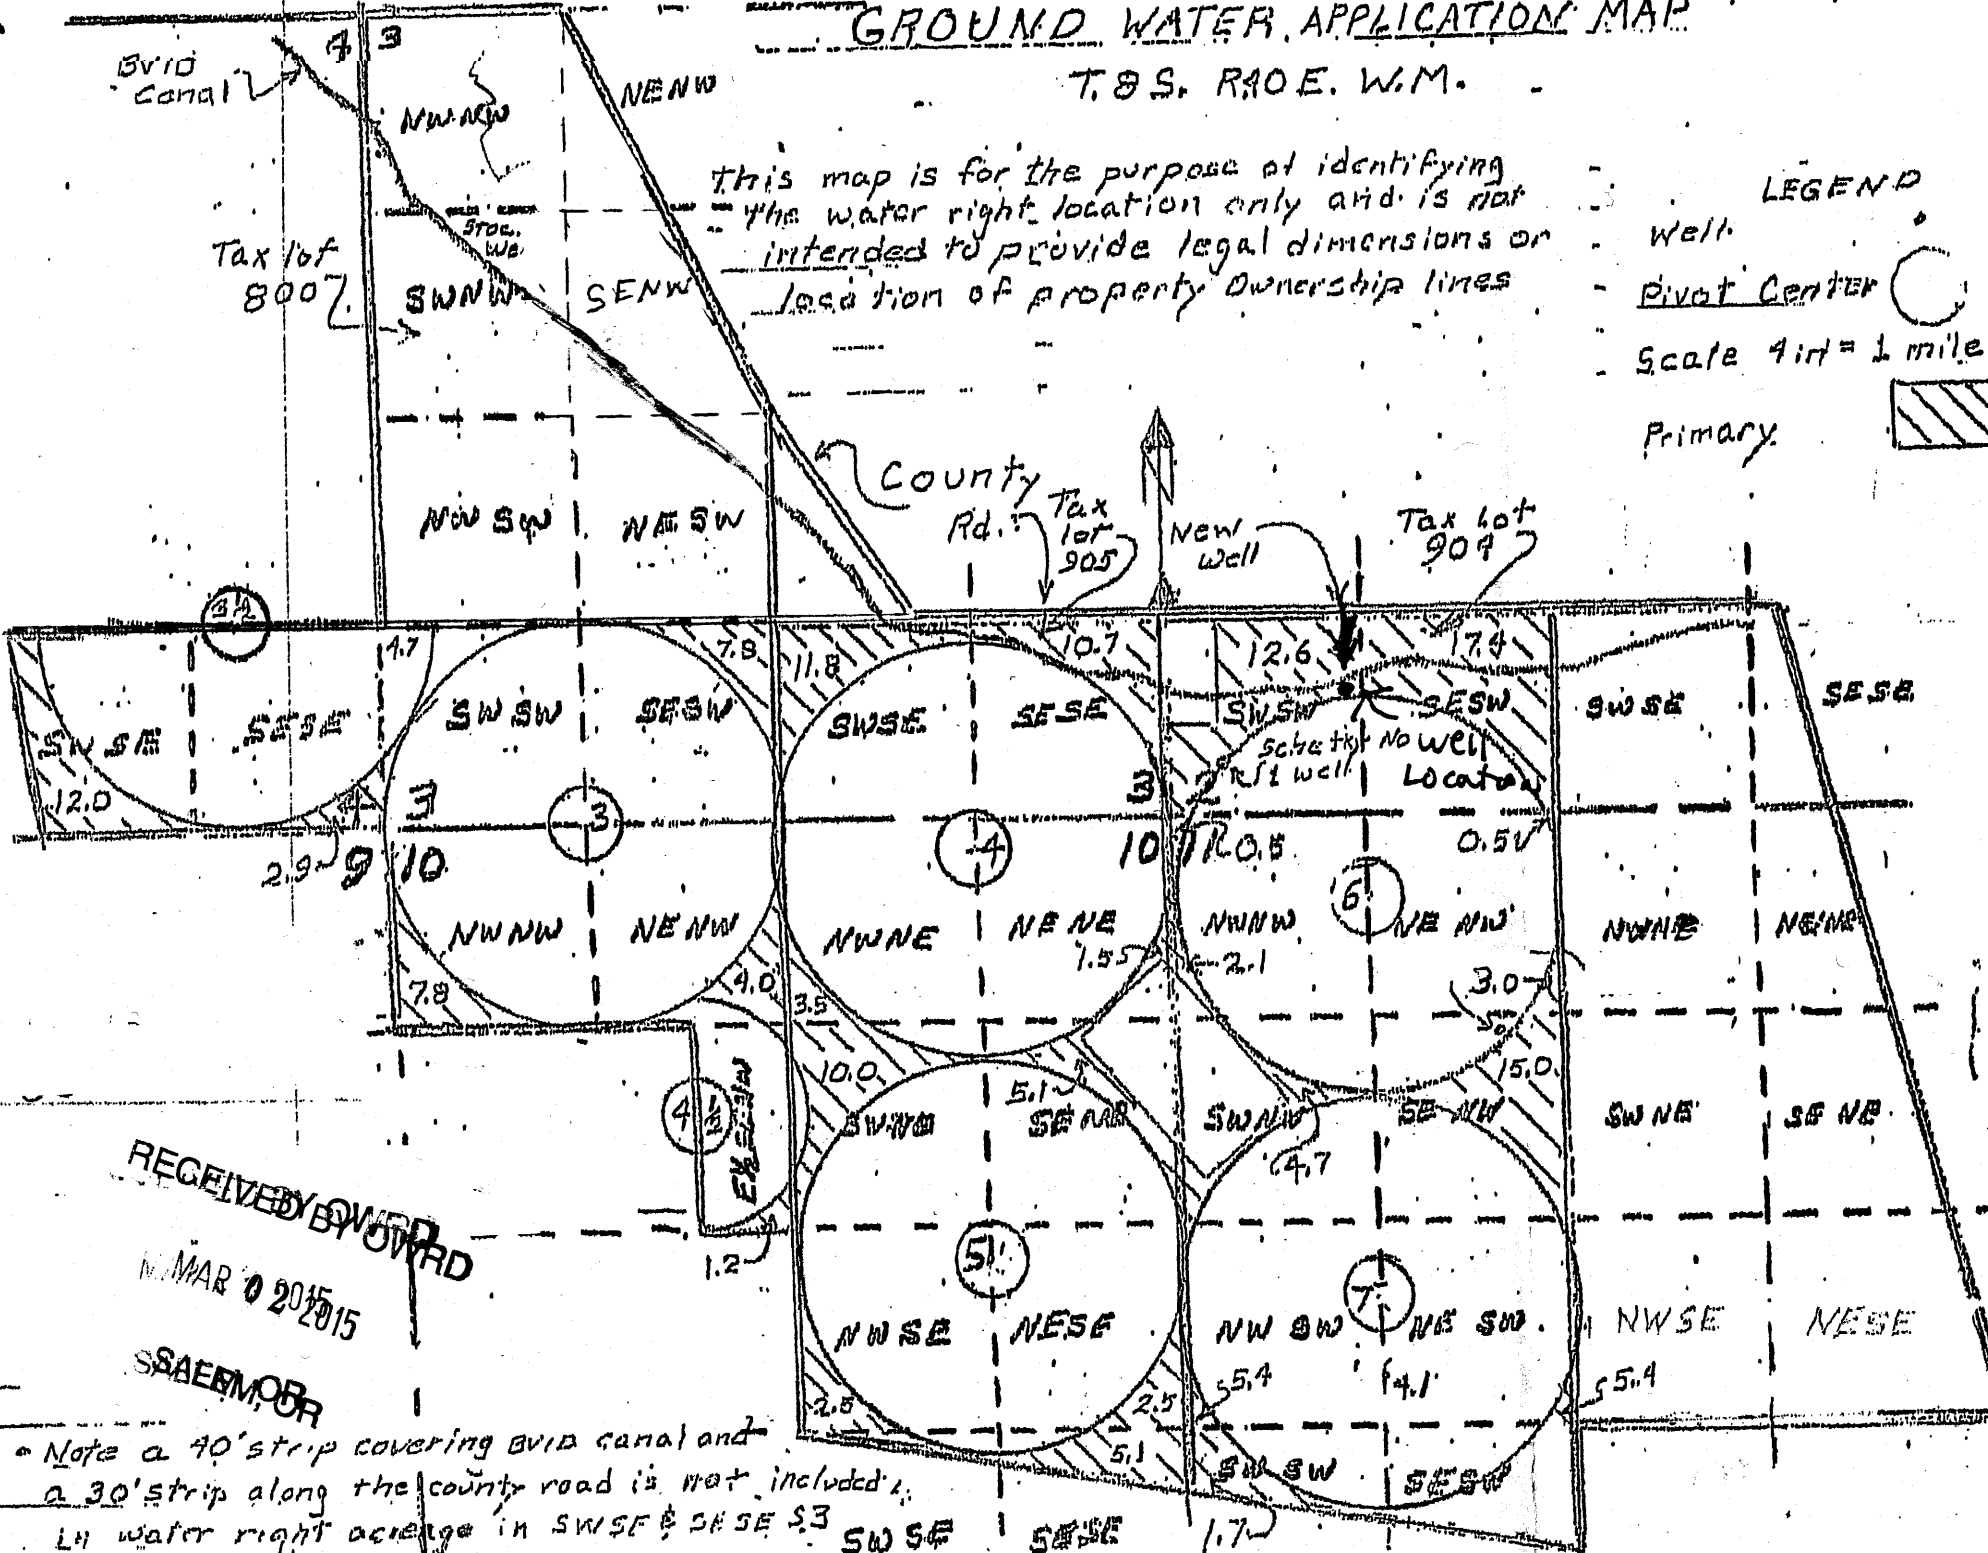

RECEIVED

MAR 12 2015

WATER RESOURCES DEPT
SALEM, OREGON

NEW WELL LOCATED
1320' East & 875' North
OF THE SW CORNER OF
SECTION 2 OF
T8S, R40E

WORKING MAP

RECEIVED BY OWRD

MAR 10 2015

SALEM, OR

Note a 40' strip covering BVID canal and
a 30' strip along the county road is not included.
LH water right acreage in SWSE & SESE S3
and SW SW & SE SW S2