

Reference Parcel #: 51E05 01903




This map was prepared for
assessment purpose only.

CLACKAMAS COUNTY

1" = 400'

SEE MAP 4 IE 32

TL
2003
ADD
30742

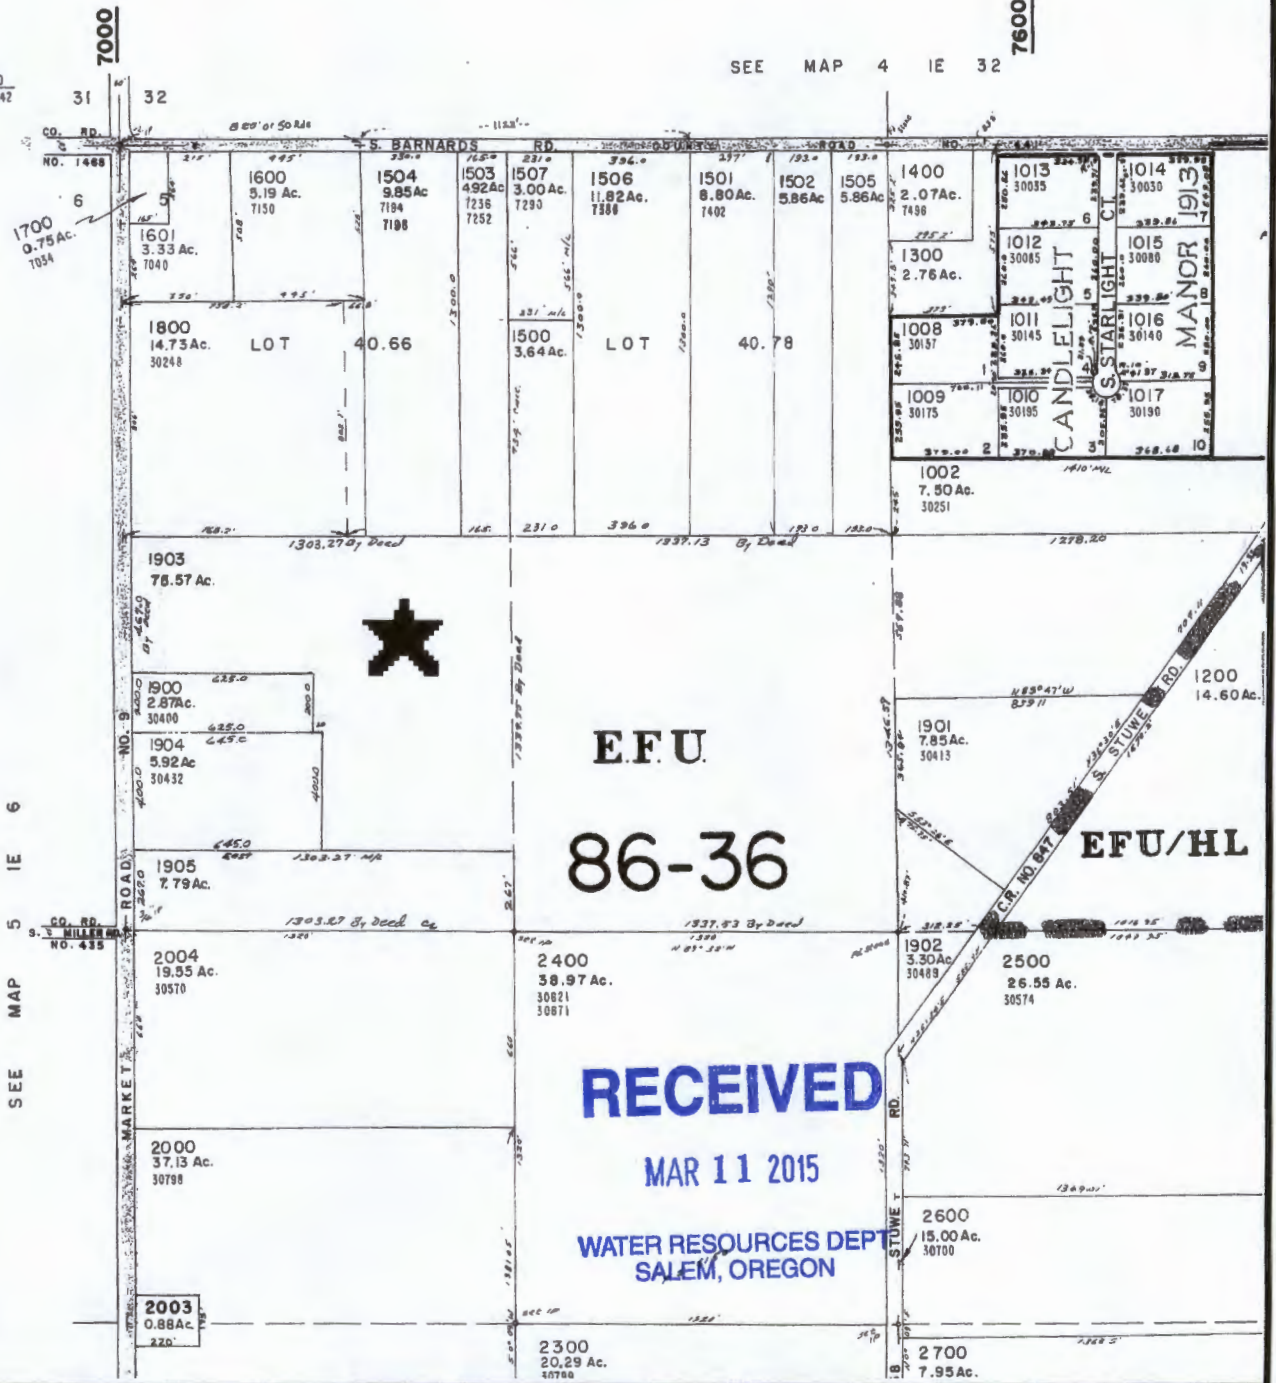


First American
Title Company of Oregon

Customer Service Department
121 SW Morrison Street Suite 300 Portland, OR 97204
Phone: 503.219.TRIO (8746) Fax: 503.790.7872
Email: cs.portland@firstam.com

G-18012

THIS MAP IS PROVIDED AS A CONVENIENCE IN LOCATING PROPERTY. FIRST AMERICAN TITLE COMPANY OF OREGON ASSUMES NO LIABILITY FOR ANY VARIATIONS AS MAY BE DISCLOSED BY AN ACTUAL SURVEY

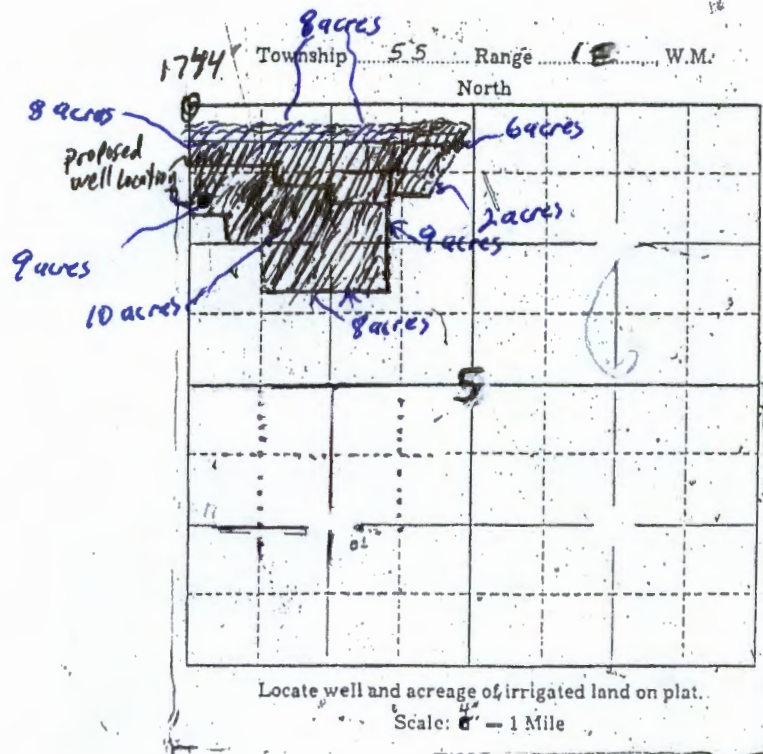


1744' From NW corner to south to well

RECEIVED

MAR 11 2015

WATER RESOURCES DEPT
SALEM, OREGON

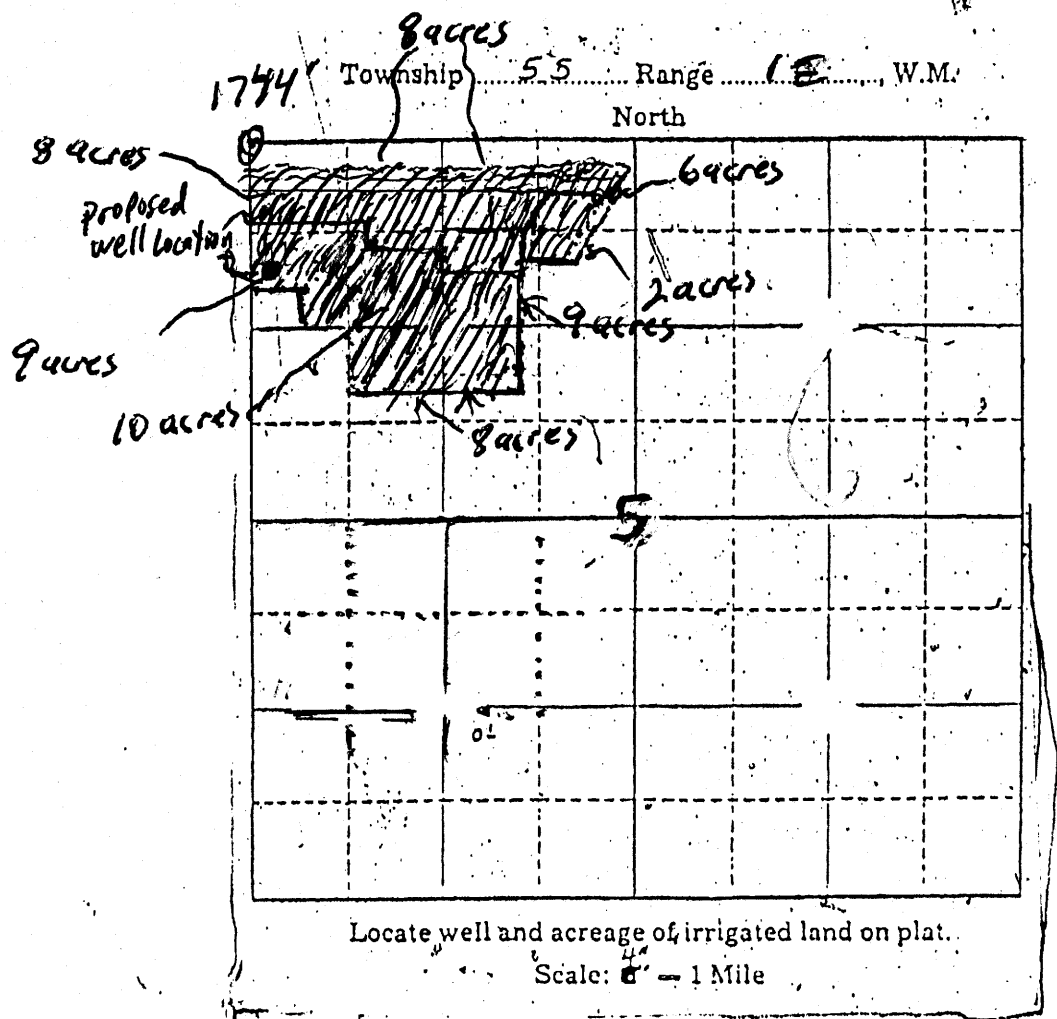

1744' From NW corner to south to well

RECEIVED

MAR 11 2015

WATER RESOURCES DEPT
SALEM, OREGON

WORKING

COPY