



T13S, R28E

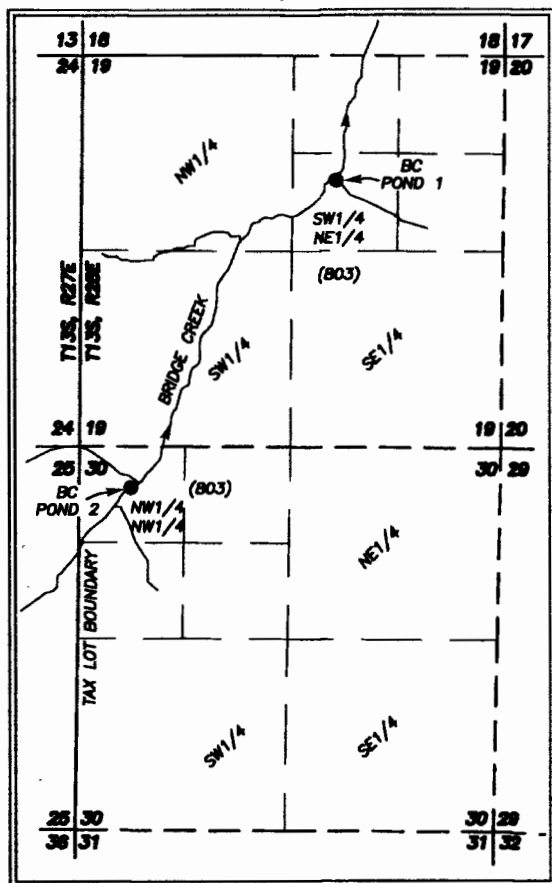

NOTE: THE PREPARATION OF THIS MAP WAS FOR THE PURPOSE OF IDENTIFYING THE LOCATION OF THE PROPOSED WATER RIGHT AND HAS NO INTENT TO PROVIDE DIMENSIONS OR LOCATION OF PROPERTY OWNERSHIP LINES.

WITH THE EXCEPTION OF THE PORTION OF THE WEST BOUNDARY LINE SHOWN HEREON, THE BOUNDARIES OF TAX LOT 803 ARE SEVERAL MILES DISTANT FROM THIS PROJECT AREA.

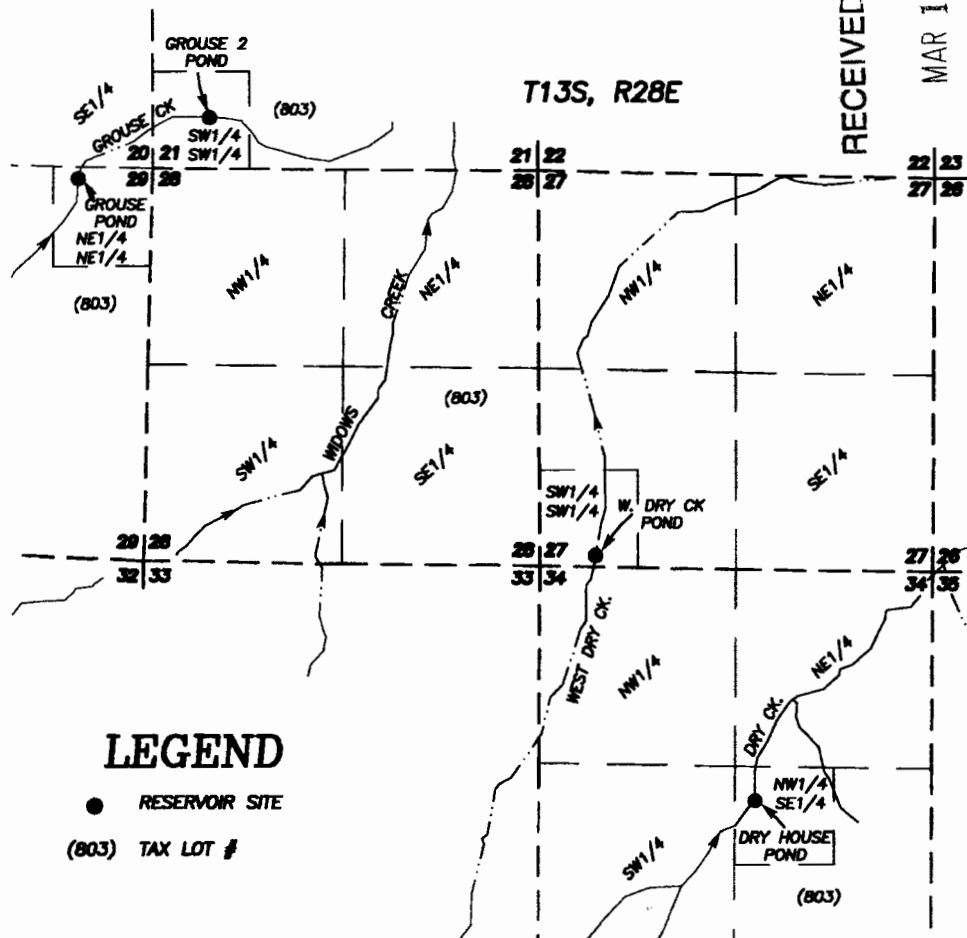

LEGEND

- RESERVOIR SITE
- (803) TAX LOT #

Grouse pond is 140 ft. South and 1010 ft. West of the NE Cor. Sec. 29;
Grouse pond 2 is 690 ft. North and 770 ft. East of the SW Cor. Sec. 21;
W. Dry Creek pond is 140 ft. North and 750 ft. East of the SW Cor. Sec. 27;
Dry House pond is 3190 ft. South and 2920 ft. East of the NW Cor. Sec. 34;
BC pond 1 is 1670 ft. South and 2290 ft. West of the NE Cor. Sec. 19;
BC pond 2 is 560 ft. South and 690 ft. East of the NW Cor. Sec. 30.

RECEIVED BY OWRD

MAR 16 2015

SALEM, OR



SCALE: 1" = 2000'

RESERVOIR APPLICATION MAP FOR WIDOWS CREEK RANCH, LLC

PREPARED BY
MICHAEL C. SPRINGER, CWRE
BENCHMARK LAND SURVEYING
217 N. CANYON BLVD.
JOHN DAY, OREGON
(541) 575-1251

SEPTEMBER 11, 2013




MAR 02 2015

SALEM, OR

12-2806

Bridge Creek #1 Reservoir

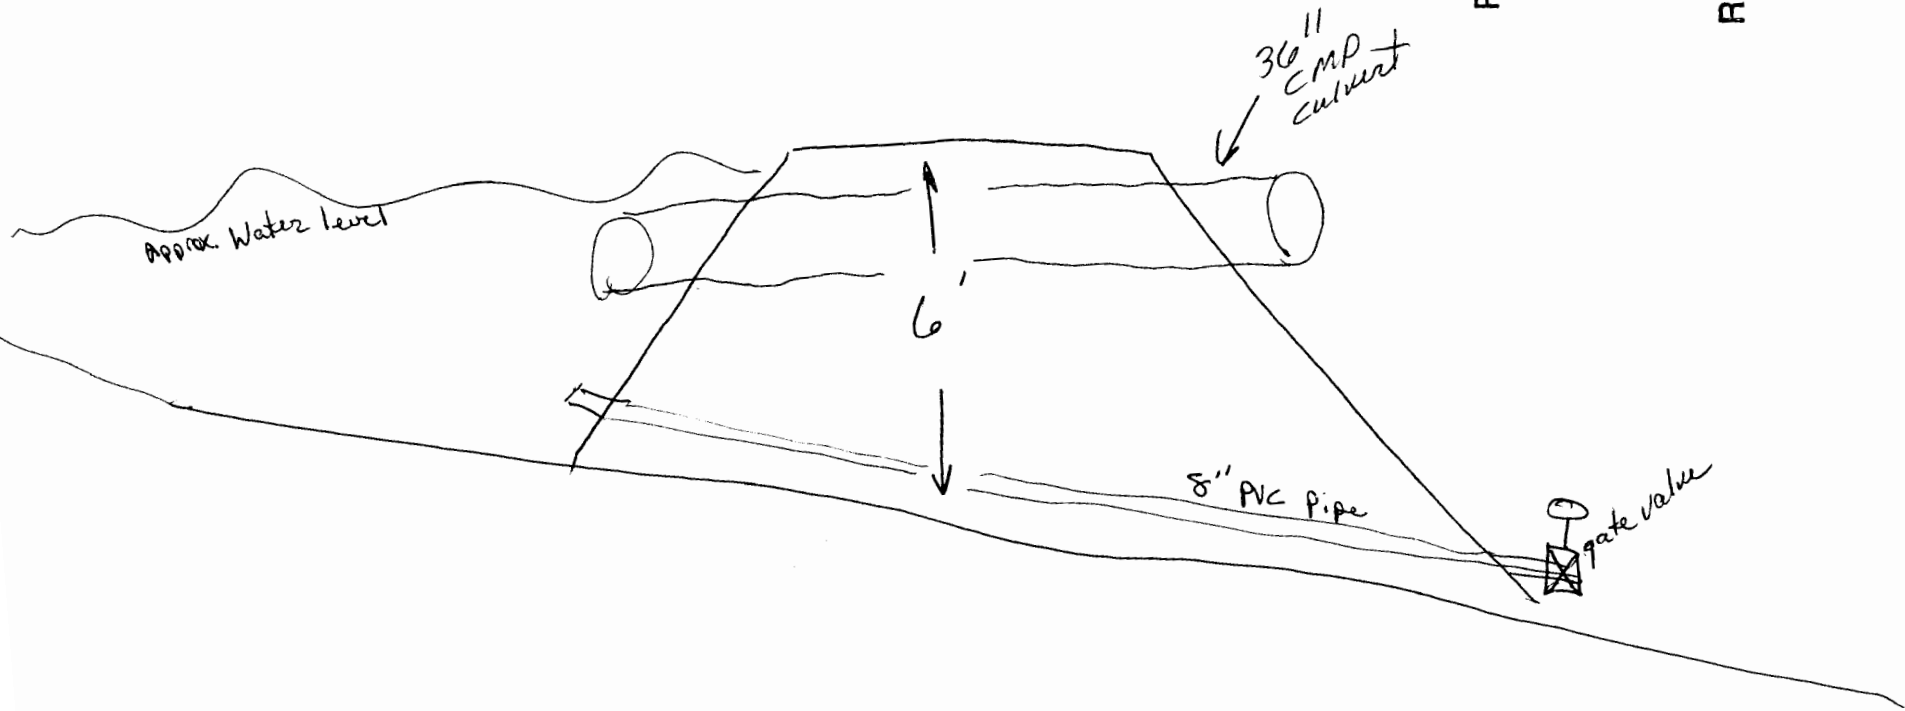

RECEIVED BY OWRD

MAR 16 2015

SALEM, OR


RECEIVED BY OWRD

MAR 02 2015

SALEM, OR


Bridge Creek #1

Reservoir

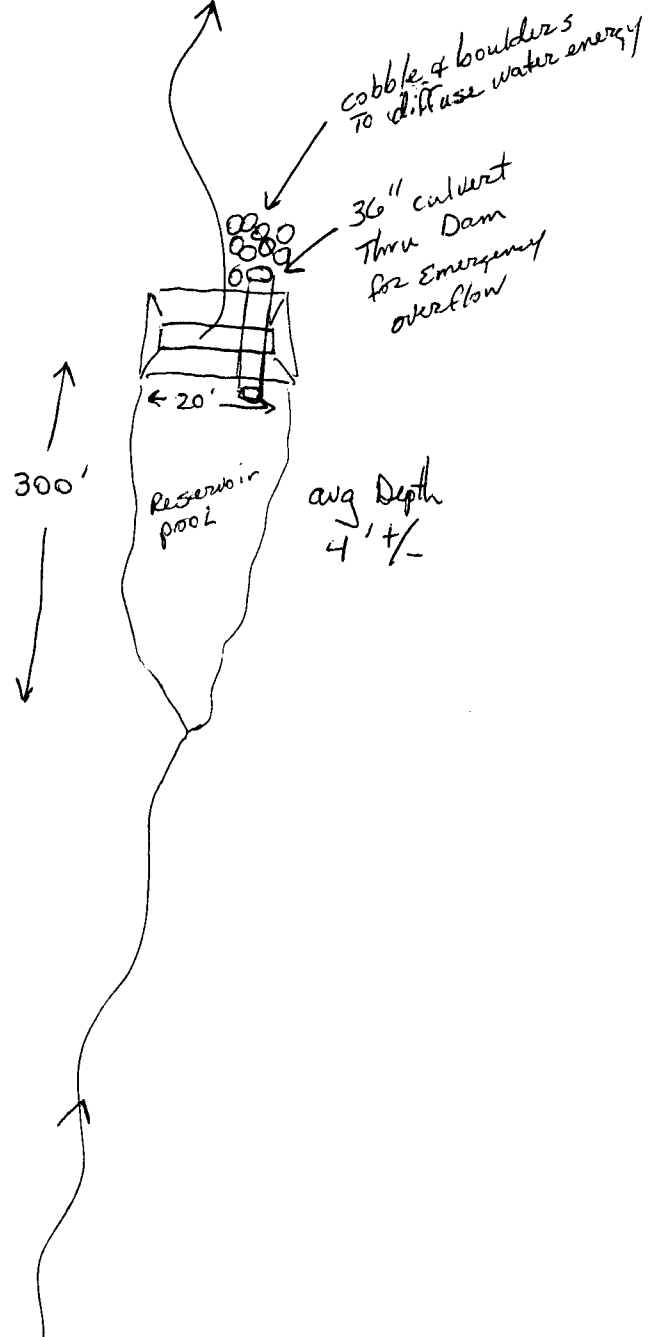

Bridge Creek #2 Reservoir

R-0004

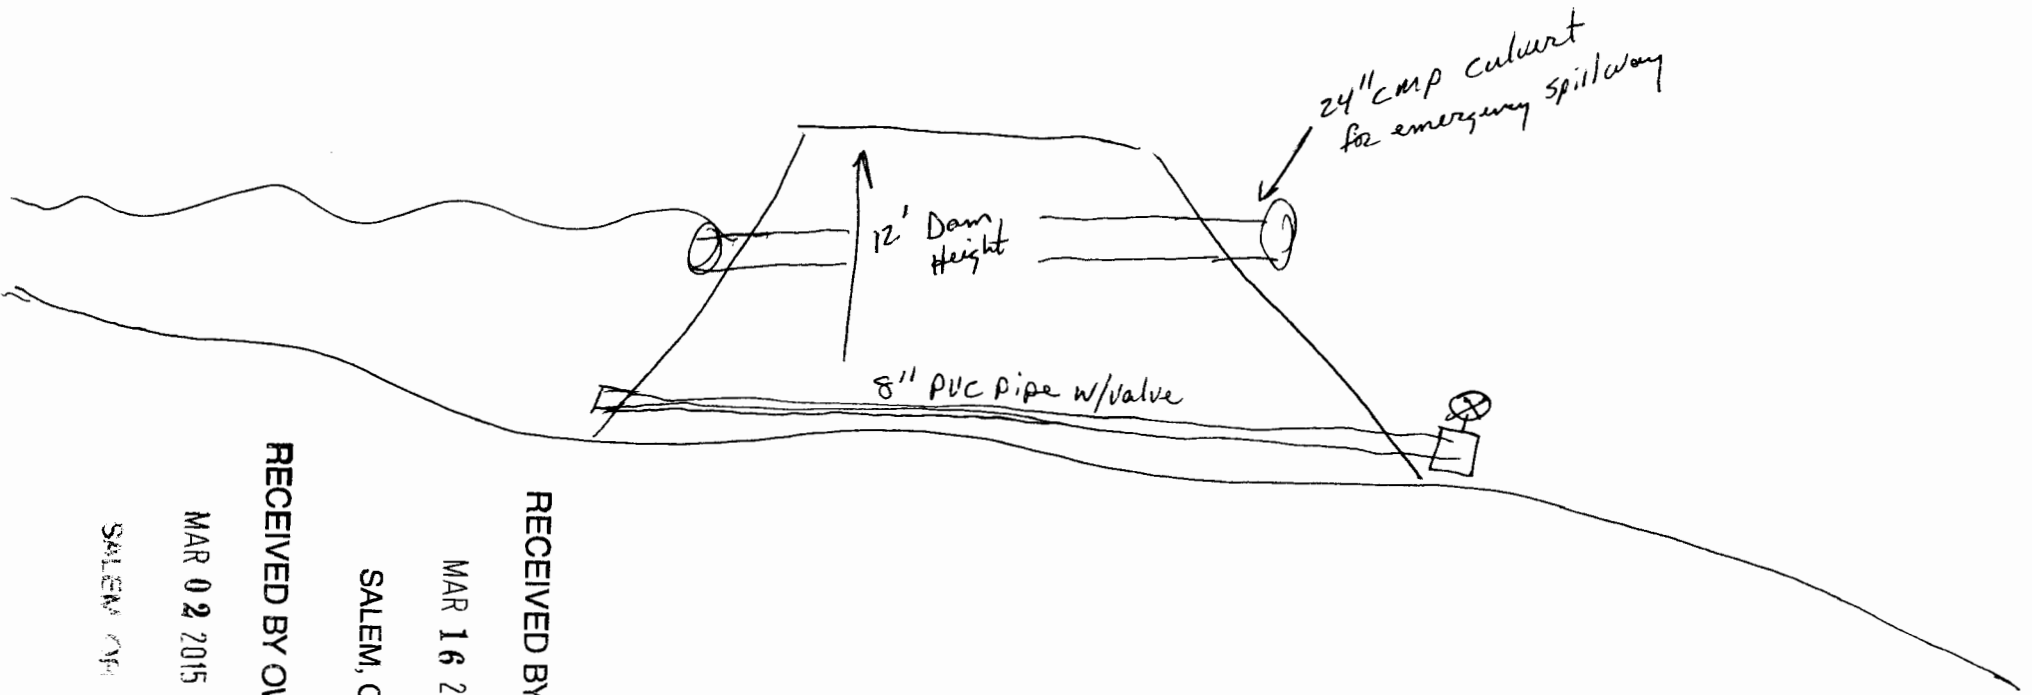

RECEIVED BY OWRD

MAR 16 2015


SALEM, OR

RECEIVED BY OWRD

MAR 02 2015


SALEM, OR

Bridge Creek # 2 Reservoir

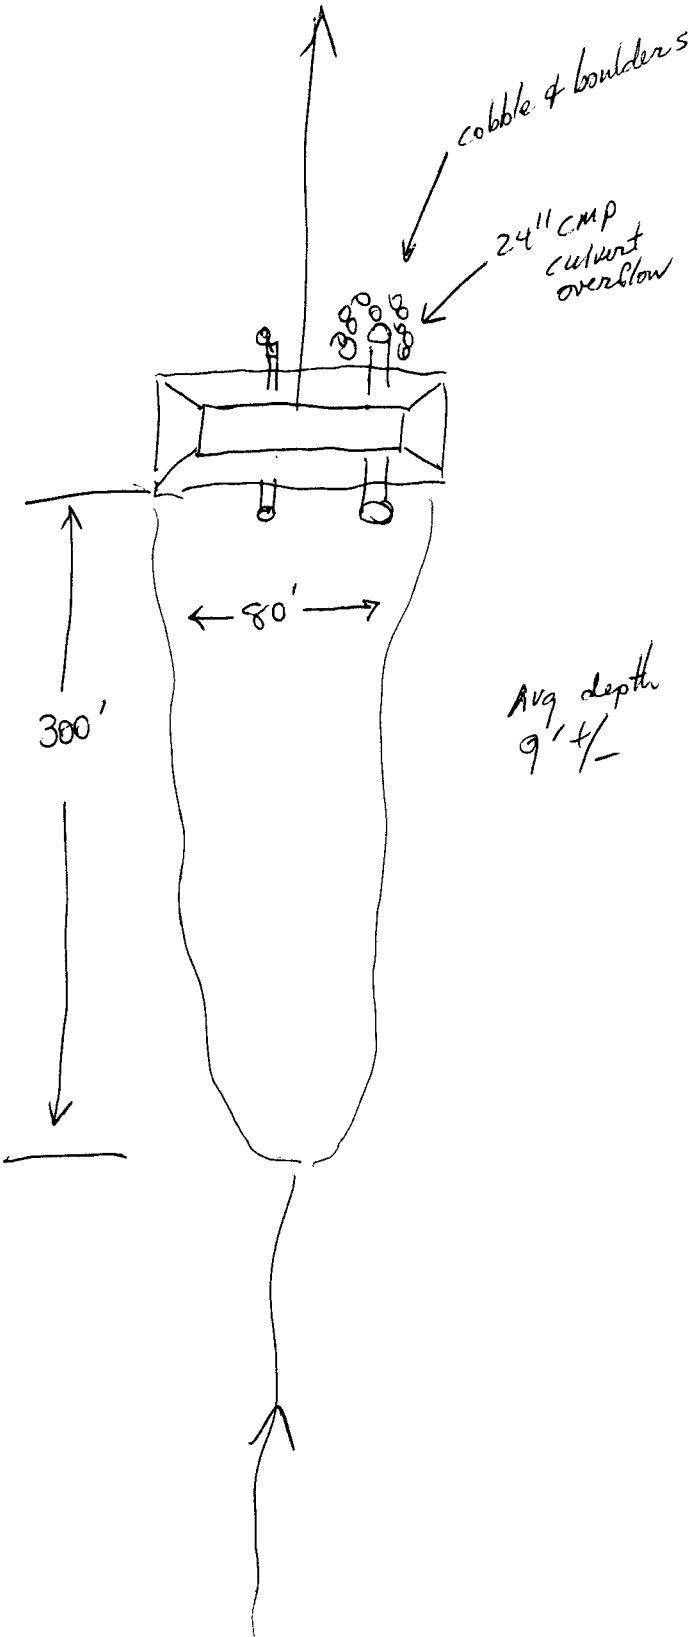

Grouse Creek #1 Reservoir

P-98000

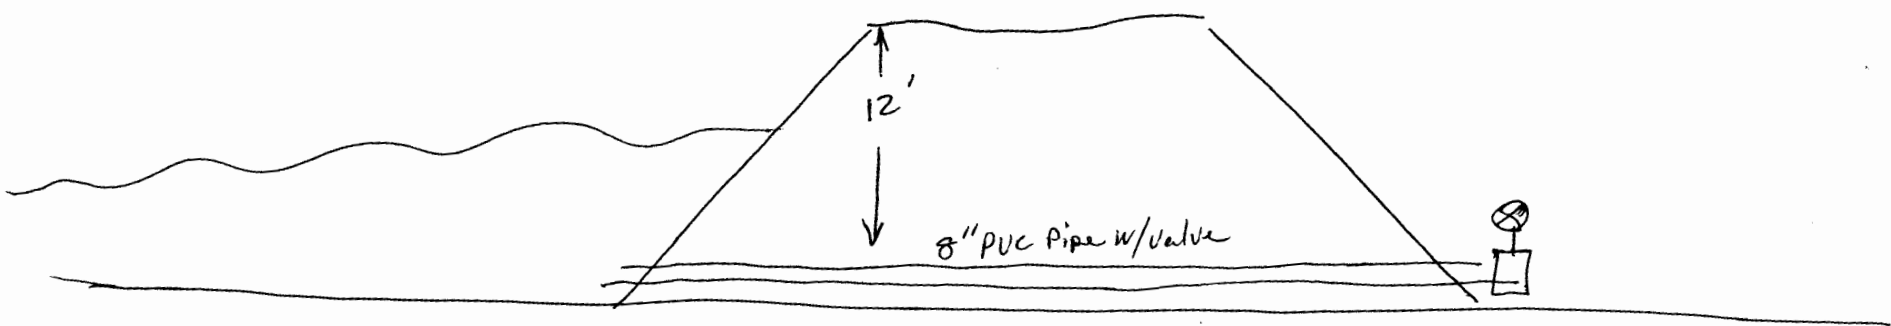

RECEIVED BY OWRD

MAR 16 2015


SALEM, OR

RECEIVED BY OWRD


MAR 02 2015

SALEM, OR

Grouse Creek #1 Reservoir

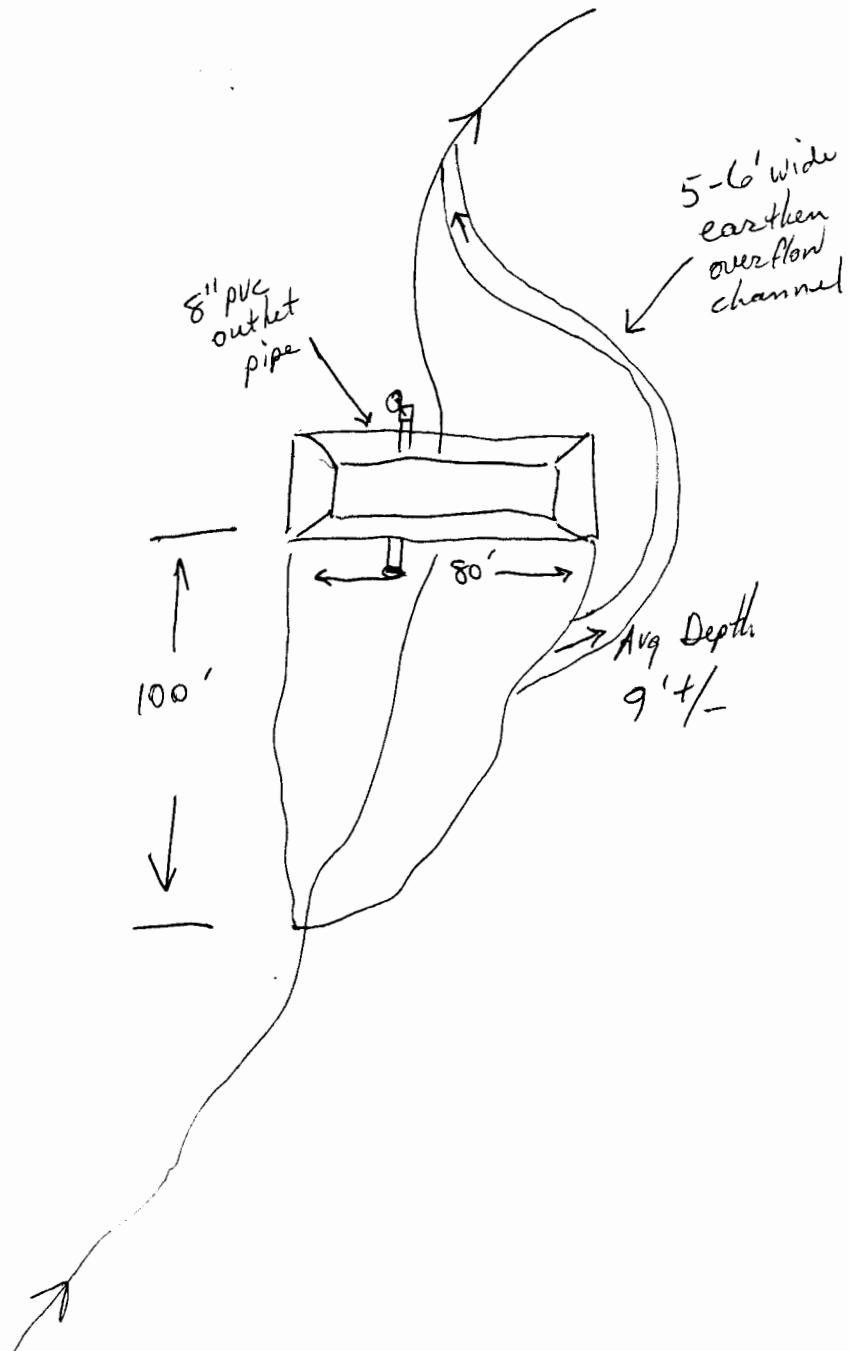

West Dry Creek

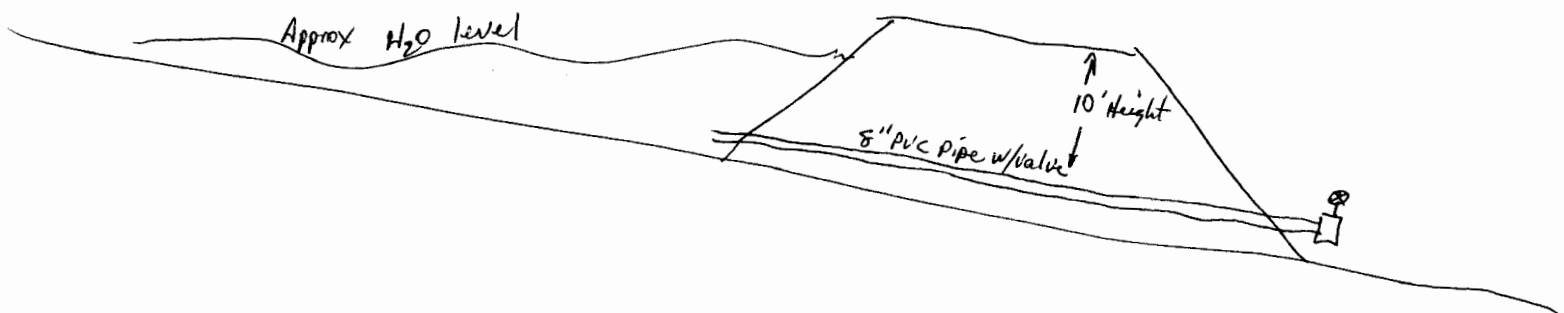

RECEIVED BY OWRD

MAR 16 2015


SALEM, OR

RECEIVED BY OWRD


MAR 02 2015

SALEM, OR

R-08061

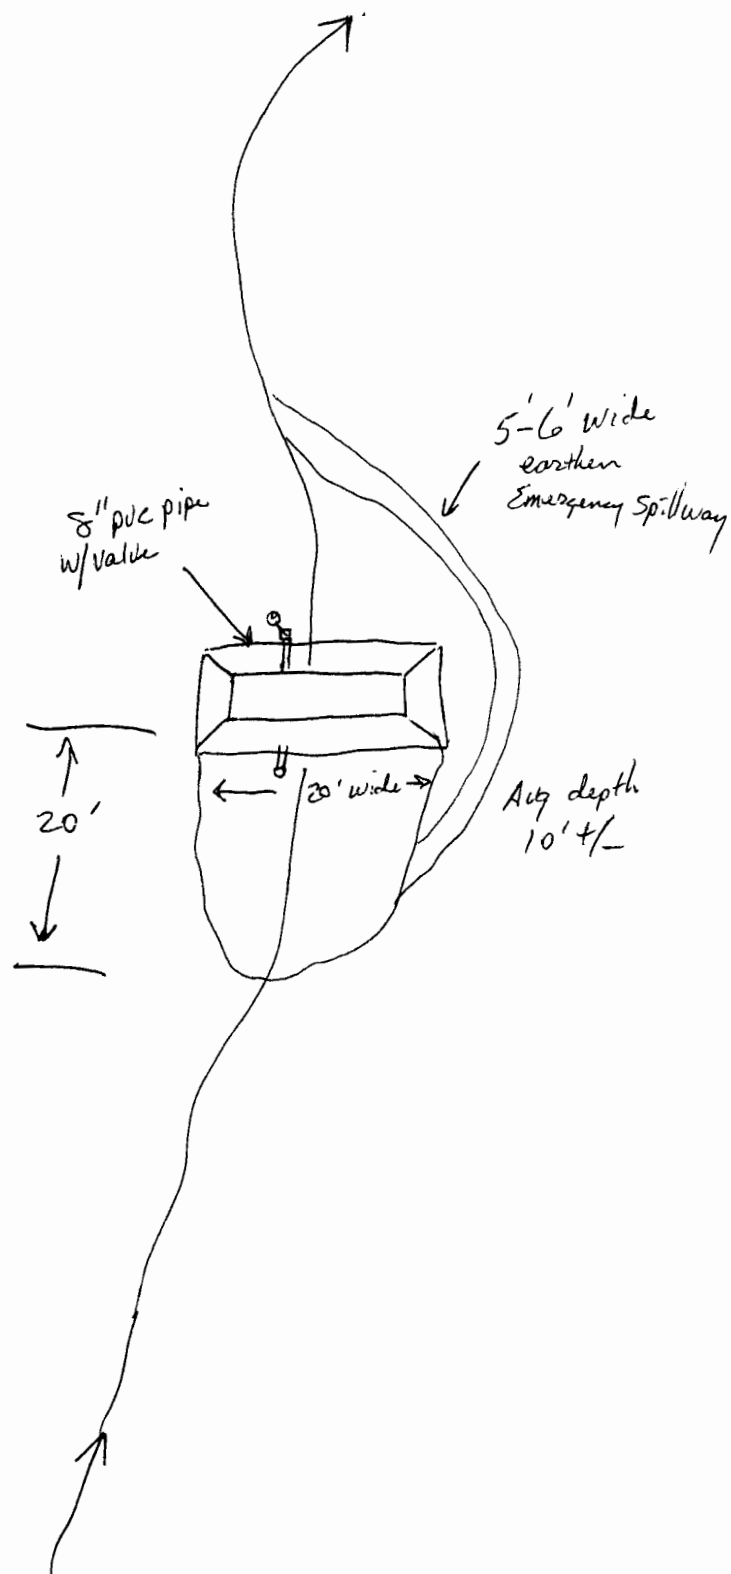

Grouse Creek #2

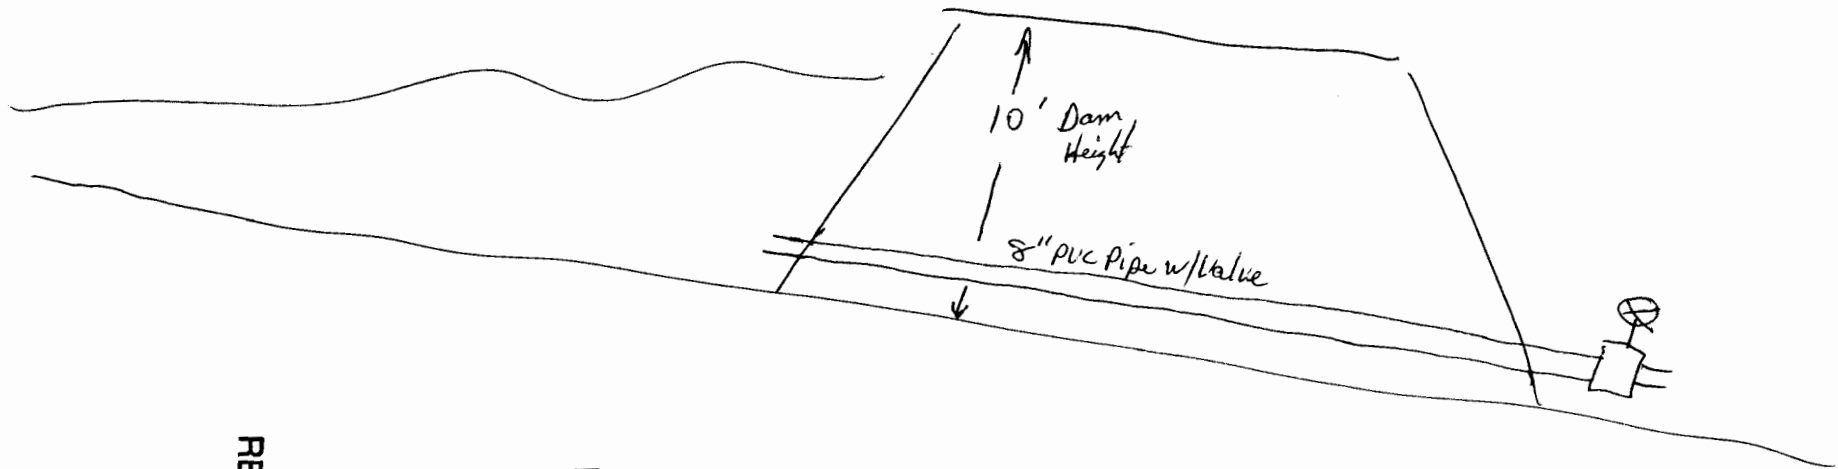

RECEIVED BY OWRD

MAR 16 2015

SALEM, OR


RECEIVED BY OWRD

MAR 02 2015

SALEM, OR


R-8804

Grouse Creek #2

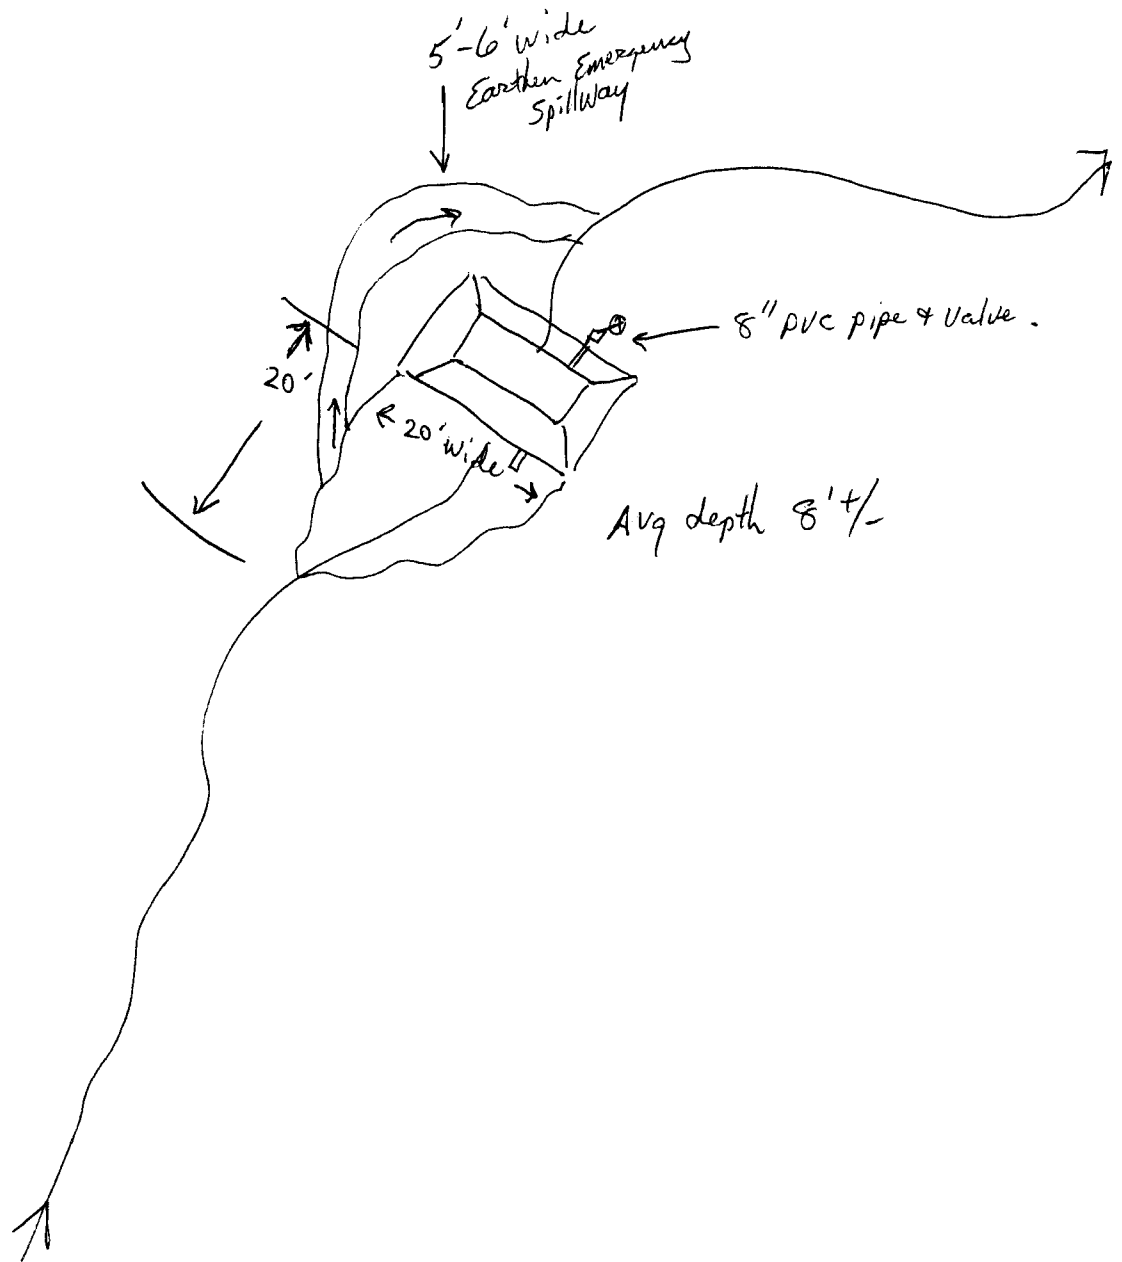

Dry Creek House Pond

R-23906

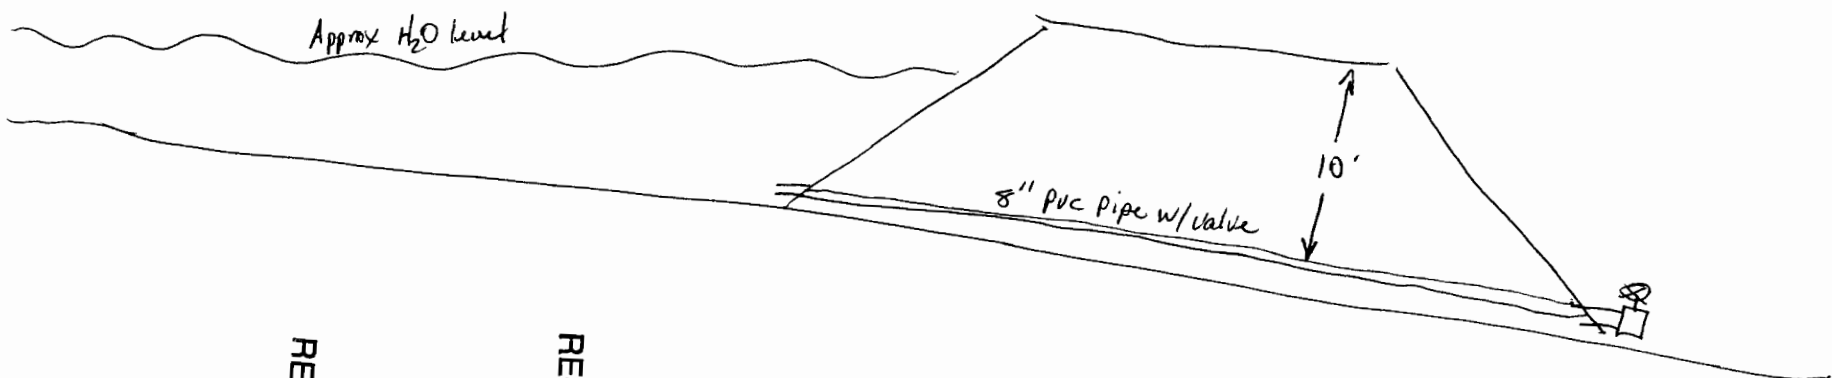

RECEIVED BY OWRD

MAR 16 2015

SALEM, OR

RECEIVED BY OWRD

MAR 02 2015

SALEM, OR

