



Lynn A Willis

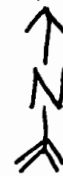

Alternate Reservoir Application Map

Township 5 South, Range 41 East, Section 34 WM, Tax Lot 4803

Scale: 1 inch = 1,320 feet

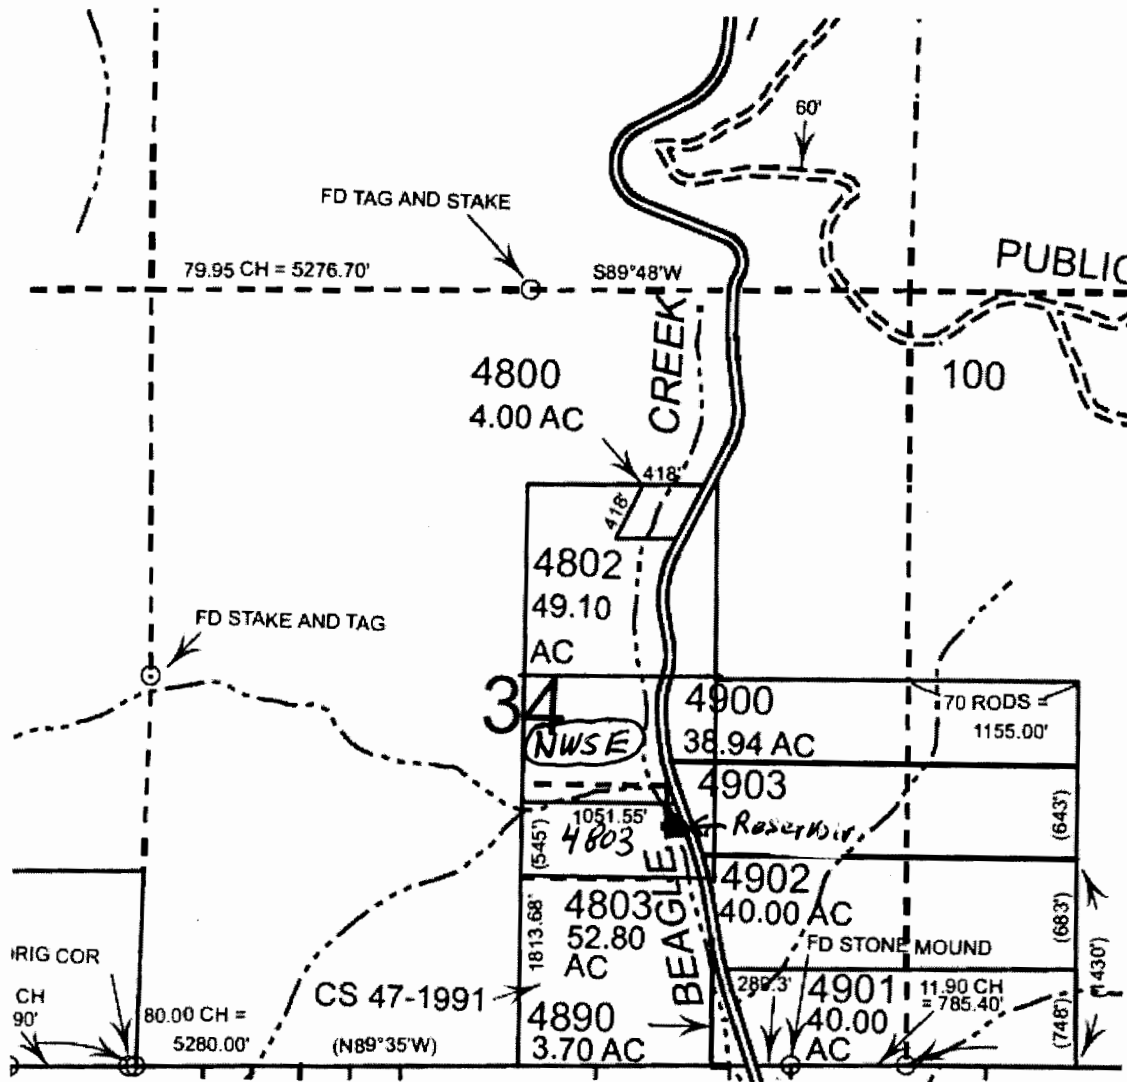


Dam Location: 1575' North and 1560' West from the Southeast Corner of Section 34. Being within the NW 1/4 SE 1/4 of Section 34.

RECEIVED BY OWRD

MAR 16 2015

SALEM, OR

R 88059

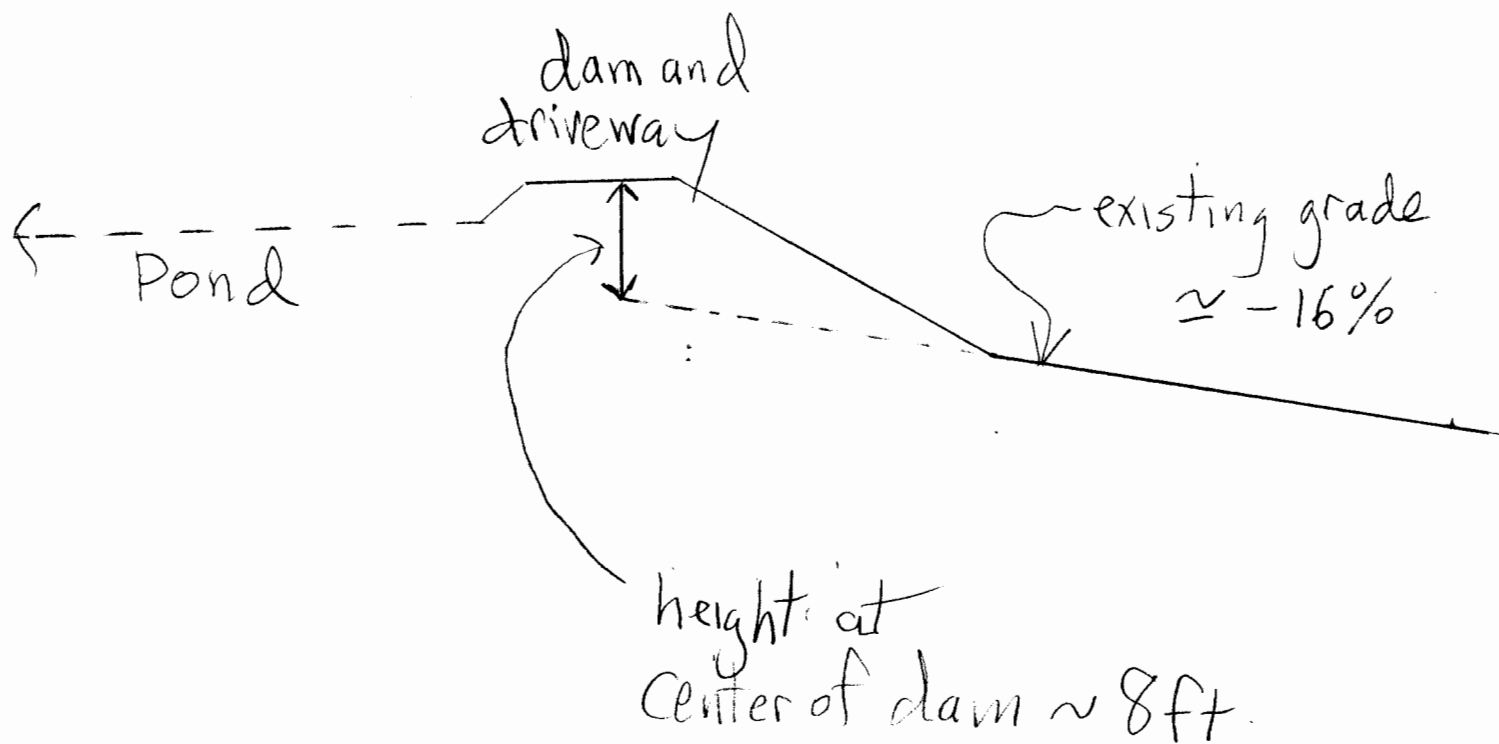

RECEIVED BY OWRD

MAR 16 2015

SALEM, OR

R-88009

