



MAP TO ACCOMPANY CLAIM OF BENEFICIAL USE FOR TRANSFER T-8277

LOCATED IN SECTION 13
TOWNSHIP 27 SOUTH, RANGE 15 EAST, W.M.
AND IN SECTION 6
TOWNSHIP 27 SOUTH, RANGE 16 EAST, W.M.
LAKE COUNTY, OREGON

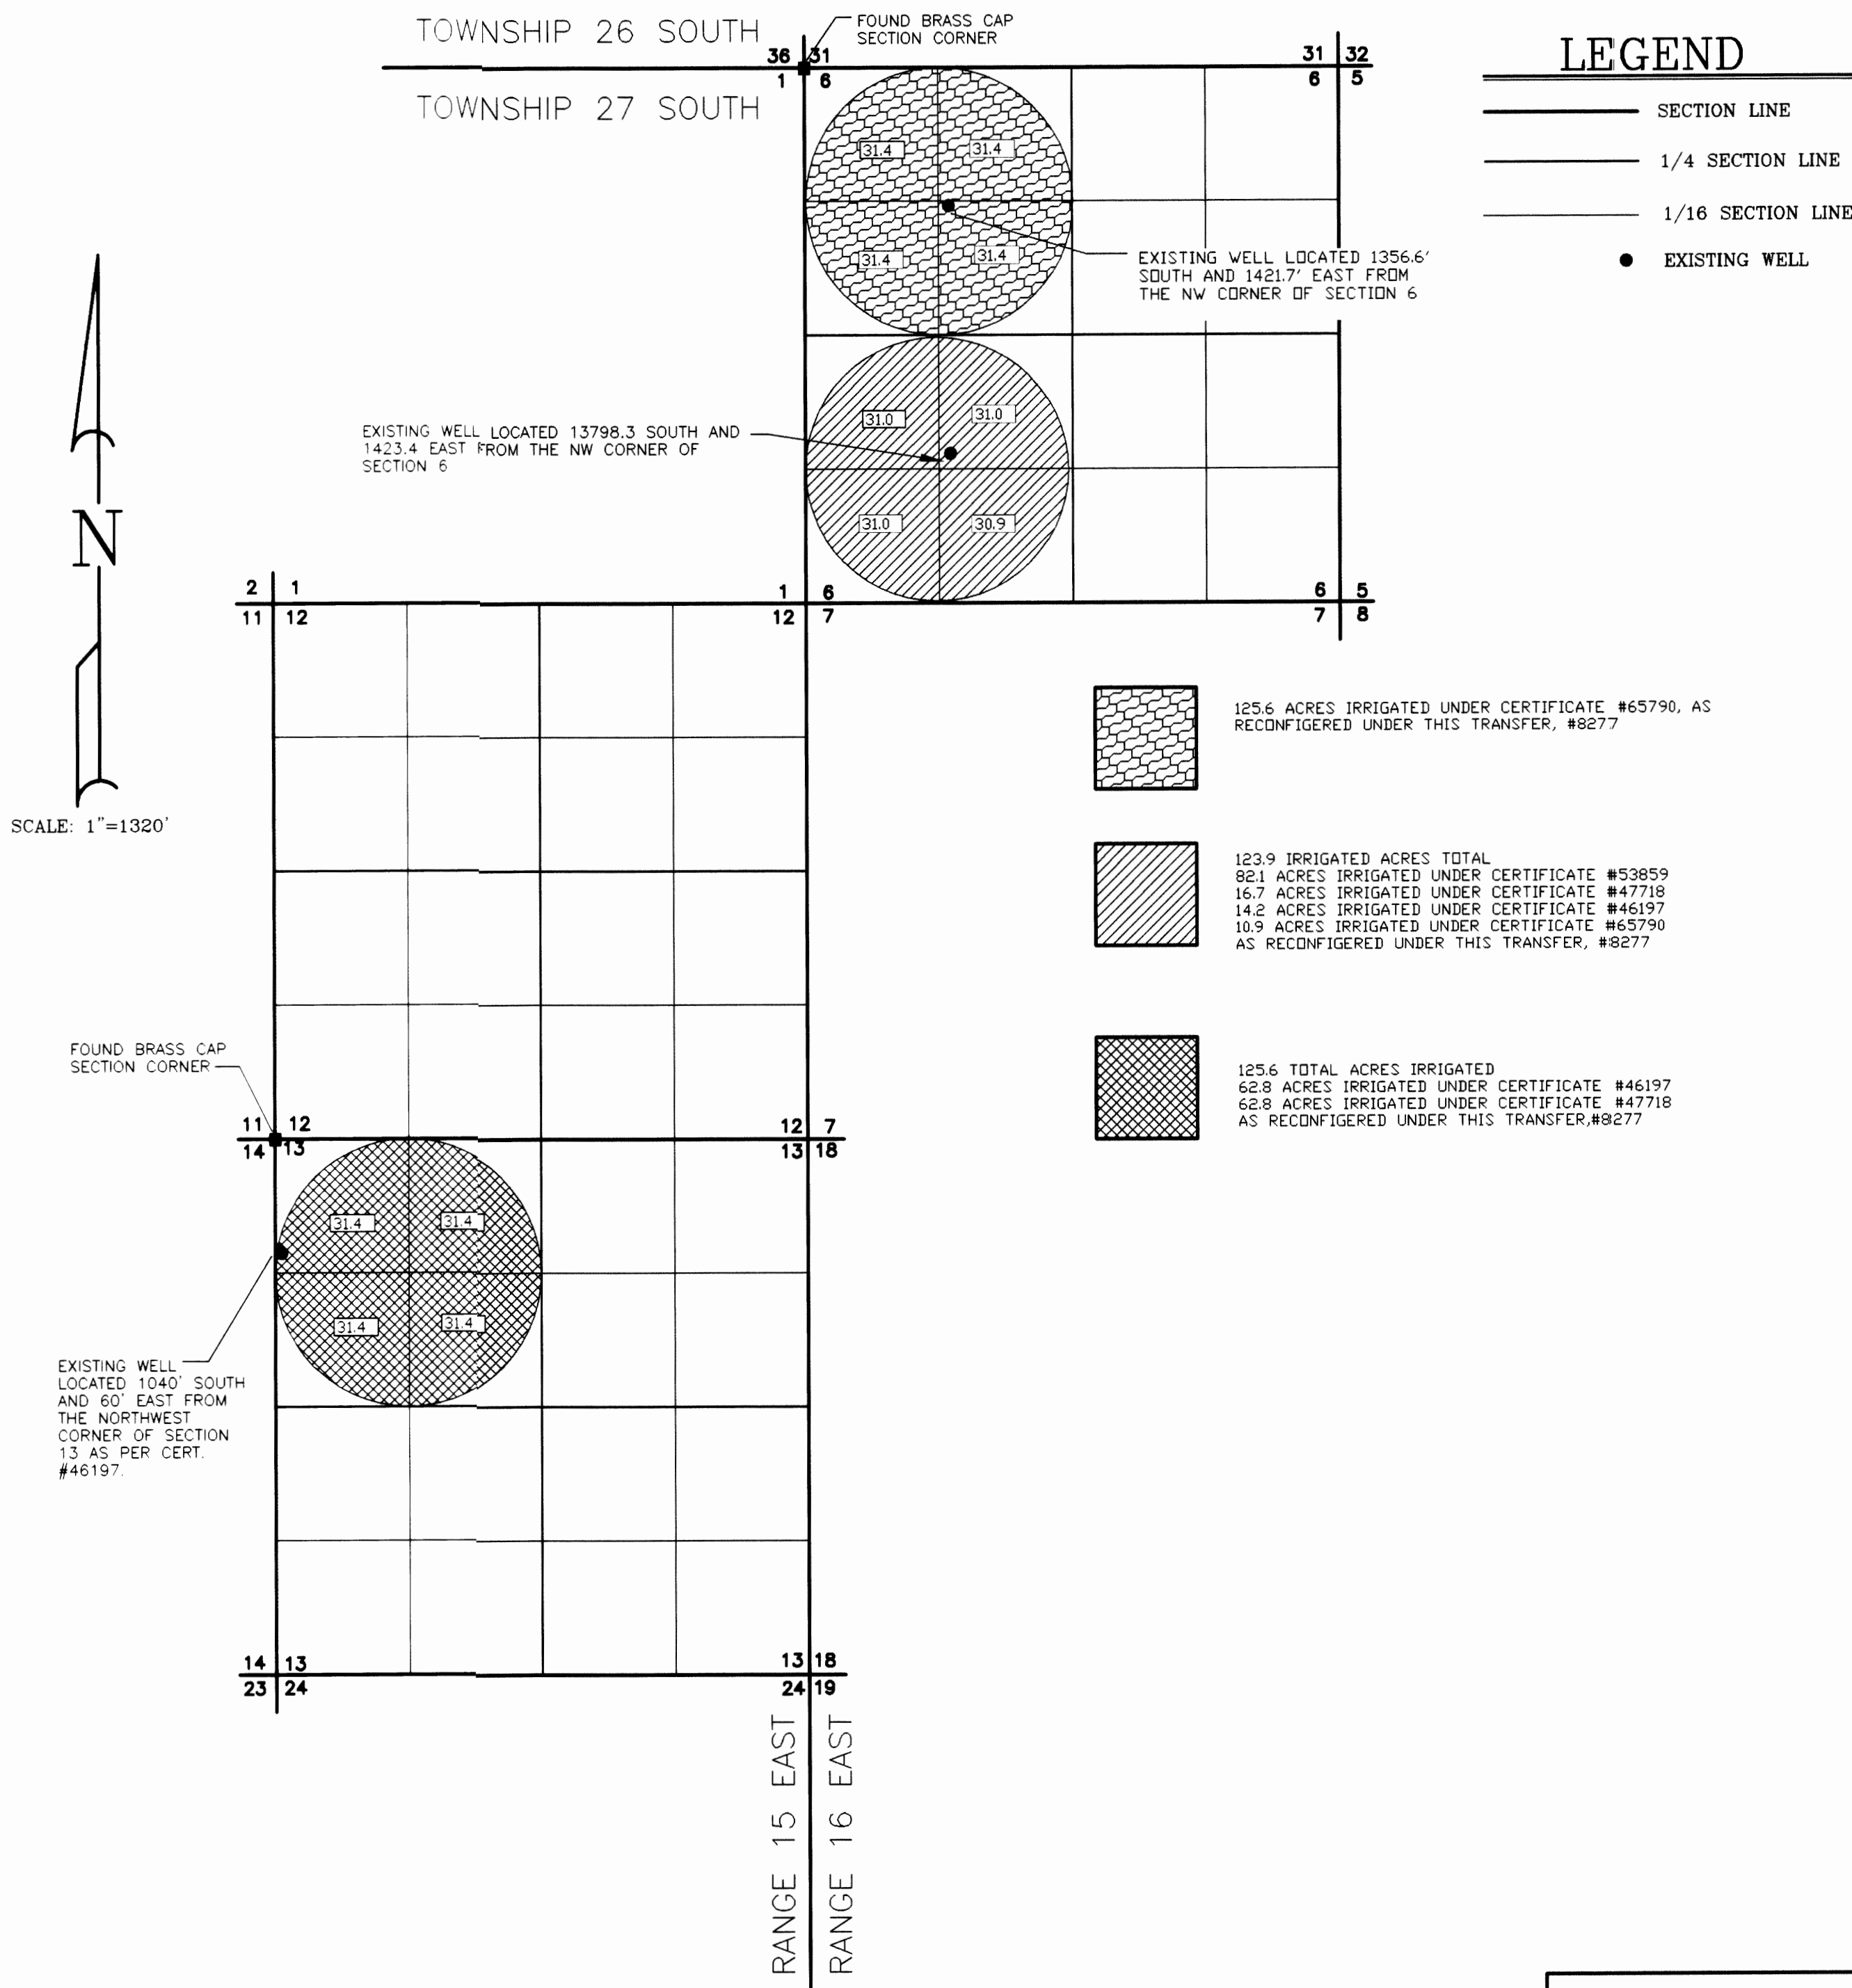

NOTE: PREPARATION OF THIS MAP IS FOR IDENTIFYING PROPOSED WATER RIGHTS ONLY. IT HAS NO INTENT TO PROVIDE LOCATIONS OR DIMENSIONS OF PROPERTY BOUNDARIES.

COBU MAP # 0112

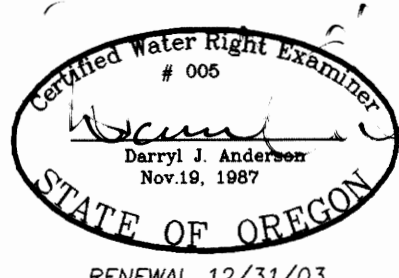

PREPARED FOR: SAM DINSDALE 57873 FORT ROCK ROAD SILVER LAKE, OR 97638	
PREPARED BY: ANDERSON ENGINEERING & SURVEYING, INC. P.O. BOX 28 LAKEVIEW, OREGON 97630 (541) 947-4407 FAX 947-2321	
P.O. BOX 419 REDMOND, OREGON 97756 (541) 923-4307 FAX 923-4308	
DATE: 11/10/03	DWG. FILE: 2003-55
JOB NO.: 2003-55	SHEET 1 OF 1