


T36S R6W Northeast Quarter Sec 3

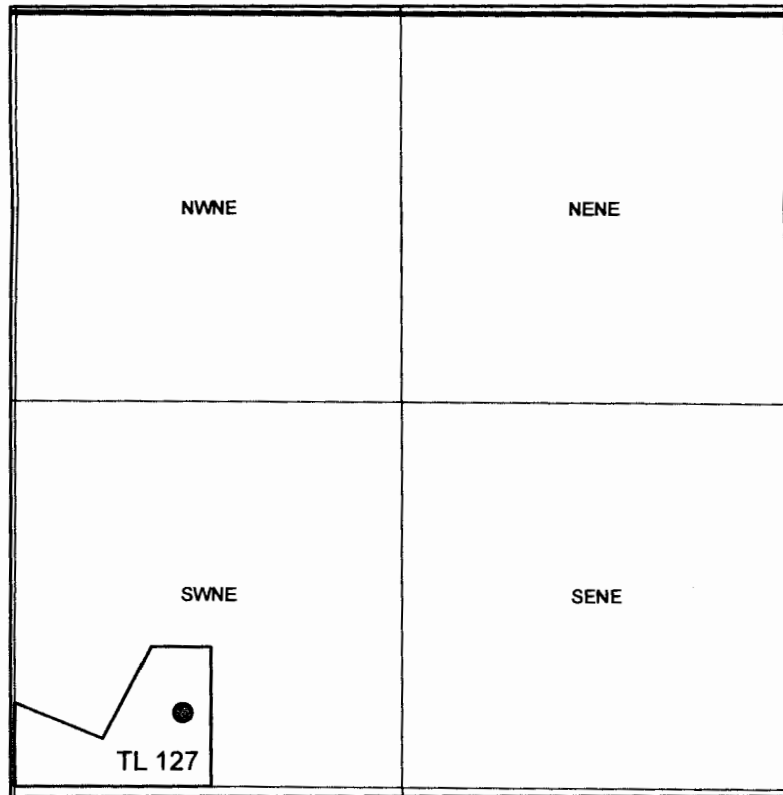

RECEIVED BY OWRD

MAR 23 2015

SALEM, OR

RECEIVED BY OWRD

MAR 23 2015

SALEM, OR

East Corner

1 inch = 660 feet

Pond is 2090 ft west and 251 ft north from east corner Section 3

R-88065