

NW1/4 NE1/4 SEC.19 T7S R2W WM, MARION COUNTY

7 2W 19AB

Cancelled	1500
	1700
	3000
	3100
	3300
	3500


LEGEND

LINE TYPES

- X LOT BOUNDARY OLD PROPERTY LINE
- VACATED RIGHT-OF-WAY
- RAILROAD RAILROAD RIGHT-OF-WAY
- STREAM, LAKE, ETC. STREAM, LAKE, ETC. NON-BOUNDARY
- PARTITION PLAT BDY.
- EASEMENT

SYMBOL TYPES


- DL.C.
- CONTROL POINTS
- SURVEY MONUMENTS
- G.L.O. CORNERS

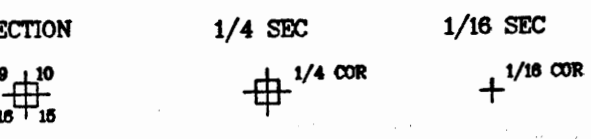

NUMBERS
TAX CODE NO.
000 00 00 0

ACREAGE - ALL ACREAGES EXCLUDE ANY PORTION THAT MAY LIE WITHIN THE INDICATED PUBLIC RIGHT OF WAYS.


TICK MARKS - WHEN A TICK MARK IS INDICATED ON THE EXTENSION OF A LINE, THEN THE DIMENSION GOES TO THE TICK MARK. GENERALLY THIS IS USED WHEN DIMENSIONS GO INTO PUBLIC RIGHT OF WAYS.

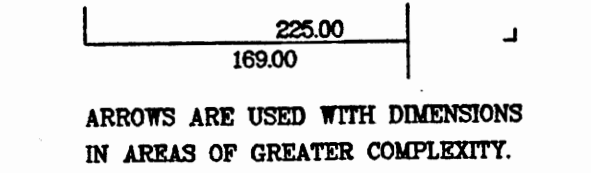

NOTICE: This map was created for Assessor's Office use ONLY.



SCALE 1" = 100' or 1:1200
Plot file created: June 01, 1999

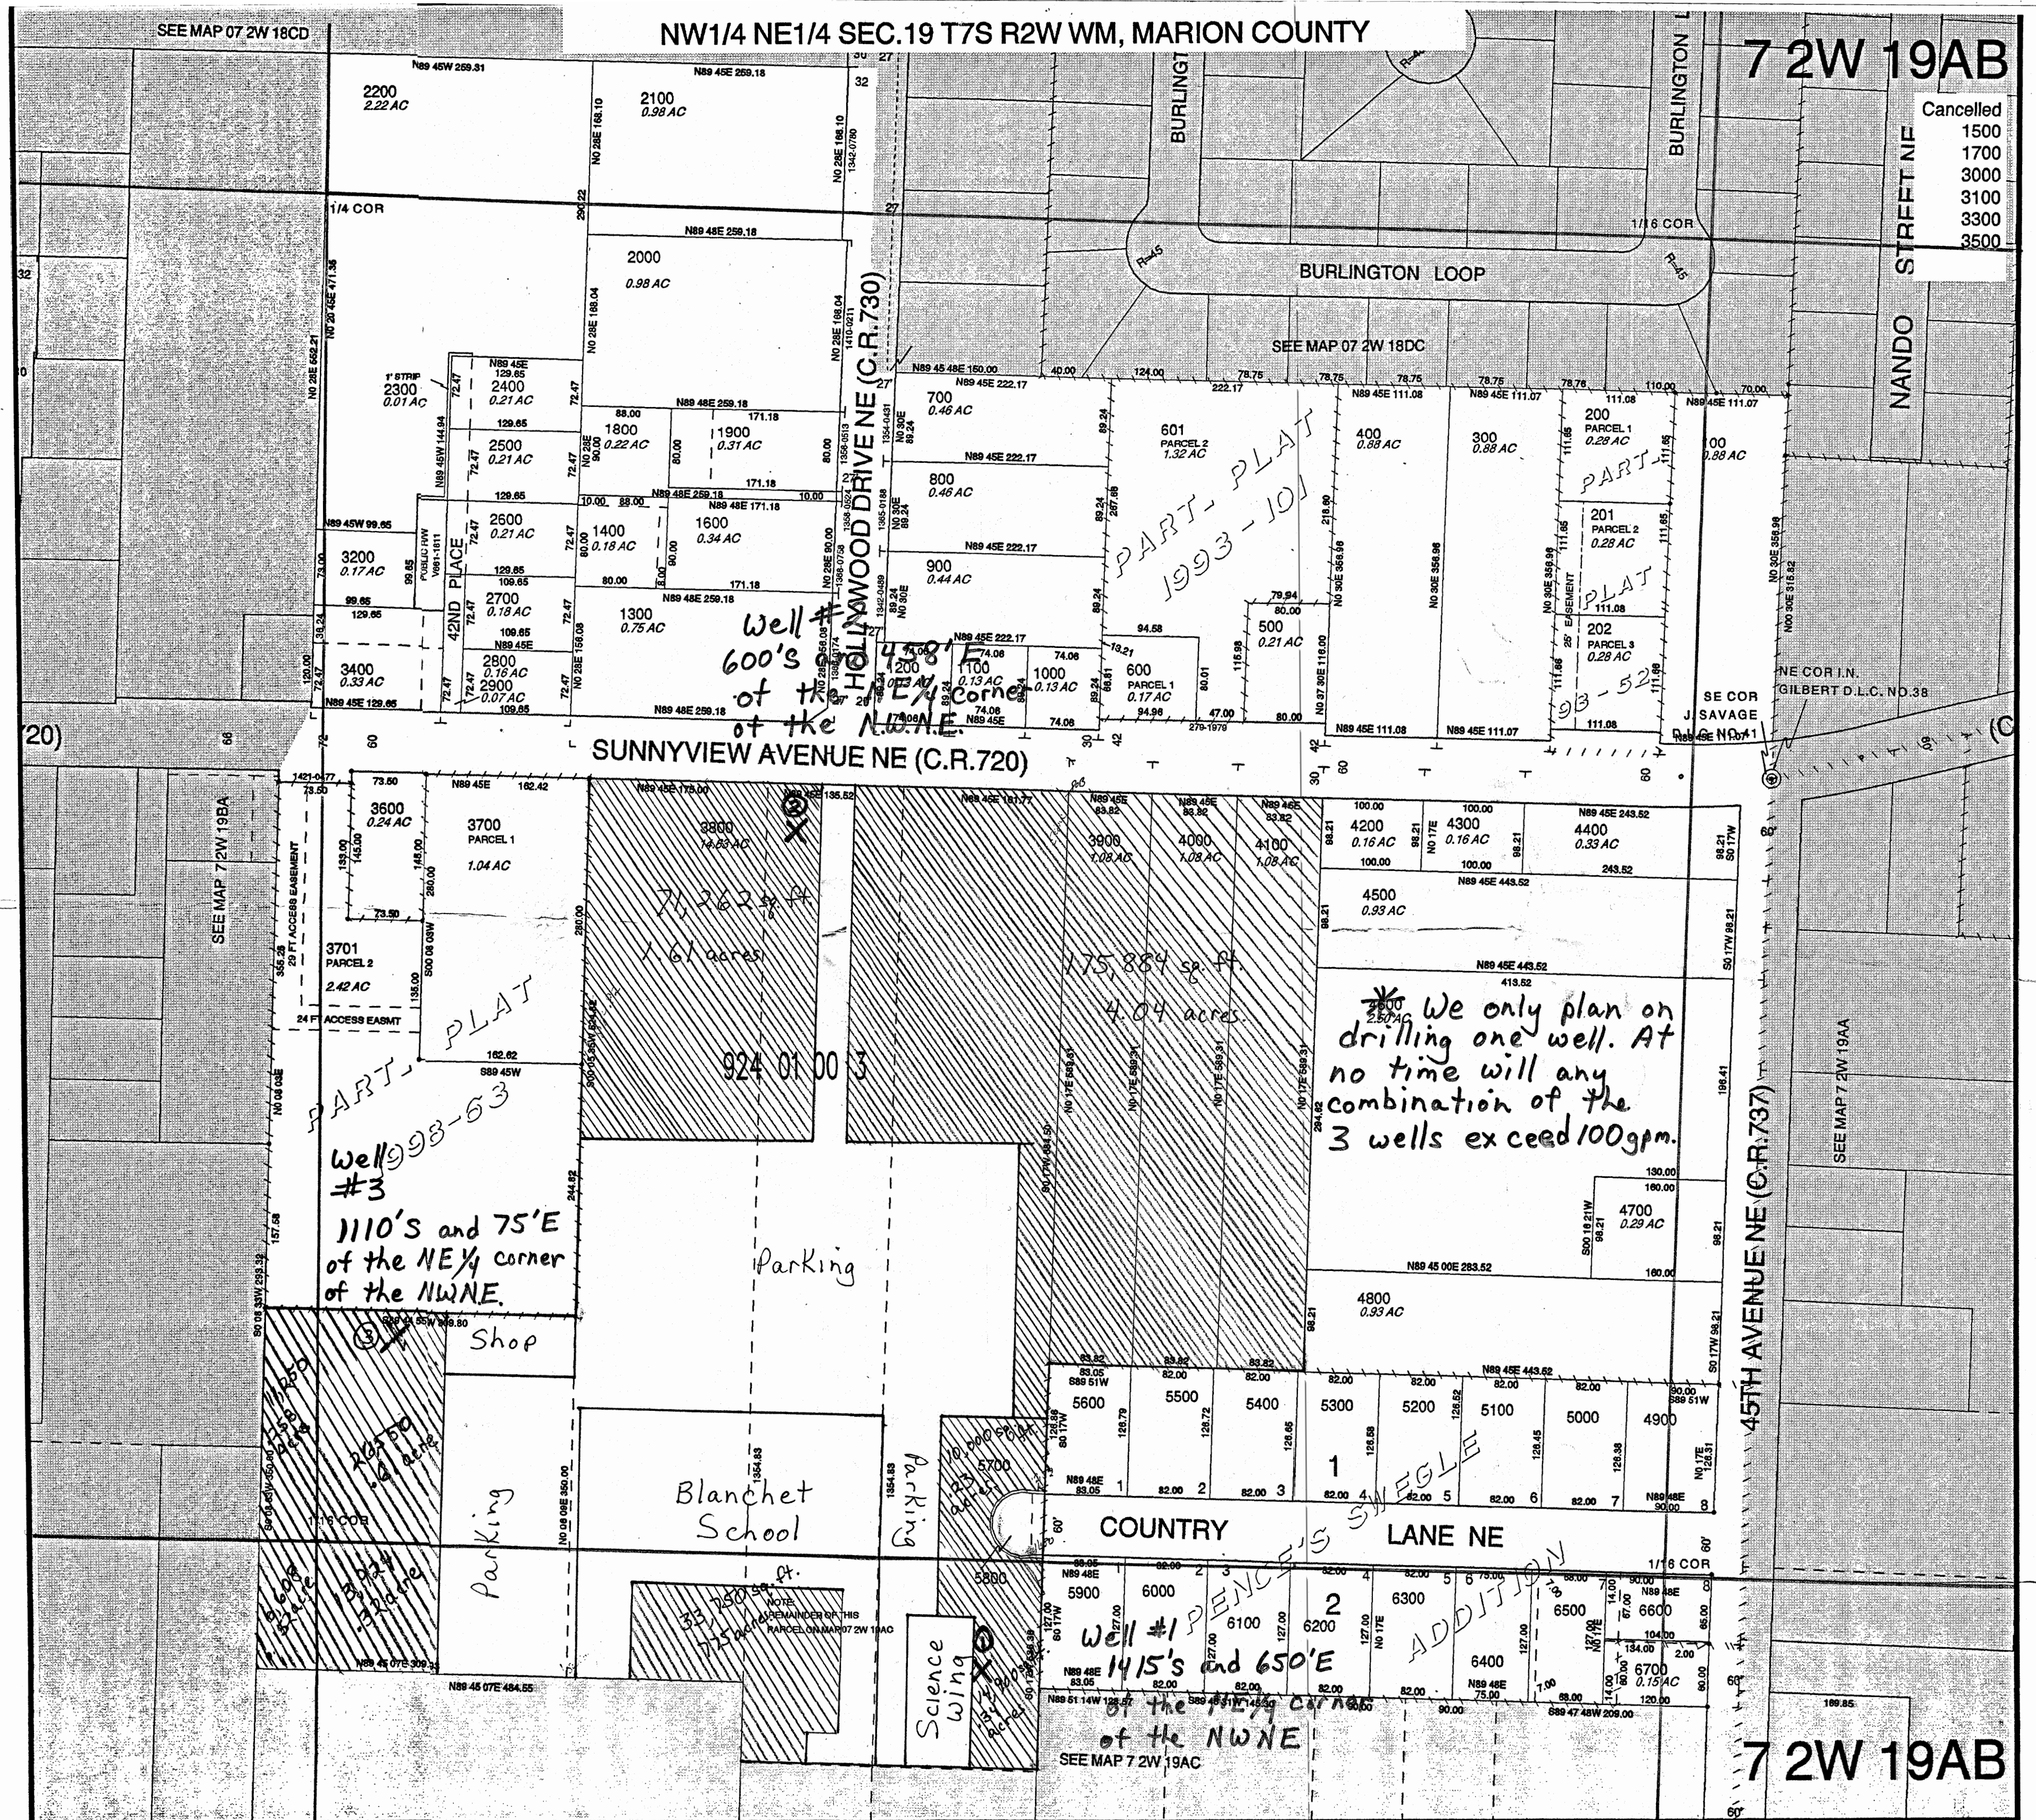

Cancelled
2301
2900
3000
3100
3200
3300
3400
3500
3600
3700
3800
3900
4000
4100
4200
4300
4400
4500
4600
4700
4800
4900

LEGEND

RECEIVED
JUL 12 2000
OLIV PROPERTY DEPT.
SALEM, OREGON

LINE TYPES
TAX LOT BOUNDARY
ROAD RIGHT-OF-WAY
RAILROAD
STREAM, LAKE, ETC.
TAX LOT BOUNDARY
SUBDIVISION BOUNDARY
TAX CODE BOUNDARY

SYMBOL TYPES
D.L.C.
CONTROL POINTS
SURVEY MONUMENTS
G.L.O. CORNERS

SECTION 1/4 SEC 1/16 SEC
1/4 COR 1/16 COR

NUMBERS
TAX CODE NO.
000 00 00 0

ACREAGE - ALL ACREAGES EXCLUDE ANY PORTION THAT MAY LIE WITHIN THE INDICATED PUBLIC RIGHT OF WAYS.

TICK MARKS - WHEN A TICK MARK IS INDICATED ON THE EXTENSION OF A LINK THEN THE DIMENSION GOES TO THE TICK MARK. GENERALLY THIS IS USED WHEN DIMENSIONS GO INTO PUBLIC RIGHT OF WAYS.

ARROWS ARE USED WITH DIMENSIONS IN AREAS OF GREATER COMPLEXITY.

NOTICE: This map was created for Assessor's Office use ONLY.



SCALE 1" = 100'
or 1:1200
Plot file created: March 24, 1998
/data/assmaps/m072w19ac.gis

