

T 20S, R 2W, Sec 6

RECEIVED BY OWRD


APR 02 2015

SALEM, OR

NE SW & NW, SE; TL 2100

TAX MAP LOT 2002000002100

SEE MAP
20030100

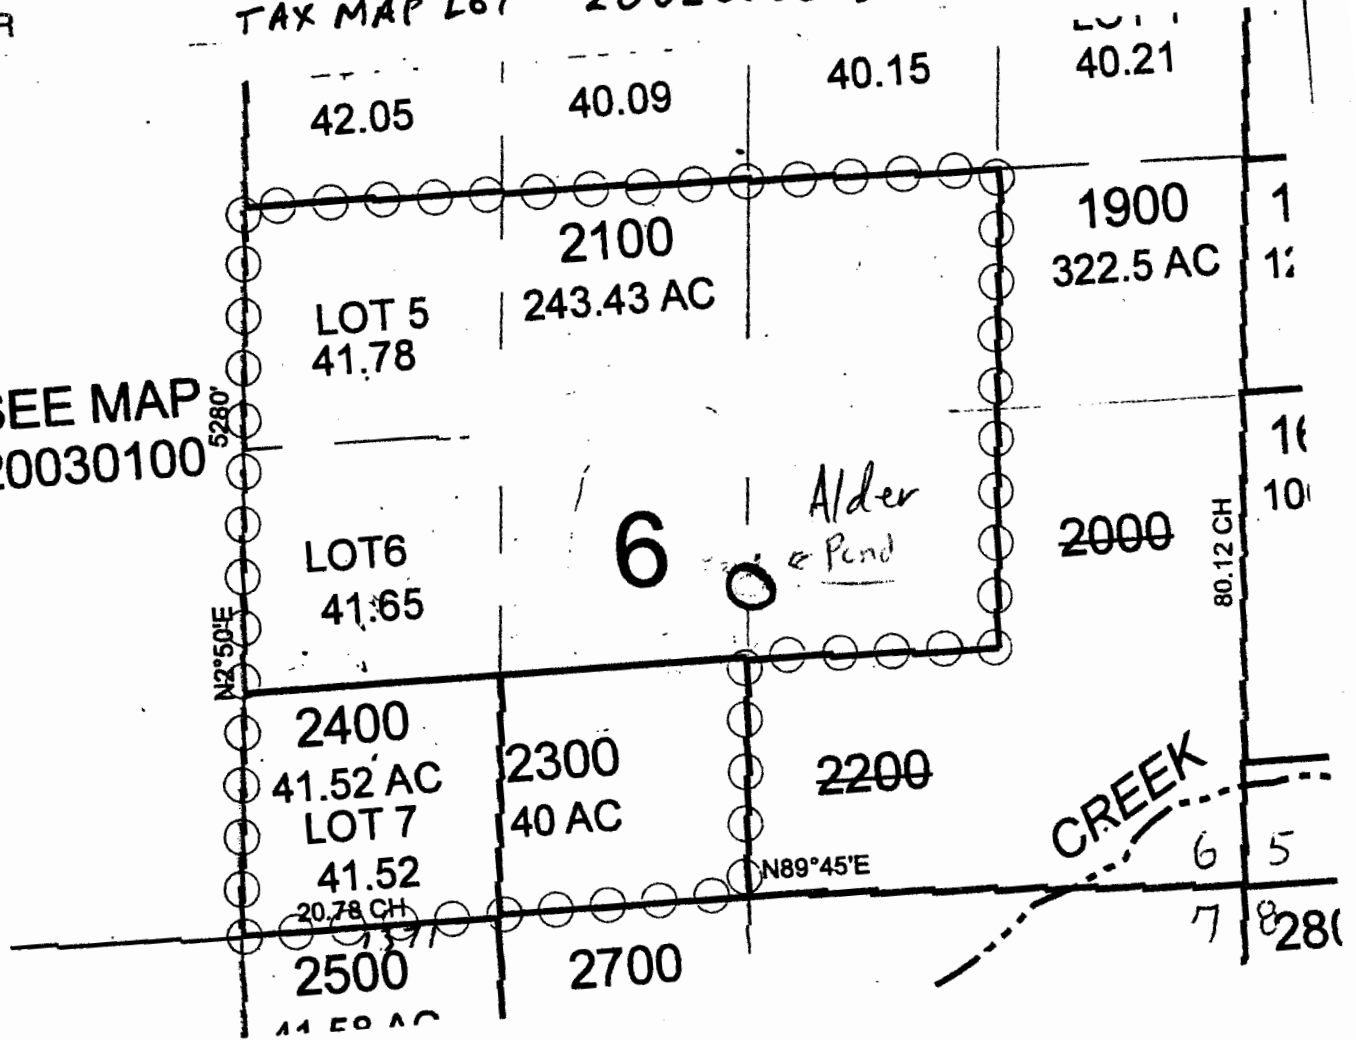

1" = 1000'



Pond is 1600 ft
N of S 1/4 corner
Sec 6

P. B. B. B.