

LEGEND

● Cadastral monument set CS 2013-020

○ Utility pole

⊗ Water Valve (unless noted otherwise)

— Property boundary, surveyed CS 2013-020

— Existing fence line.

--- 30 ft Easement per WC Assessors map Revised 11/2013

— Traveled Way

— Overhead utility line

— Existing buried irrigation pipe located per Ralph Swinehart

Domestic Water & Irrigation Line Location

Township 2 South, Range 44 East, Section 17, W.M., Wallowa County, OR

Wallowa Associates-Rod Lewis, LS

March 17, 2015

RECEIVED

APR 07 2015


WATER RESOURCES DEPT
SALEM, OREGON

End Bears: N75°23'56"W
27.51' from NE $\frac{1}{16}$ corner.

GRAPHIC SCALE



Line	Bearing	Length	Line	Bearing	Length
L1	N56°03'30"E	105.37'	L18	N78°21'09"E	46.18'
L2	S78°32'59"E	34.65'	L19	N62°34'48"E	121.84'
L3	S63°21'43"E	29.86'	L20	N41°21'35"E	148.24'
L4	S70°07'59"E	27.72'	L21	N36°30'44"E	138.08'
L5	S80°06'16"E	41.83'	L22	N16°48'45"E	105.52'
L6	N84°18'00"E	24.80'	L23	N38°10'43"E	72.37'
L7	N67°13'27"E	39.23'	L24	N60°13'26"E	200.59'
L8	N66°12'11"E	83.50'	L25	N37°38'25"E	206.09'
L9	N75°27'10"E	40.61'	L26	N76°05'17"E	134.09'
L10	N55°16'46"E	81.01'	L27	N53°59'47"E	48.83'
L11	N05°29'11"E	80.63'	L28	N12°07'42"E	51.89'
L12	N08°49'23"E	89.89'	L29	N06°04'50"E	214.71'
L13	N54°27'17"E	13.35'	L30	N26°06'32"E	115.88'
L14	N76°17'46"E	31.91'	L31	N04°14'28"E	102.07'
L15	N86°29'24"E	147.35'	L32	N21°14'49"W	65.07'
L16	S87°40'24"E	92.61'	L33	S26°41'31"E	94.53'
L17	S87°20'06"E	96.42'	L34	S33°51'47"E	103.10'

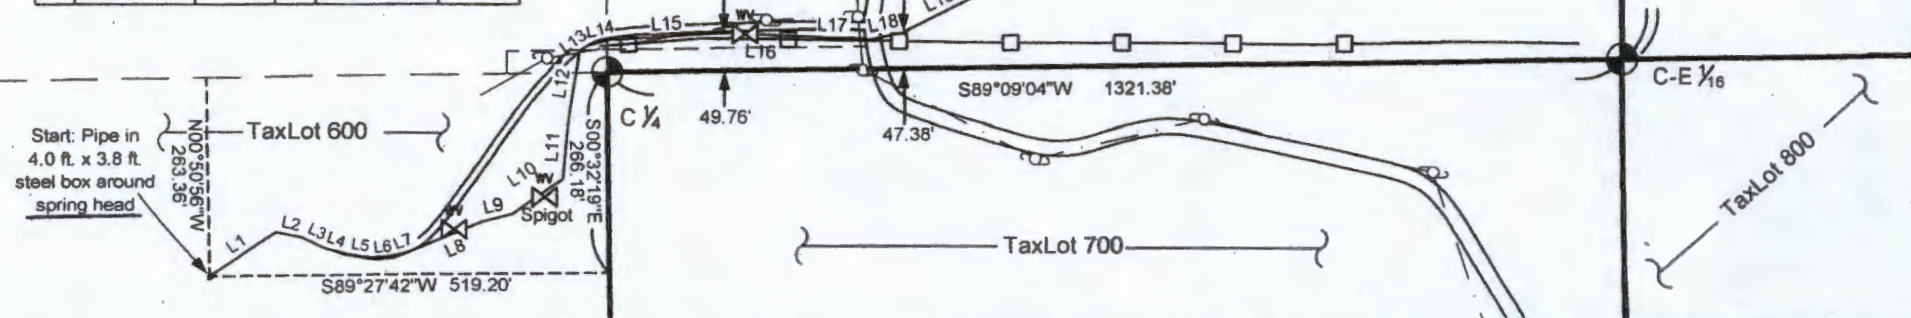

Tax Lot s 600, 200 & 401



- 025 44E Sec 17
- View q2 Tax Lots 600,200 + 401

WATER RESOURCES DEPT
SALEM, OREGON

5-80070

$1'' = 400'$

02S44E17

RECEIVED

APR 07 2015

**WATER RESOURCES DEPT
SALEM, OREGON**

5-8870