PAINE

34483 DEERWOOD DRIVE

EUGENE, OR 97405

OREGON

00'

HEETS

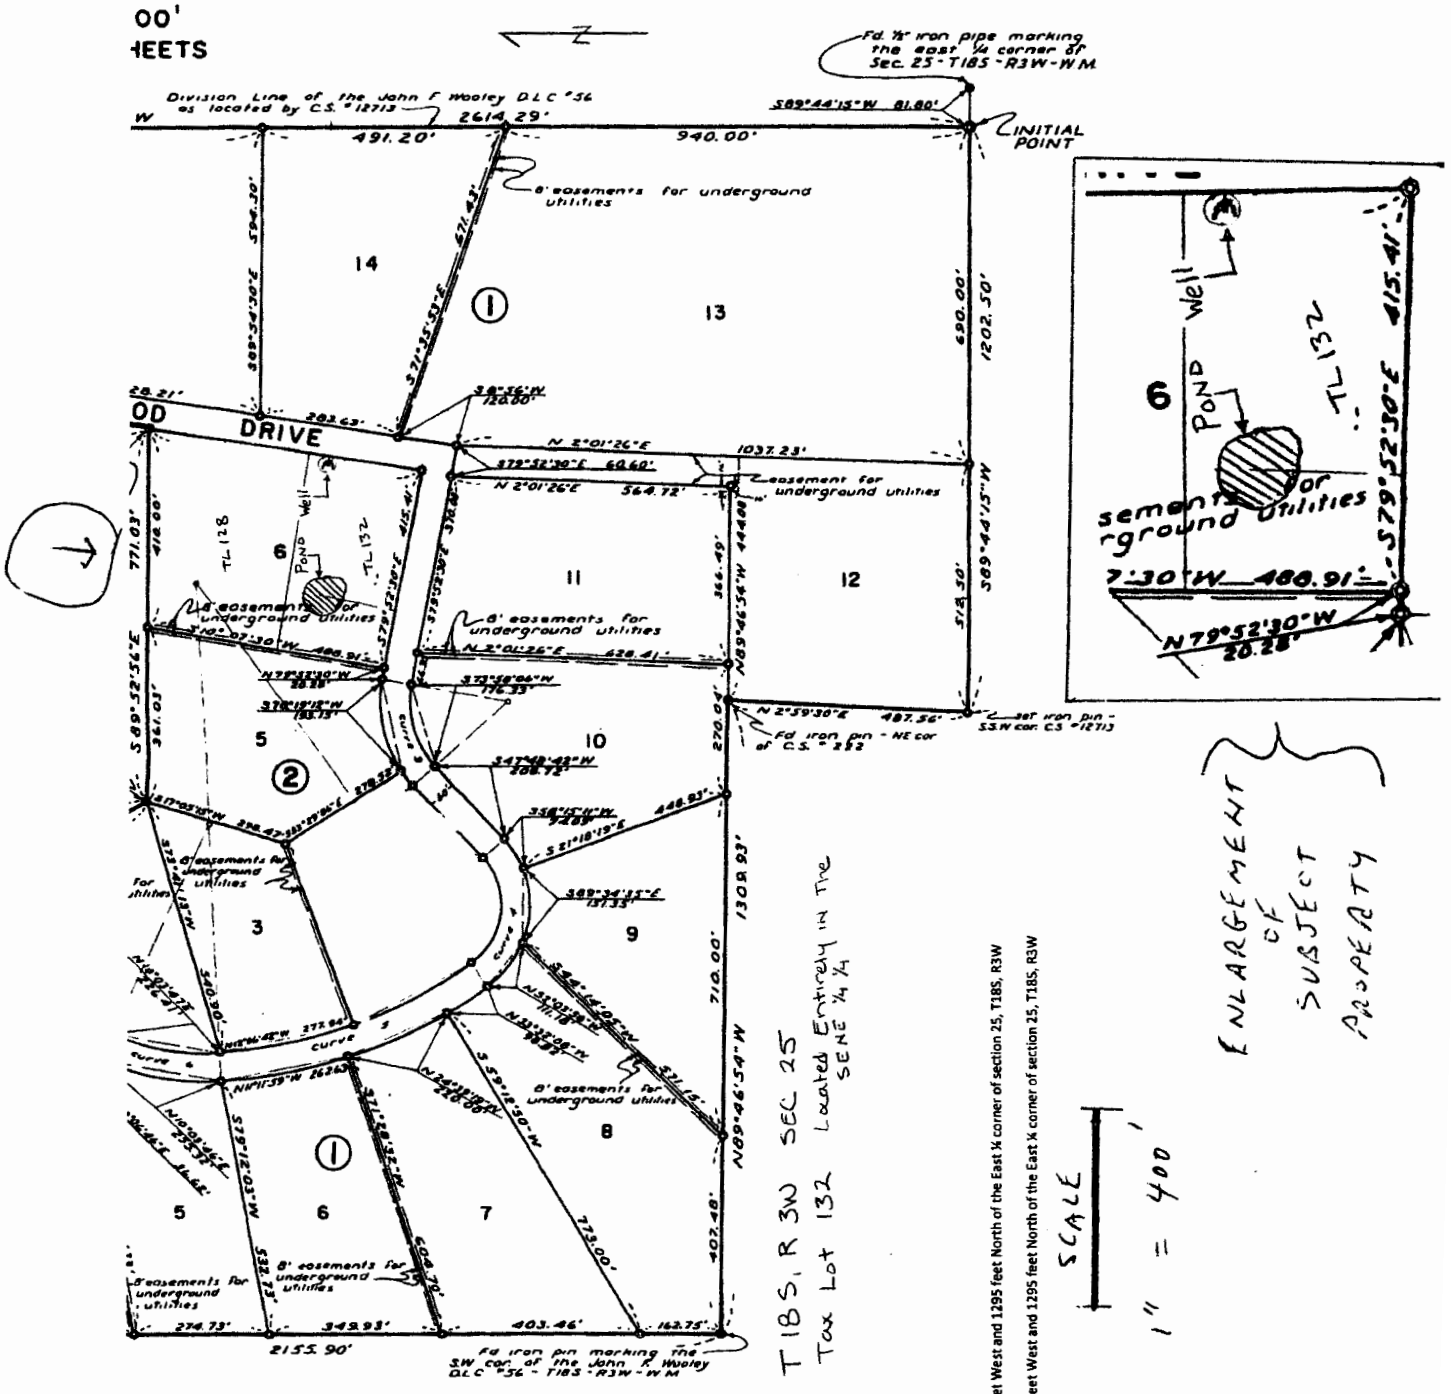

RECEIVED BY OWRD

APR 24 2015

SALEM, OR

G-18060

OREGON
00'
HEETS

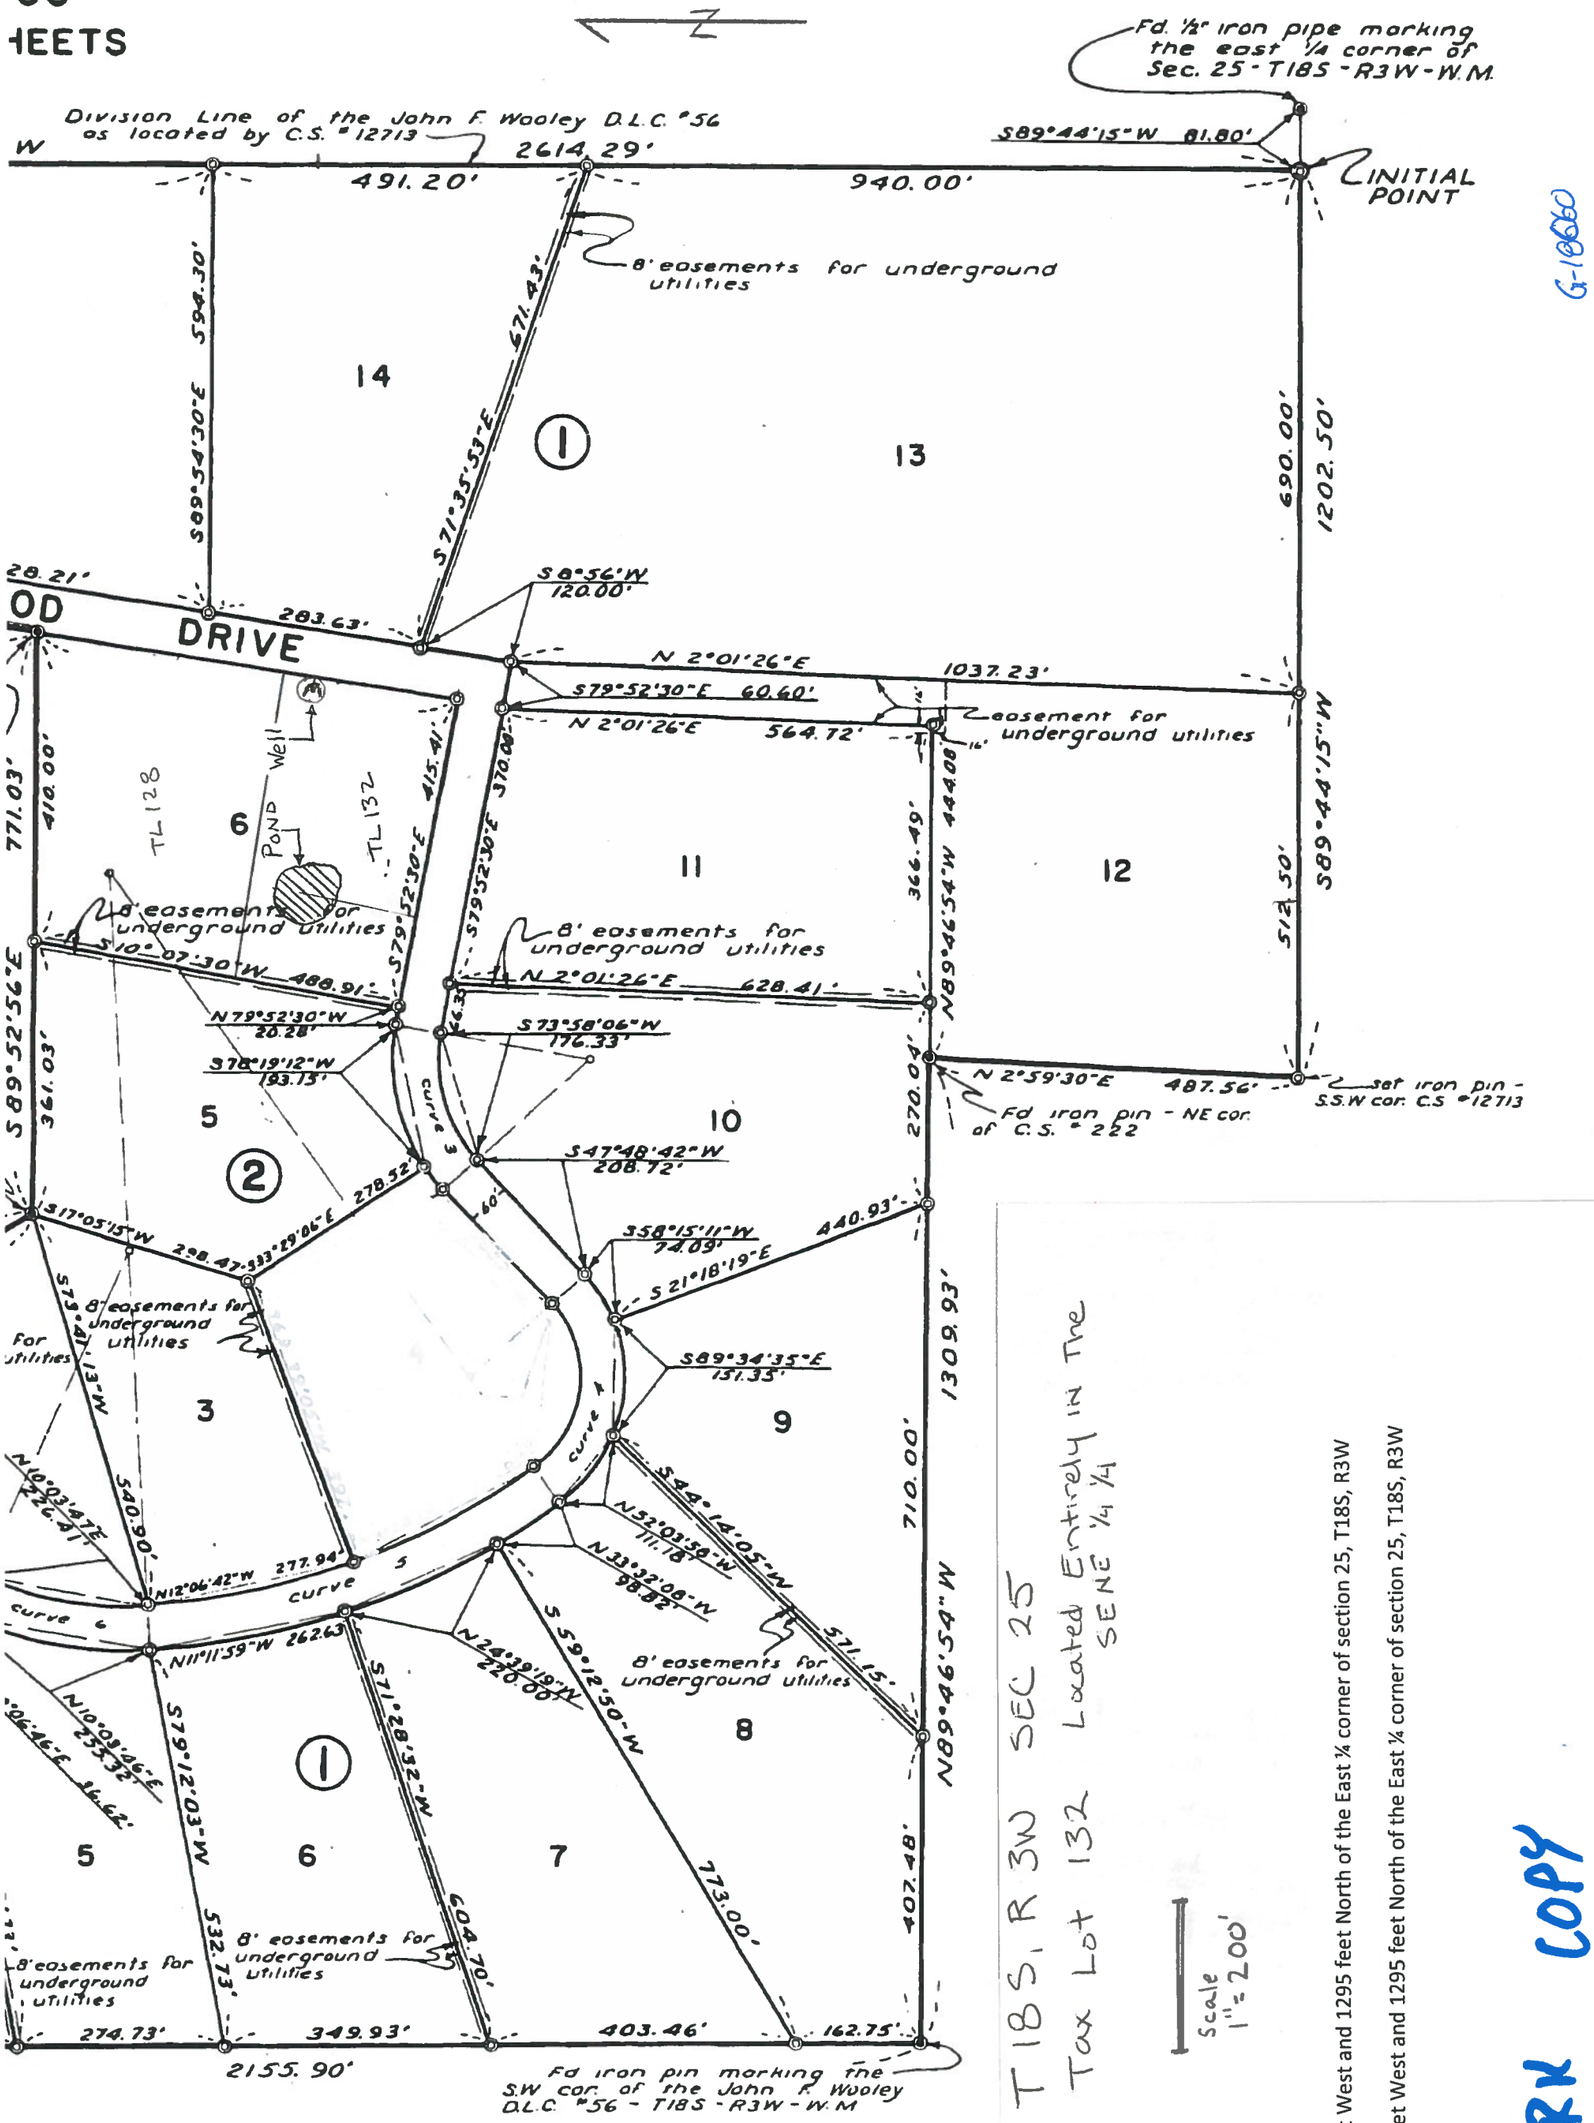

T18S, R3W SEC 25
Tax Lot 132 Located Entirely in The SENE ¼ ¼

Scale 1" = 200'

Well located 690 feet West and 1295 feet North of the East ¼ corner of section 25, T18S, R3W

Pond Located 965 Feet West and 1295 feet North of the East ¼ corner of section 25, T18S, R3W


WORK COPY