

SECTION PLAT


Section 7 Township 17S Range 31E
County of Grant State of Oregon

NORTH

RECEIVED BY OWRD

APR 30 2015

SALEM, OR

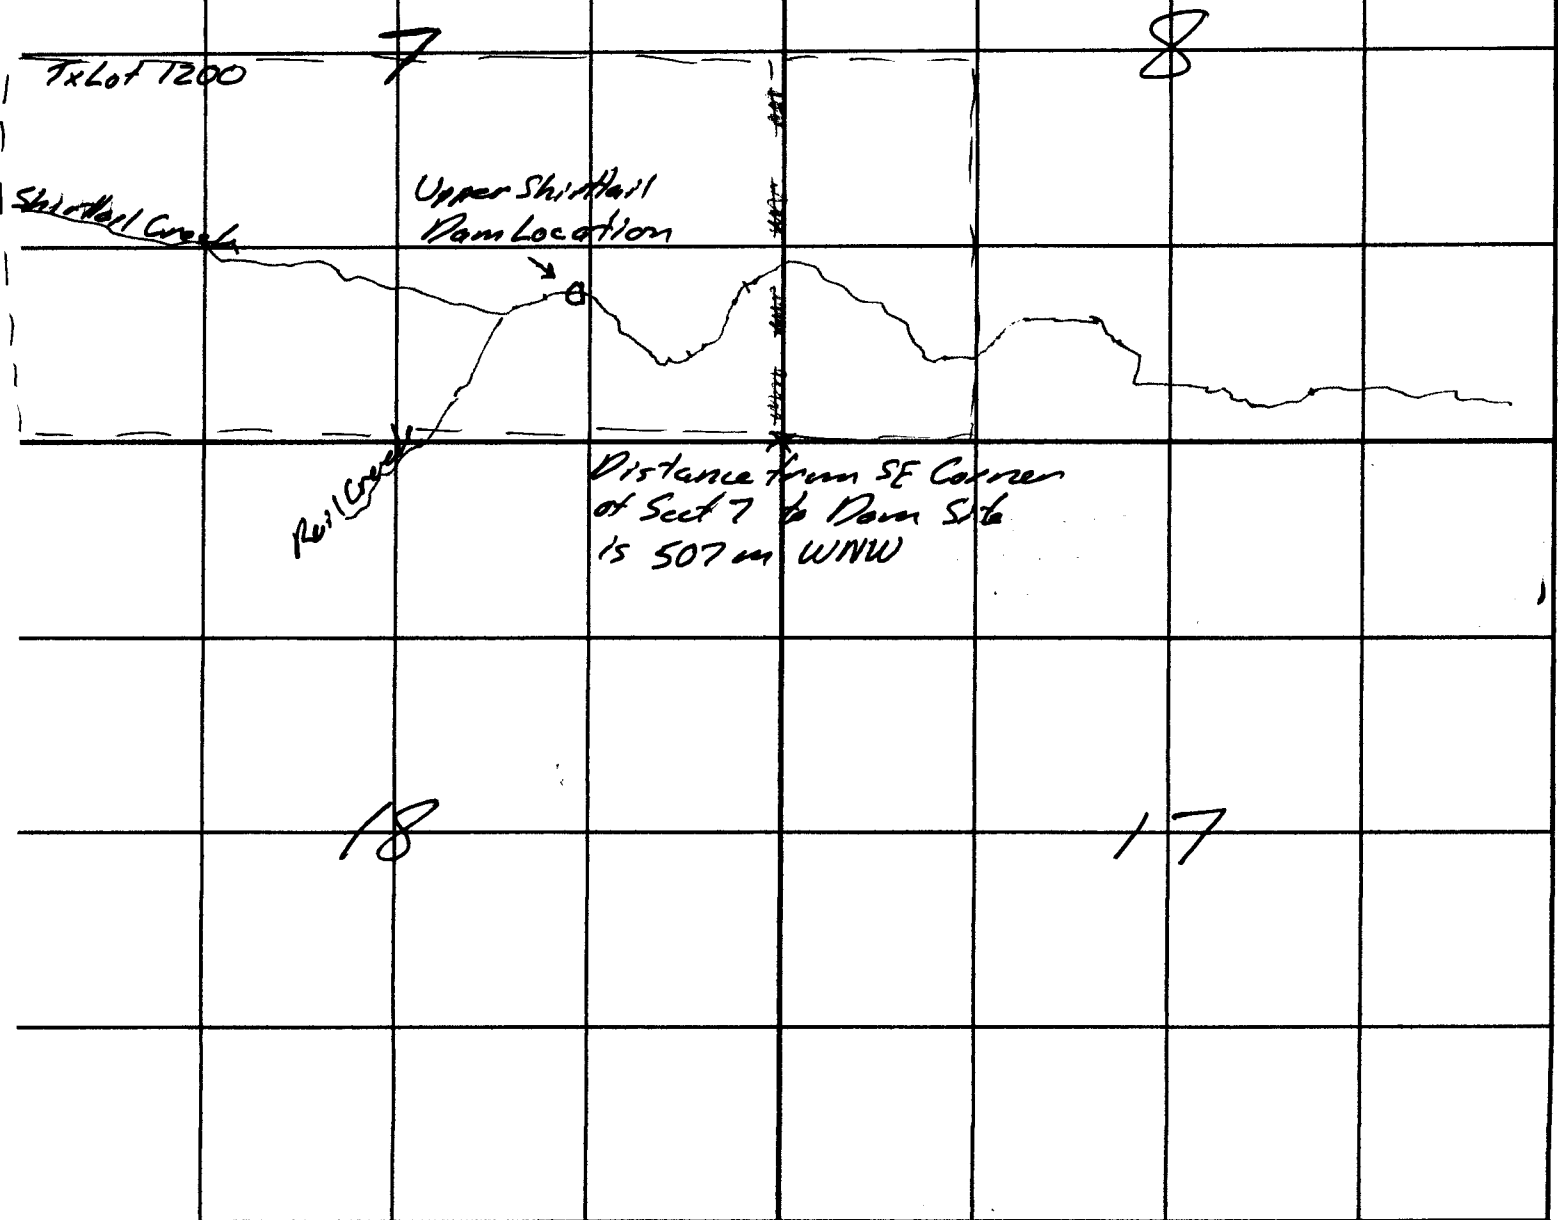

R-88077

4"=1 mile