

# SECTION PLAT

Section 7 Township 17S Range 31E  
County of Grant State of Oregon


NORTH



RECEIVED BY OWRD

APR 30 2015

SALEM, OR

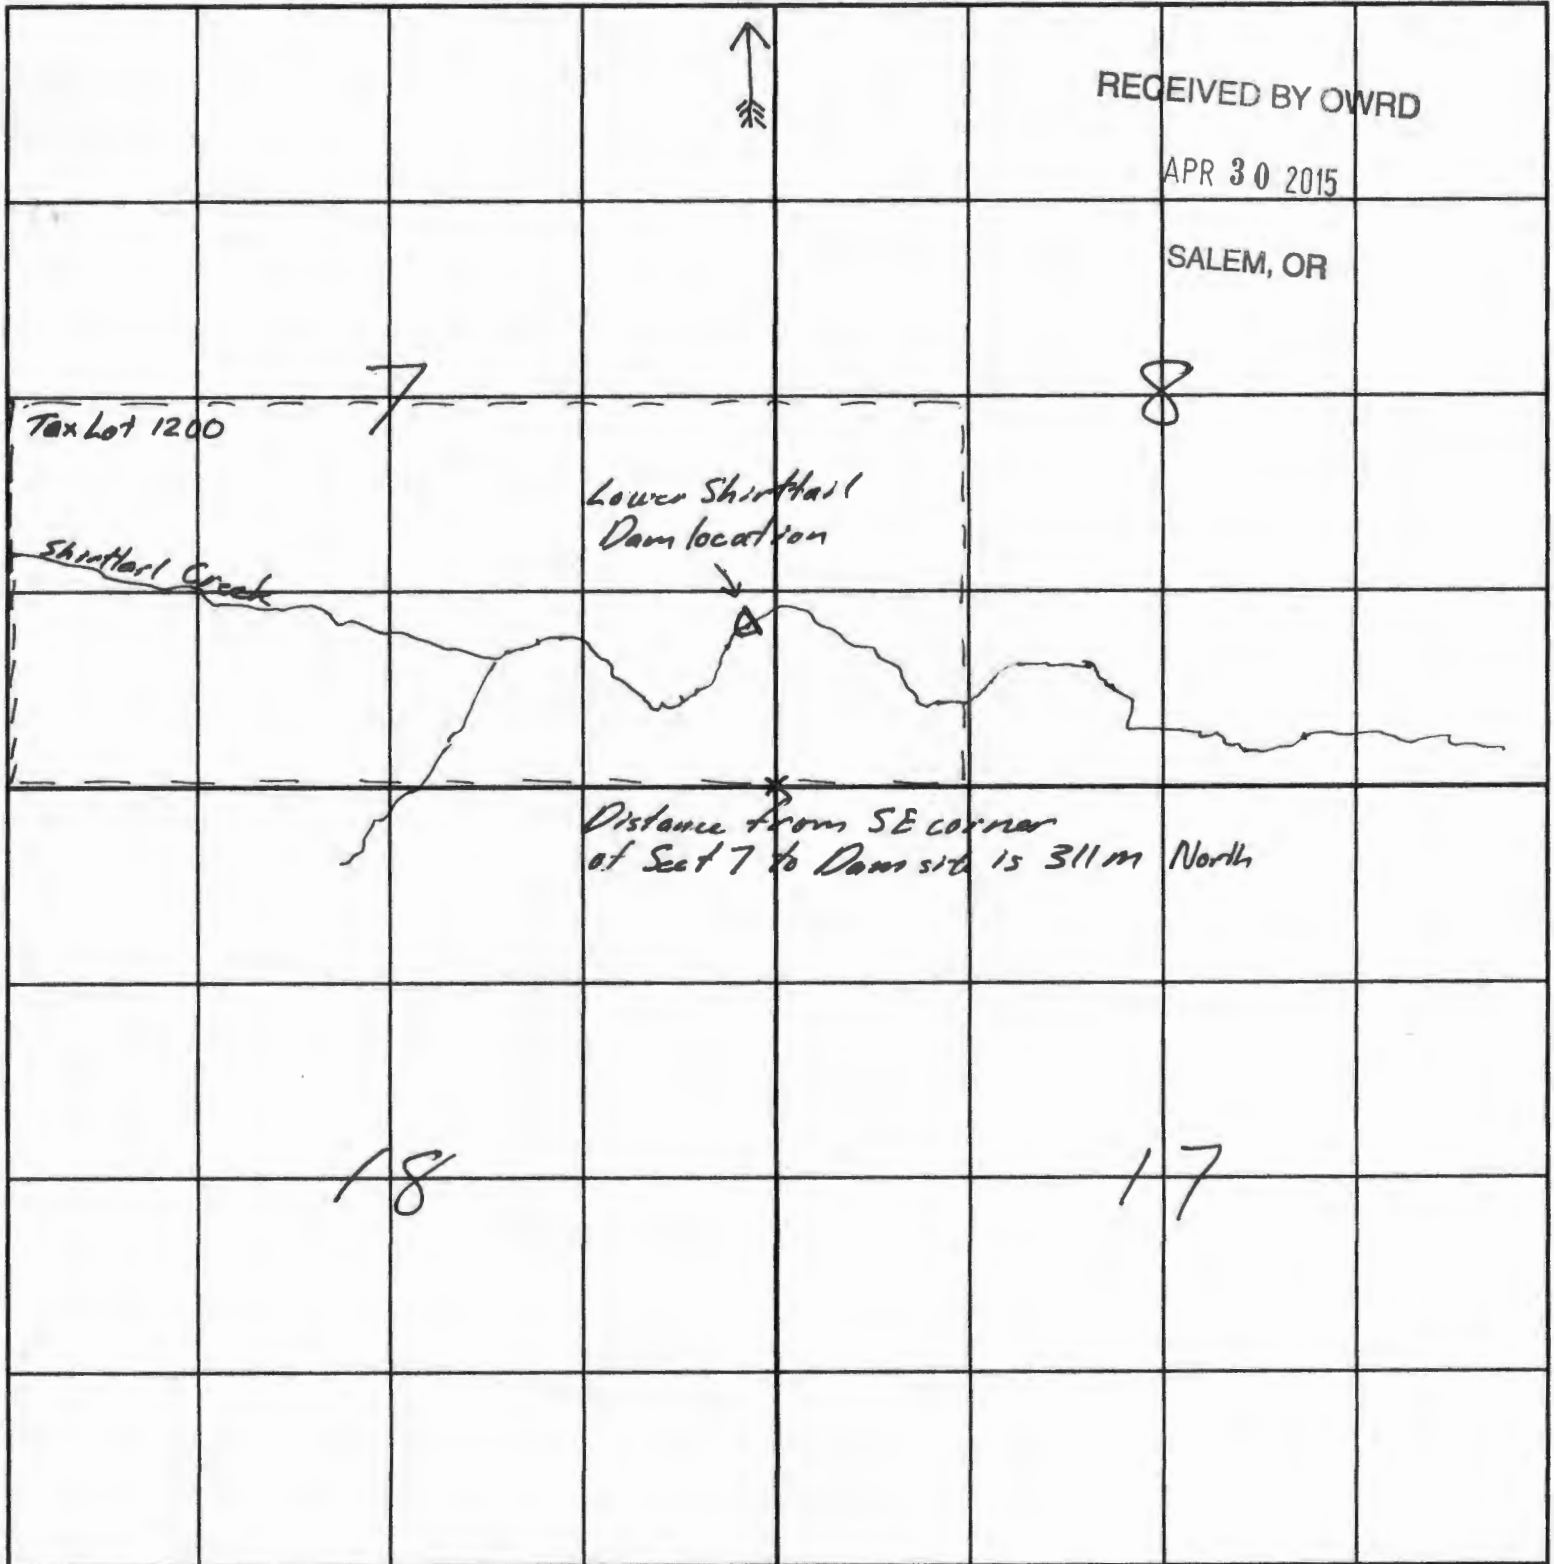

R 88079

4"=1 mile