


# SECTION PLAT

Section 7 Township 17S Range 31E  
County of Grant State of Oregon

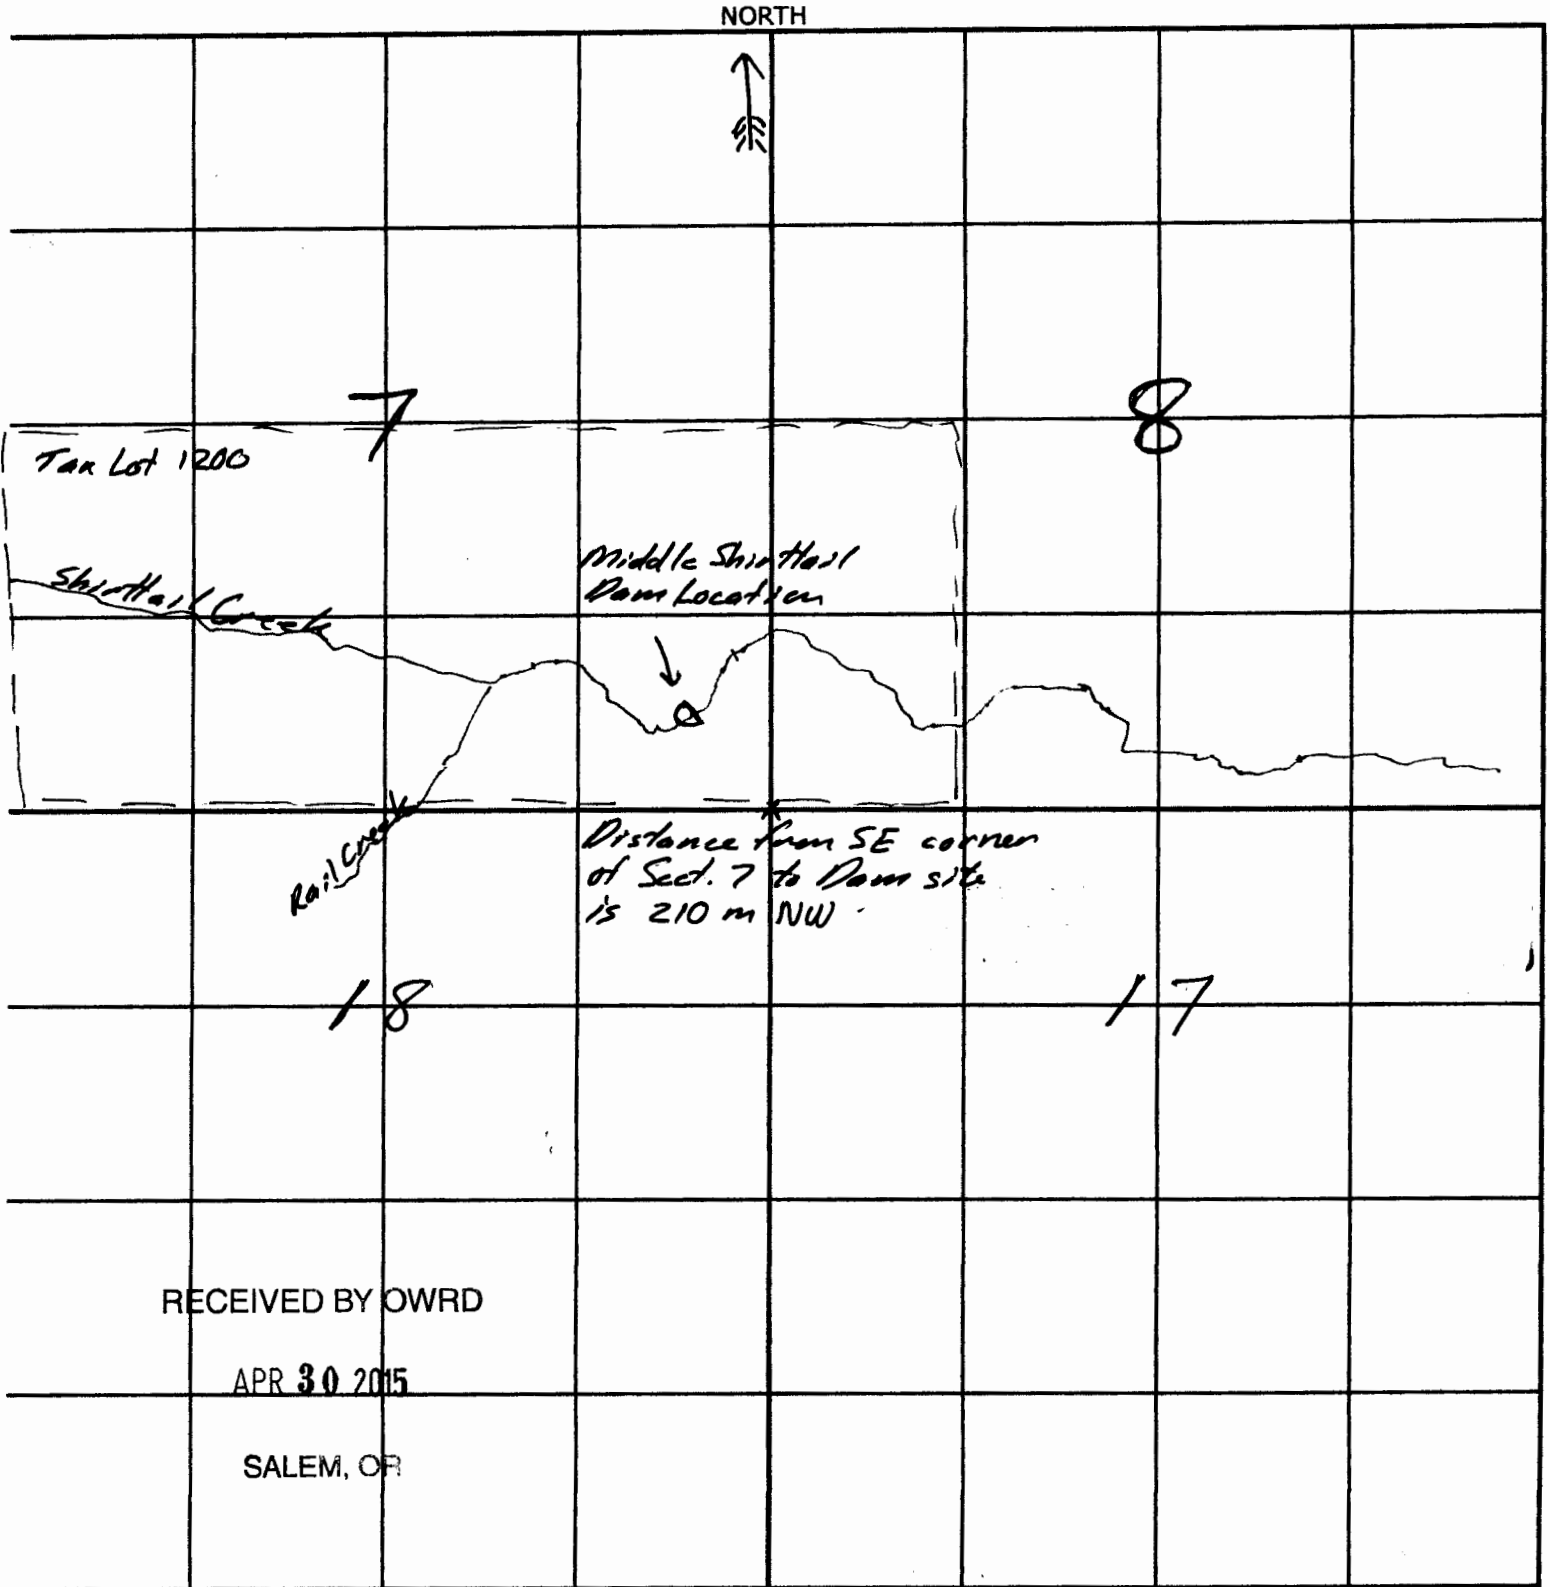

R-880894

4"=1 mile