


Map was prepared for assessment purpose only.

THIS MAP WAS PREPARED FOR ASSESSMENT PURPOSE ONLY

CANCELLED

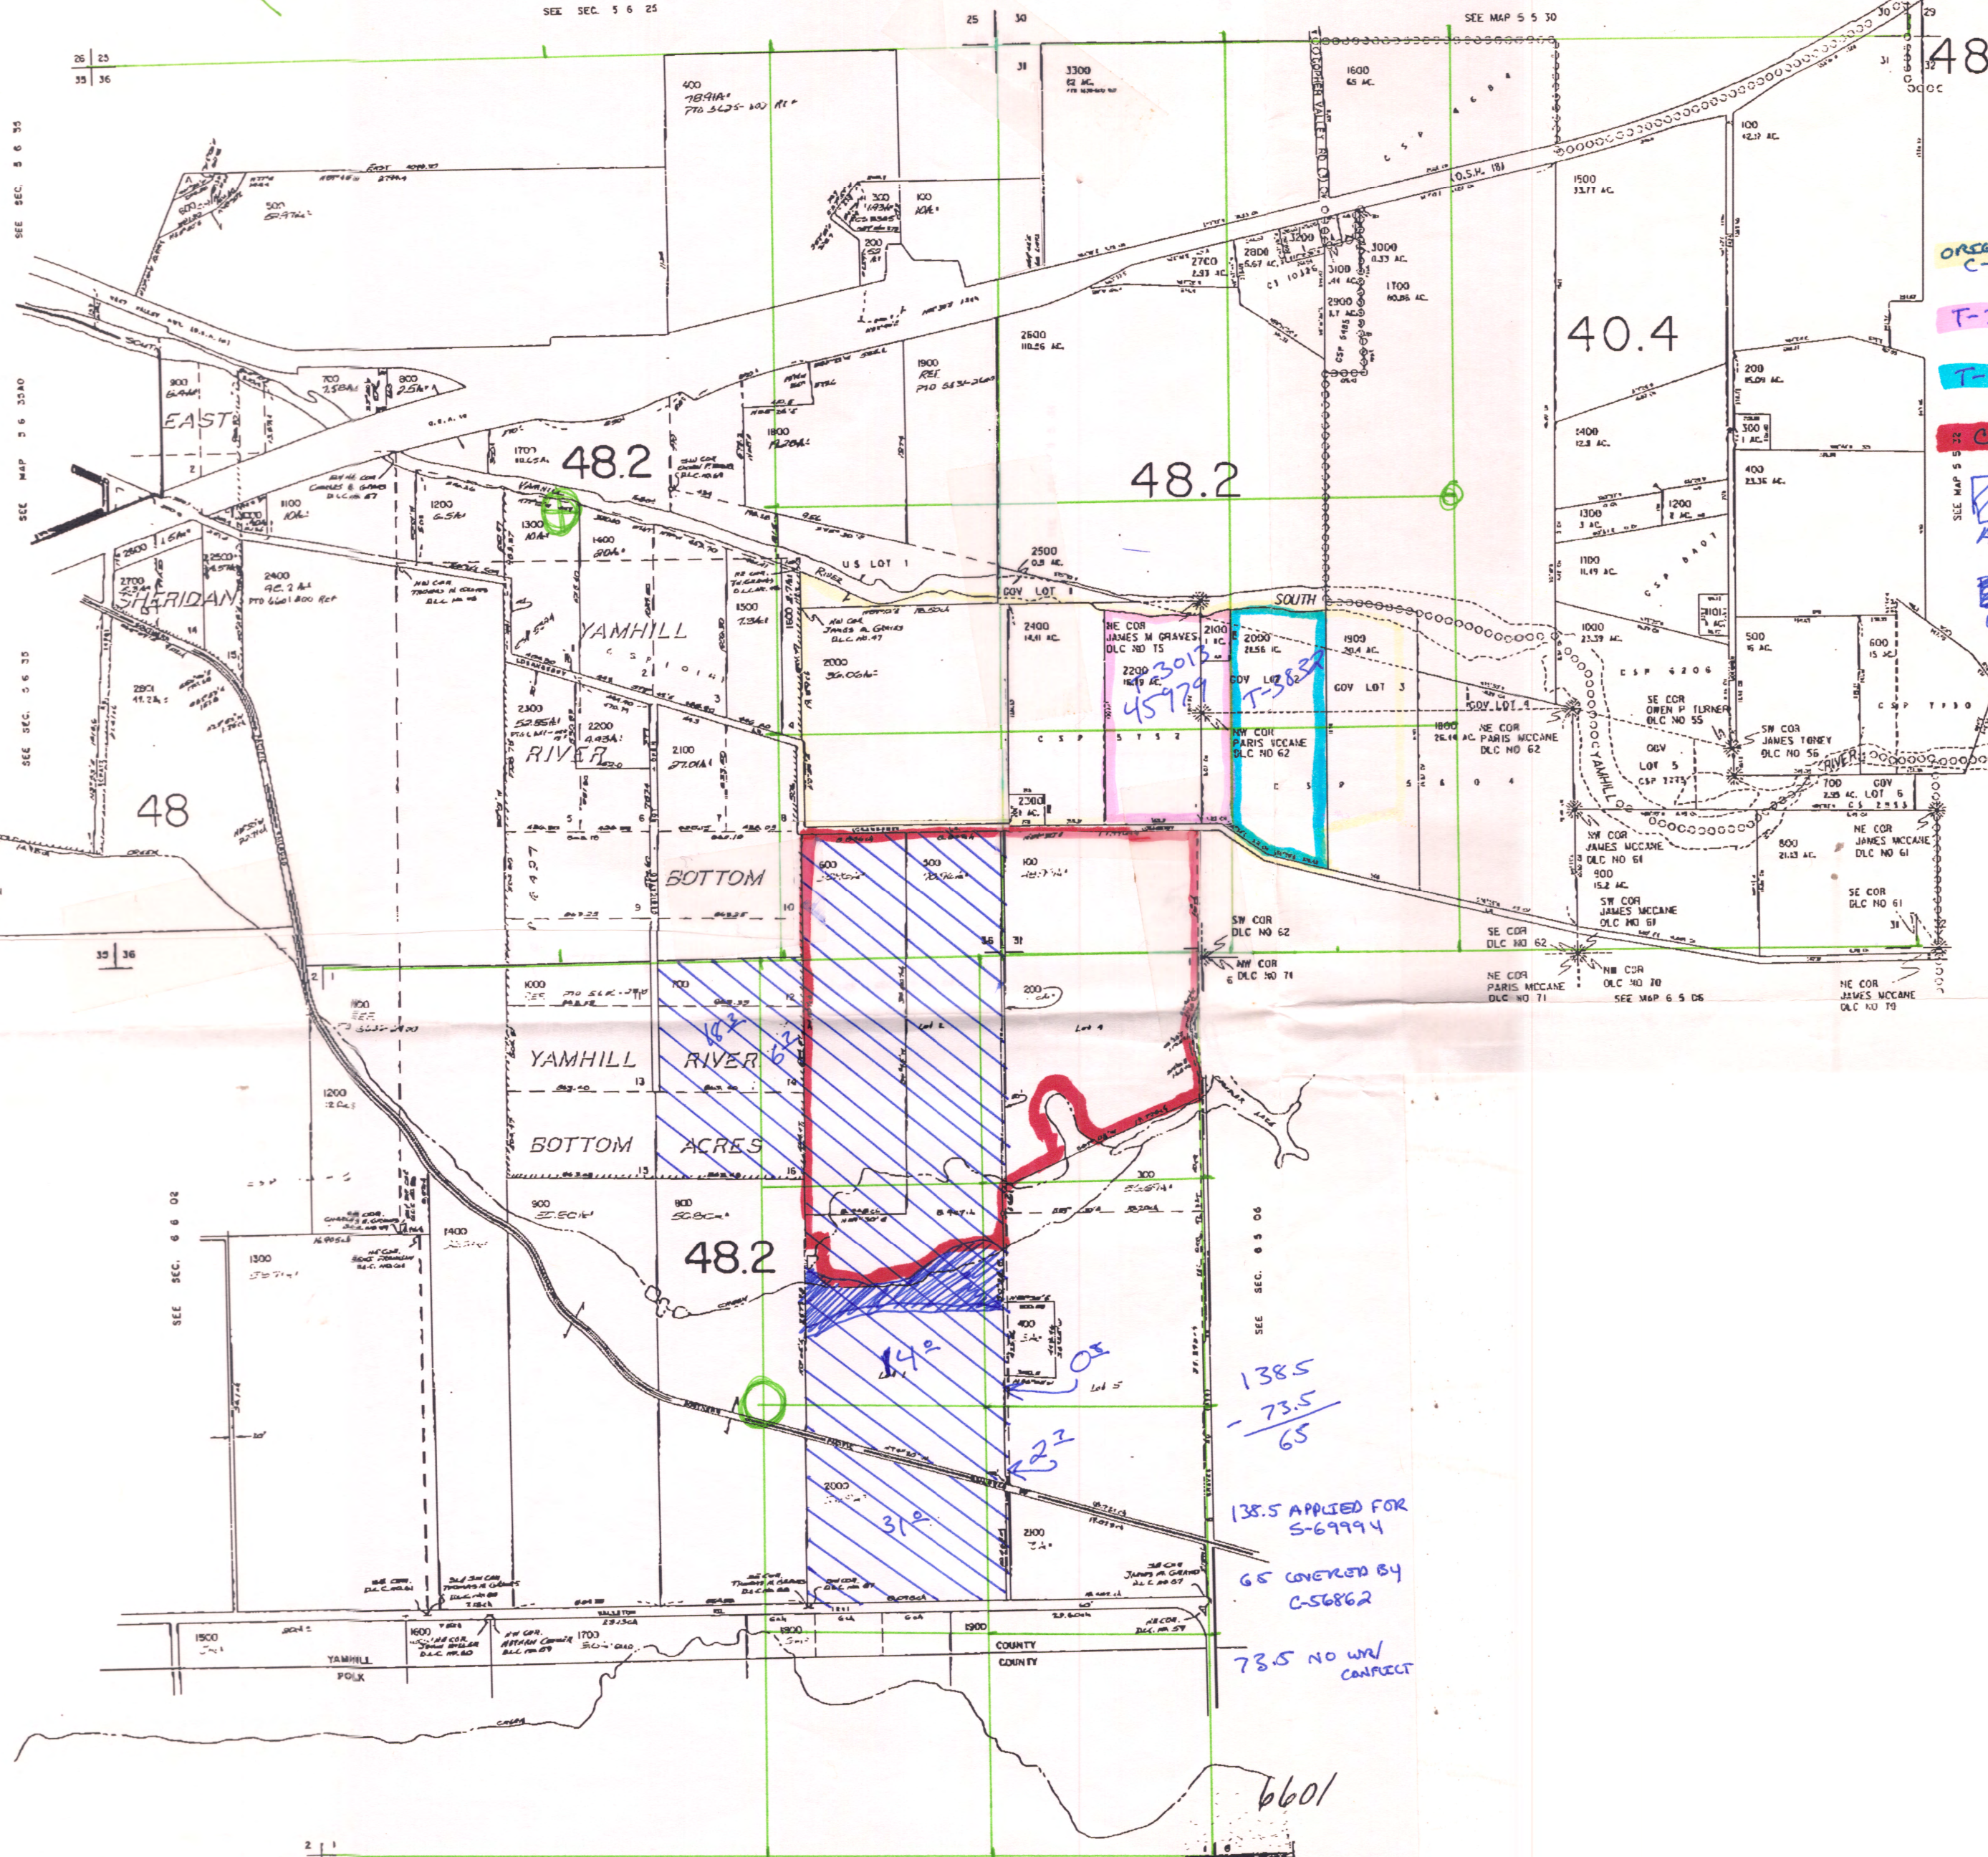

ORIG. 46441  
C-39112

T-3013

T-3832

C-56862

SEE MAP S 22  
APN-69994

WASTE

AUG 30 '95 08:29AM YAMHILL COUNTY CLERK

115800

48.2

40.4

48.2

48.2

48

48.2

138.5  
- 73.5  
---  
65

138.5 APPLIED FOR  
S-69994  
65 COVERED BY  
C-56862

73.5 NO W/ CONTRACT

6601