


Scale 1" = 400' Township 5 South, Range 11 East, Section 36 North West Quarter:

SEE MAP 25 11 23

Center point of dam is 1250' east and 110' south of the Northwest corner of section 36

R. 29009  
N  
Z

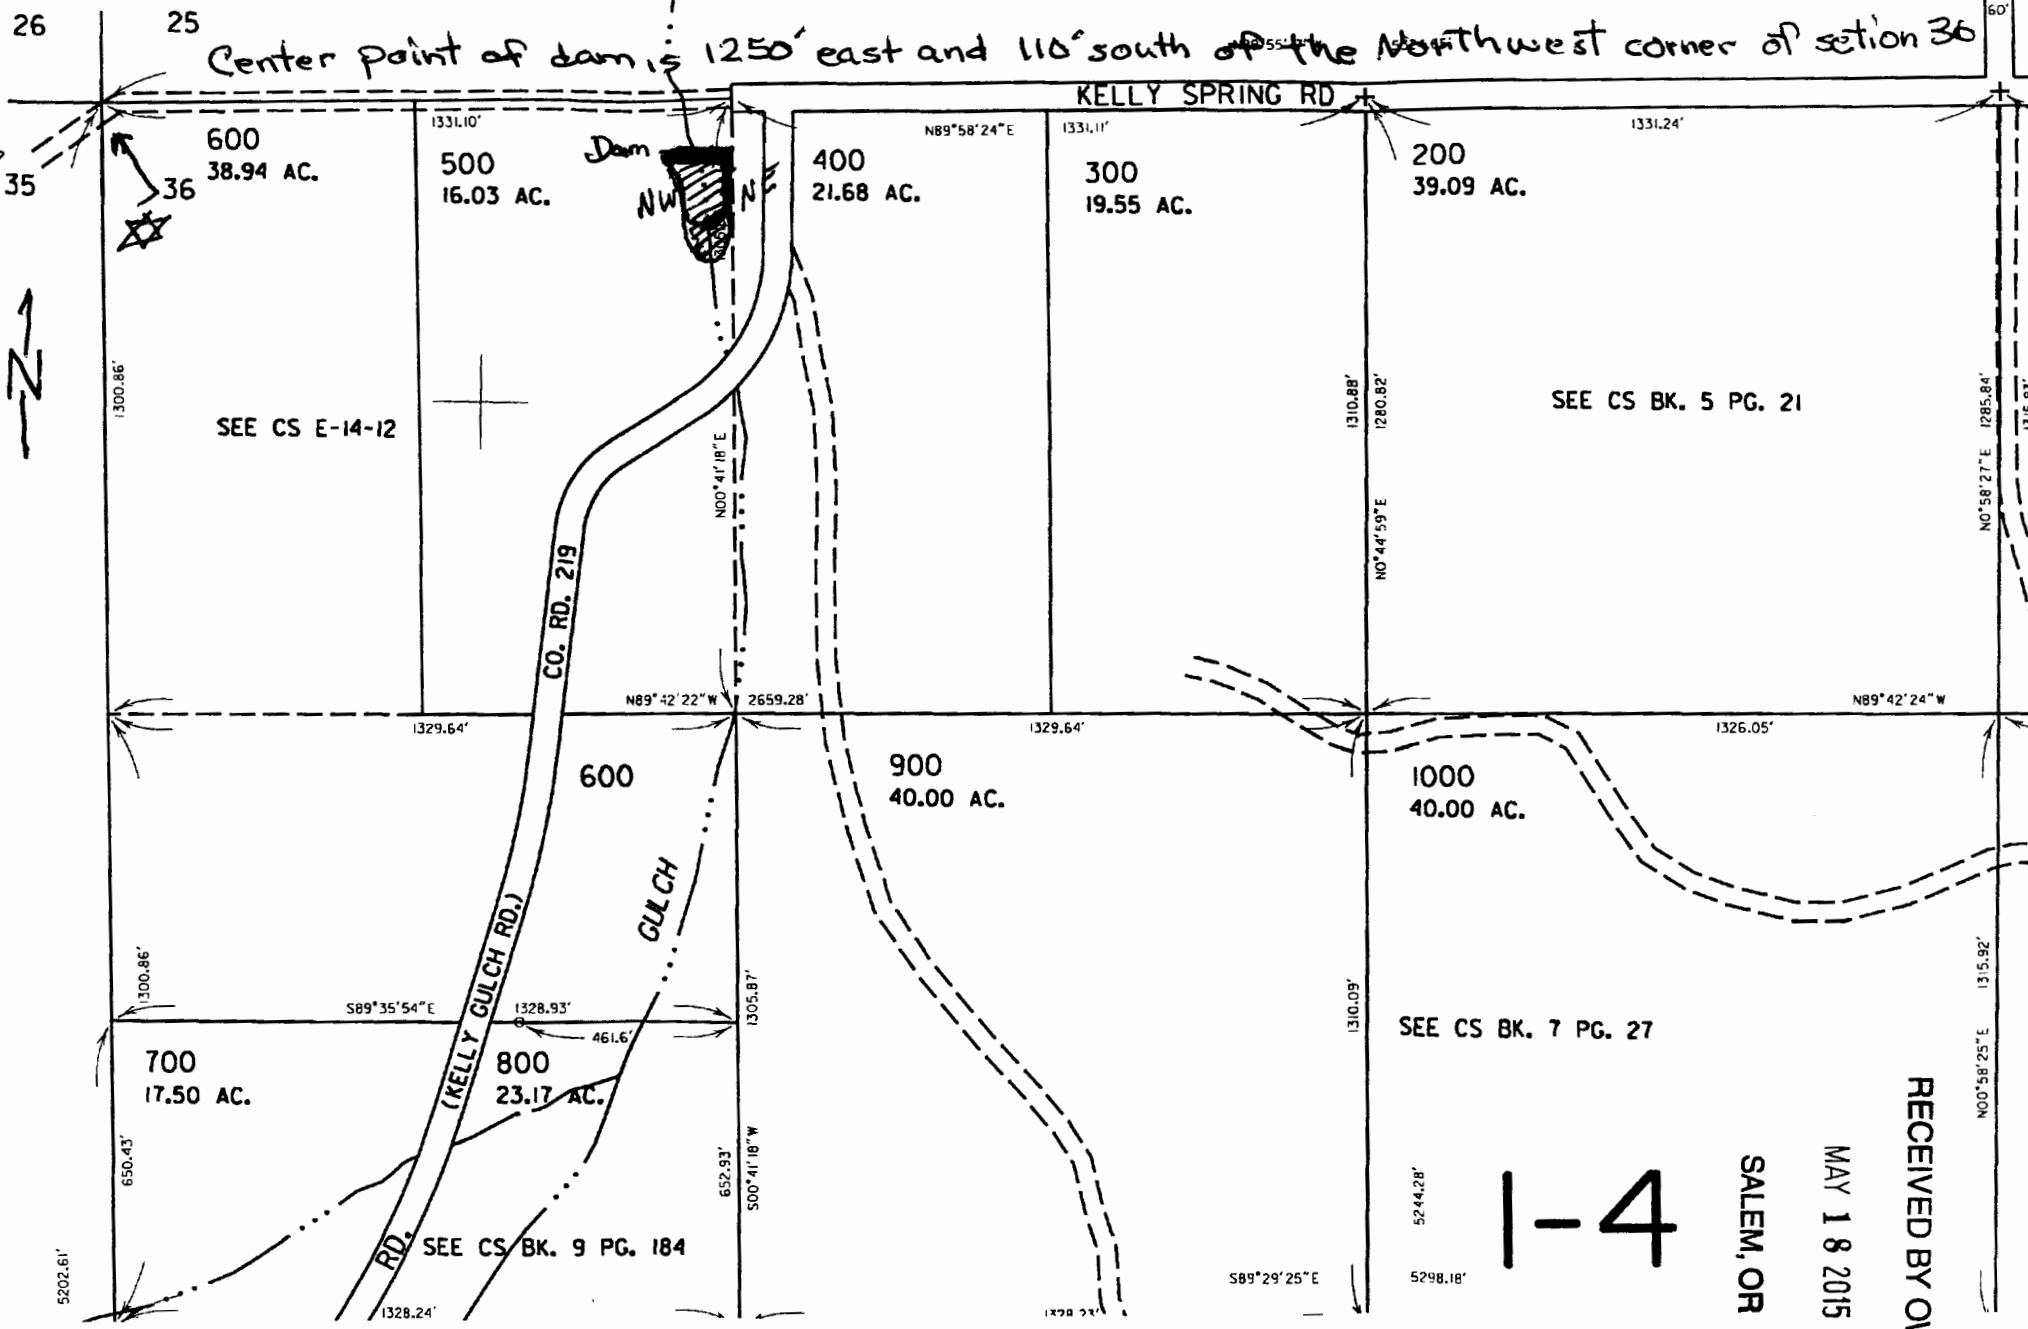

RECEIVED BY OWRD

MAY 18 2015

SALEM, OR

1-4


5244.28'  
5248.18'

# 5S 11E Sec 36, Tax Lot 500



Oregon Water Resources  
Department  
District 3 Watermaster


R-98087

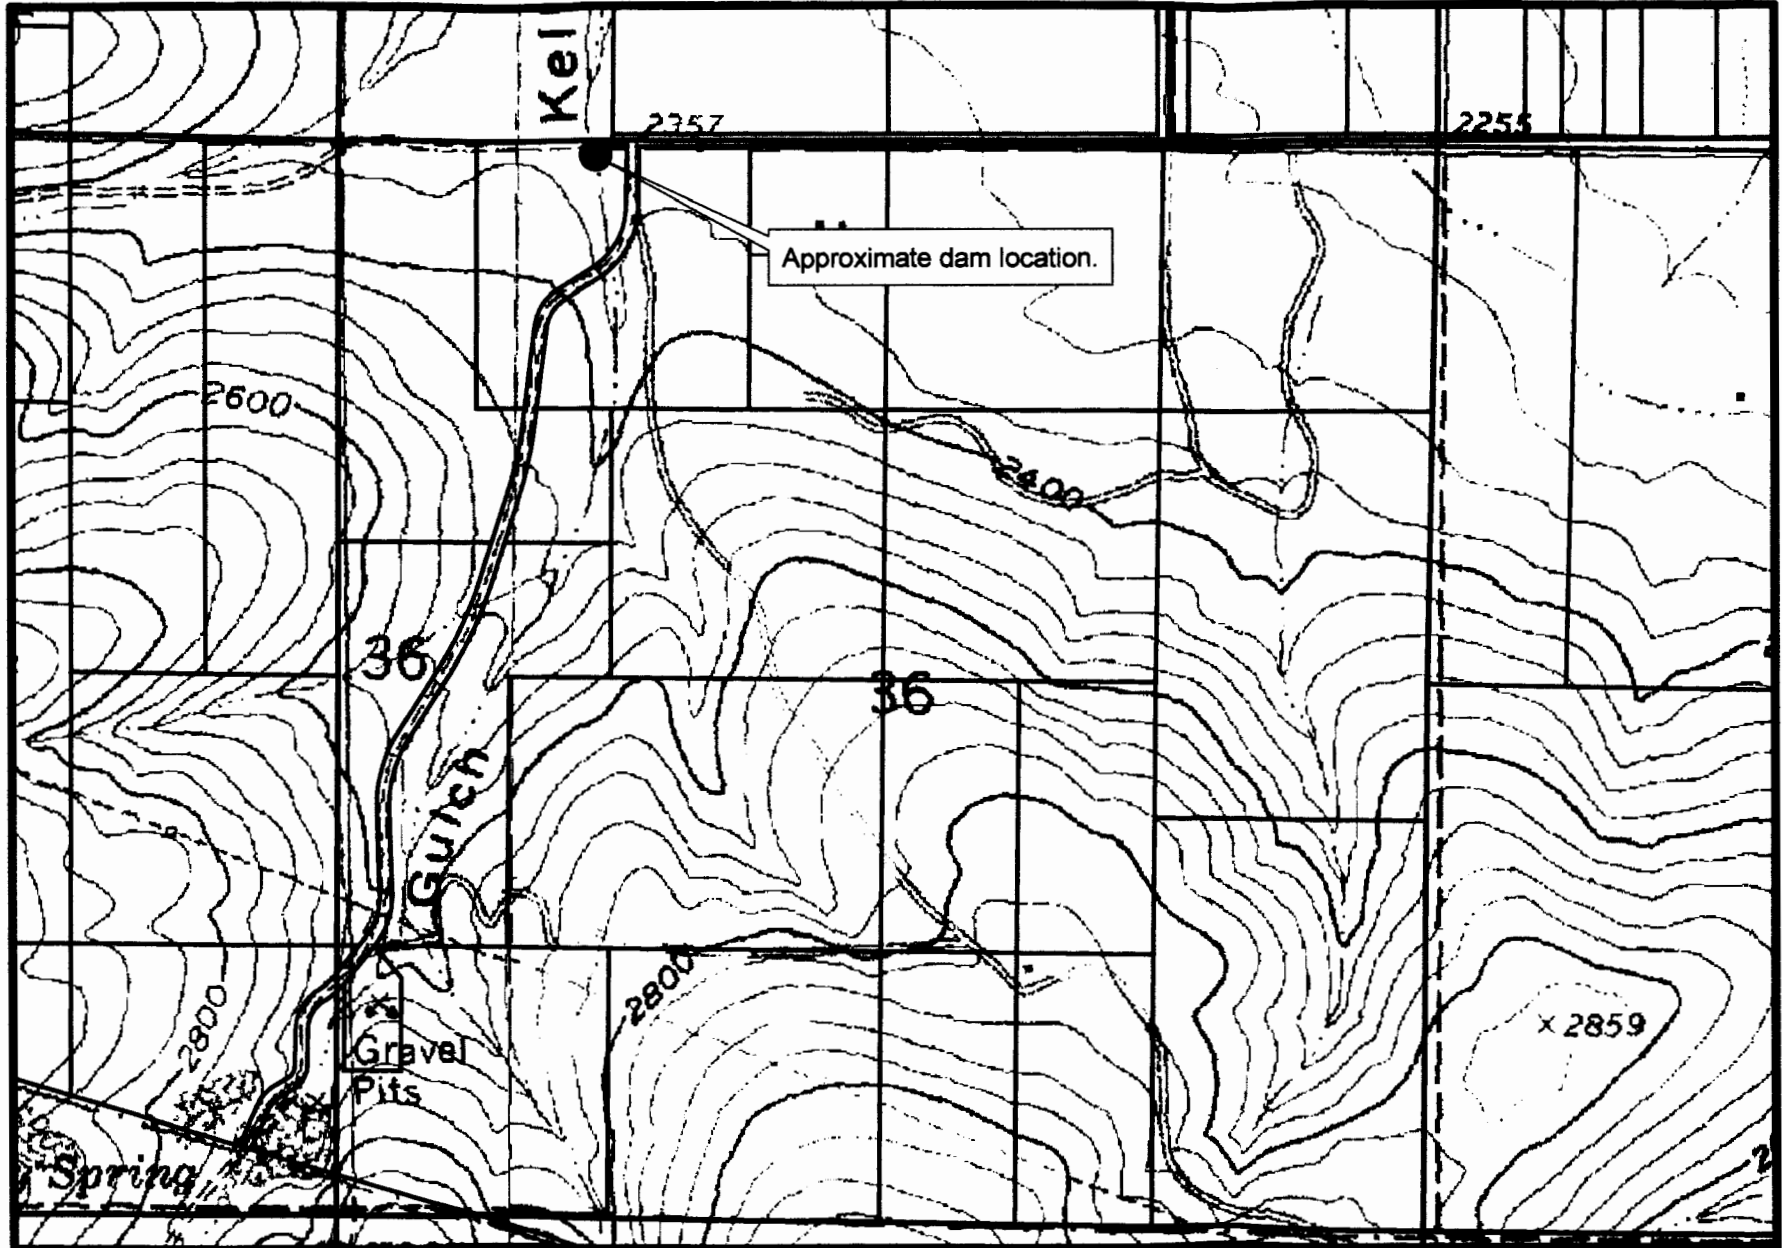

The water rights shown on this map have been interpreted by the District 3 Watermaster from information in the Department's files and are intended to represent that interpretation graphically. Locations shown are only approximate.

RECEIVED BY OWRD

MAY 18 2015

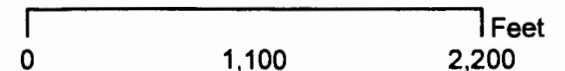

SALEM, OR