


VICINITY MAP

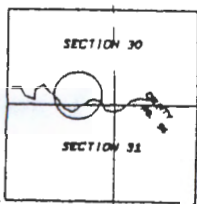

NOT TO SCALE



← FOREST SERVICE →

TAX LOT 101
SECTION 30 TOWNSHIP 15S
RANGE 11W

INTAKE

WATER
1" LINE

CABIN

TAX LOT 101

N.87°37'06"E.

1333.61

COUNTY

WELL
R SHOP

BARN

1/4
CORNER

INTAKE:

100' EAST

380' NORTH

OF QUARTER
CORNER

WELL:

15' SOUTH

240' WEST

of QUARTER
CORNER

TAX LOT 704

SECTION 31 TOWNSHIP 15S RANGE 11W

PARCEL 1

± 34 ACRES

N.87°17'52"W
1253.67

N.0°23'29"W
1300.55

RECEIVED

MAY 27 2015

WATER RESOURCES DEPT
SALEM, OREGON

PARCEL 1

GOVERNMENT LOT 1 OF
SECTION 31, T.15S, R.11W, W.M.,
EXCEPT THAT PORTION LAYING
NORTH OF COUNTY ROAD NO. 903.


N.88°20'43"E.

1335.23

1" = 200'

S-88092

VICINITY MAP

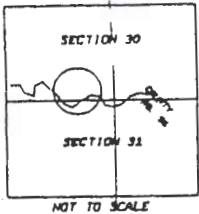

← FOREST SERVICE →

TAX LOT 101
SECTION 30 TOWNSHIP 15S
RANGE 11W

INTAKE

CABIN

TAX LOT 101

WELL
K SHOP

1/4
CORNER

N.87°37'06"E.

1333.61

COUNTY

BARN

WELL:
15' SOUTH
240' WEST
of QUARTER
CORNER

INTAKE:
100' EAST
380' NORTH
of QUARTER
CORNER

TAX LOT 704

SECTION 31 TOWNSHIP 15S RANGE 11W

PARCEL 1

± 34 ACRES

N.87°17'52"W
1283.67

N.0°23'29"W
1300.55

RECEIVED

MAY 27 2015

WATER RESOURCES DEPT
SALEM, OREGON

PARCEL 1

GOVERNMENT LOT 1 OF
SECTION 31, T.15S, R.11W, W.M.,
EXCEPT THAT PORTION LAYING
NORTH OF COUNTY ROAD NO. 903.

N.88°20'43"E.


1335.23

1" = 200'

LANE COUNTY — MID-COAST BASIN

S-88092

VICINITY MAP

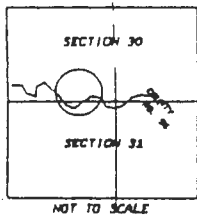

RECEIVED

MAY 27 2015

WATER RESOURCES DEPT
SALEM, OREGON

← FOREST SERVICE →

TAX LOT 101
SECTION 30 TOWNSHIP 15S
RANGE 11W

INTAKE

100' EAST
380' NORTH
of QUARTER
CORNER

26681 BY GARY W. HICKMAN
PLS. #147B

N.87°37'06"E.
1333.61'

COUNTY

BARN

SHOP

WELL

1/4 CORNER

WELL:
15' SOUTH
240' WEST
of 1/4 CORNER

TENMILE CREEK

PARCEL 1
± 34 ACRES

TAX LOT 704

SECTION 31 TOWNSHIP 15S RANGE 11W

TAX LOT 705

APPROVED FOR RECORDING
DATE 6-14-88 Lane County
Rick Thomas
LAND MANAGEMENT DIVISION

REGISTERED
PROFESSIONAL
LAND SURVEYOR

REGON
JUN 15 1988
RICK SKINNER

N.88°20'43"E.
1335.23'

N.88°19'52"E.
1314.04'

PARCEL DESCRIPTIONS
PARCEL 1

GOVERNMENT LOT 1 OF
SECTION 31, T.15S, R.11W, W.M.,
EXCEPT THAT PORTION LAYING
NORTH OF COUNTY ROAD NO. 303.

FINAL PART

STEVEN

IN S.E. 1/4 & N.W. 1/4, SECTION 31, T.15S, R.11W, W.M.,
LANE COUNTY

SCALE = 1" = 400 FEET


1988

RICHARD S. SKINNER
PROFESSIONAL LAND SURVEYOR
25031 LAVELL ROAD
JUNCTION CITY, OREGON 97448
(503) 529-2453

1" = 400'

LANE COUNTY MID-COAST BASIN


88092

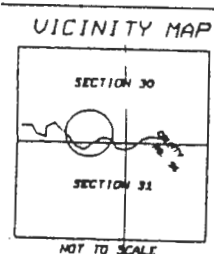


RECEIVED

MAY 27 2015

WATER RESOURCES DEPT
SALEM, OREGON

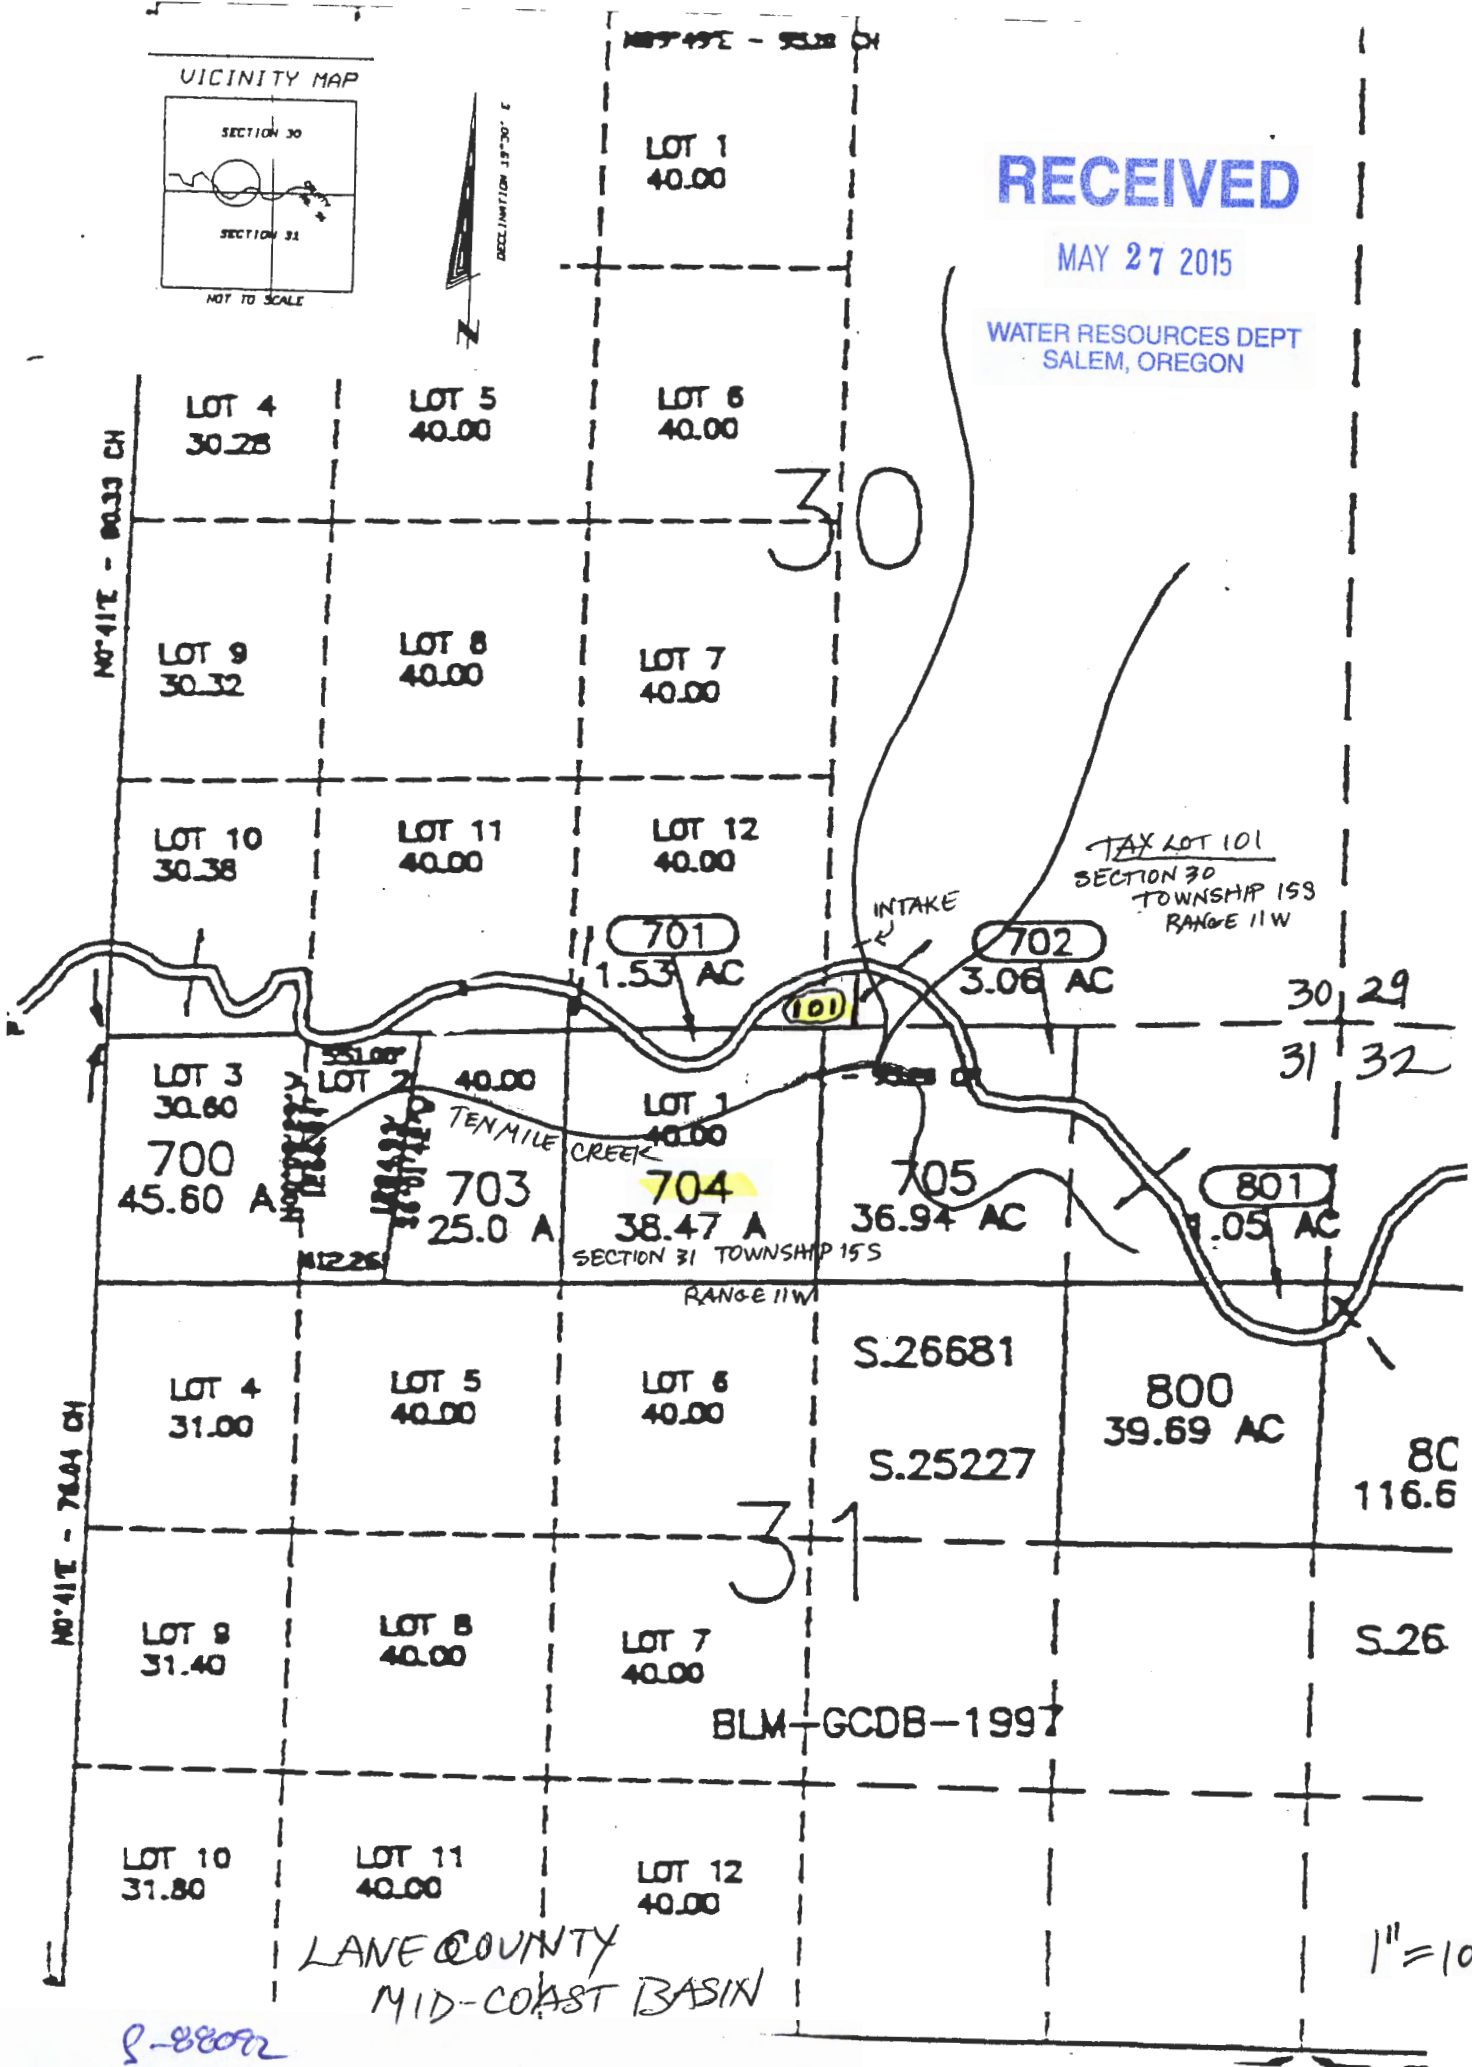

1"=1000'

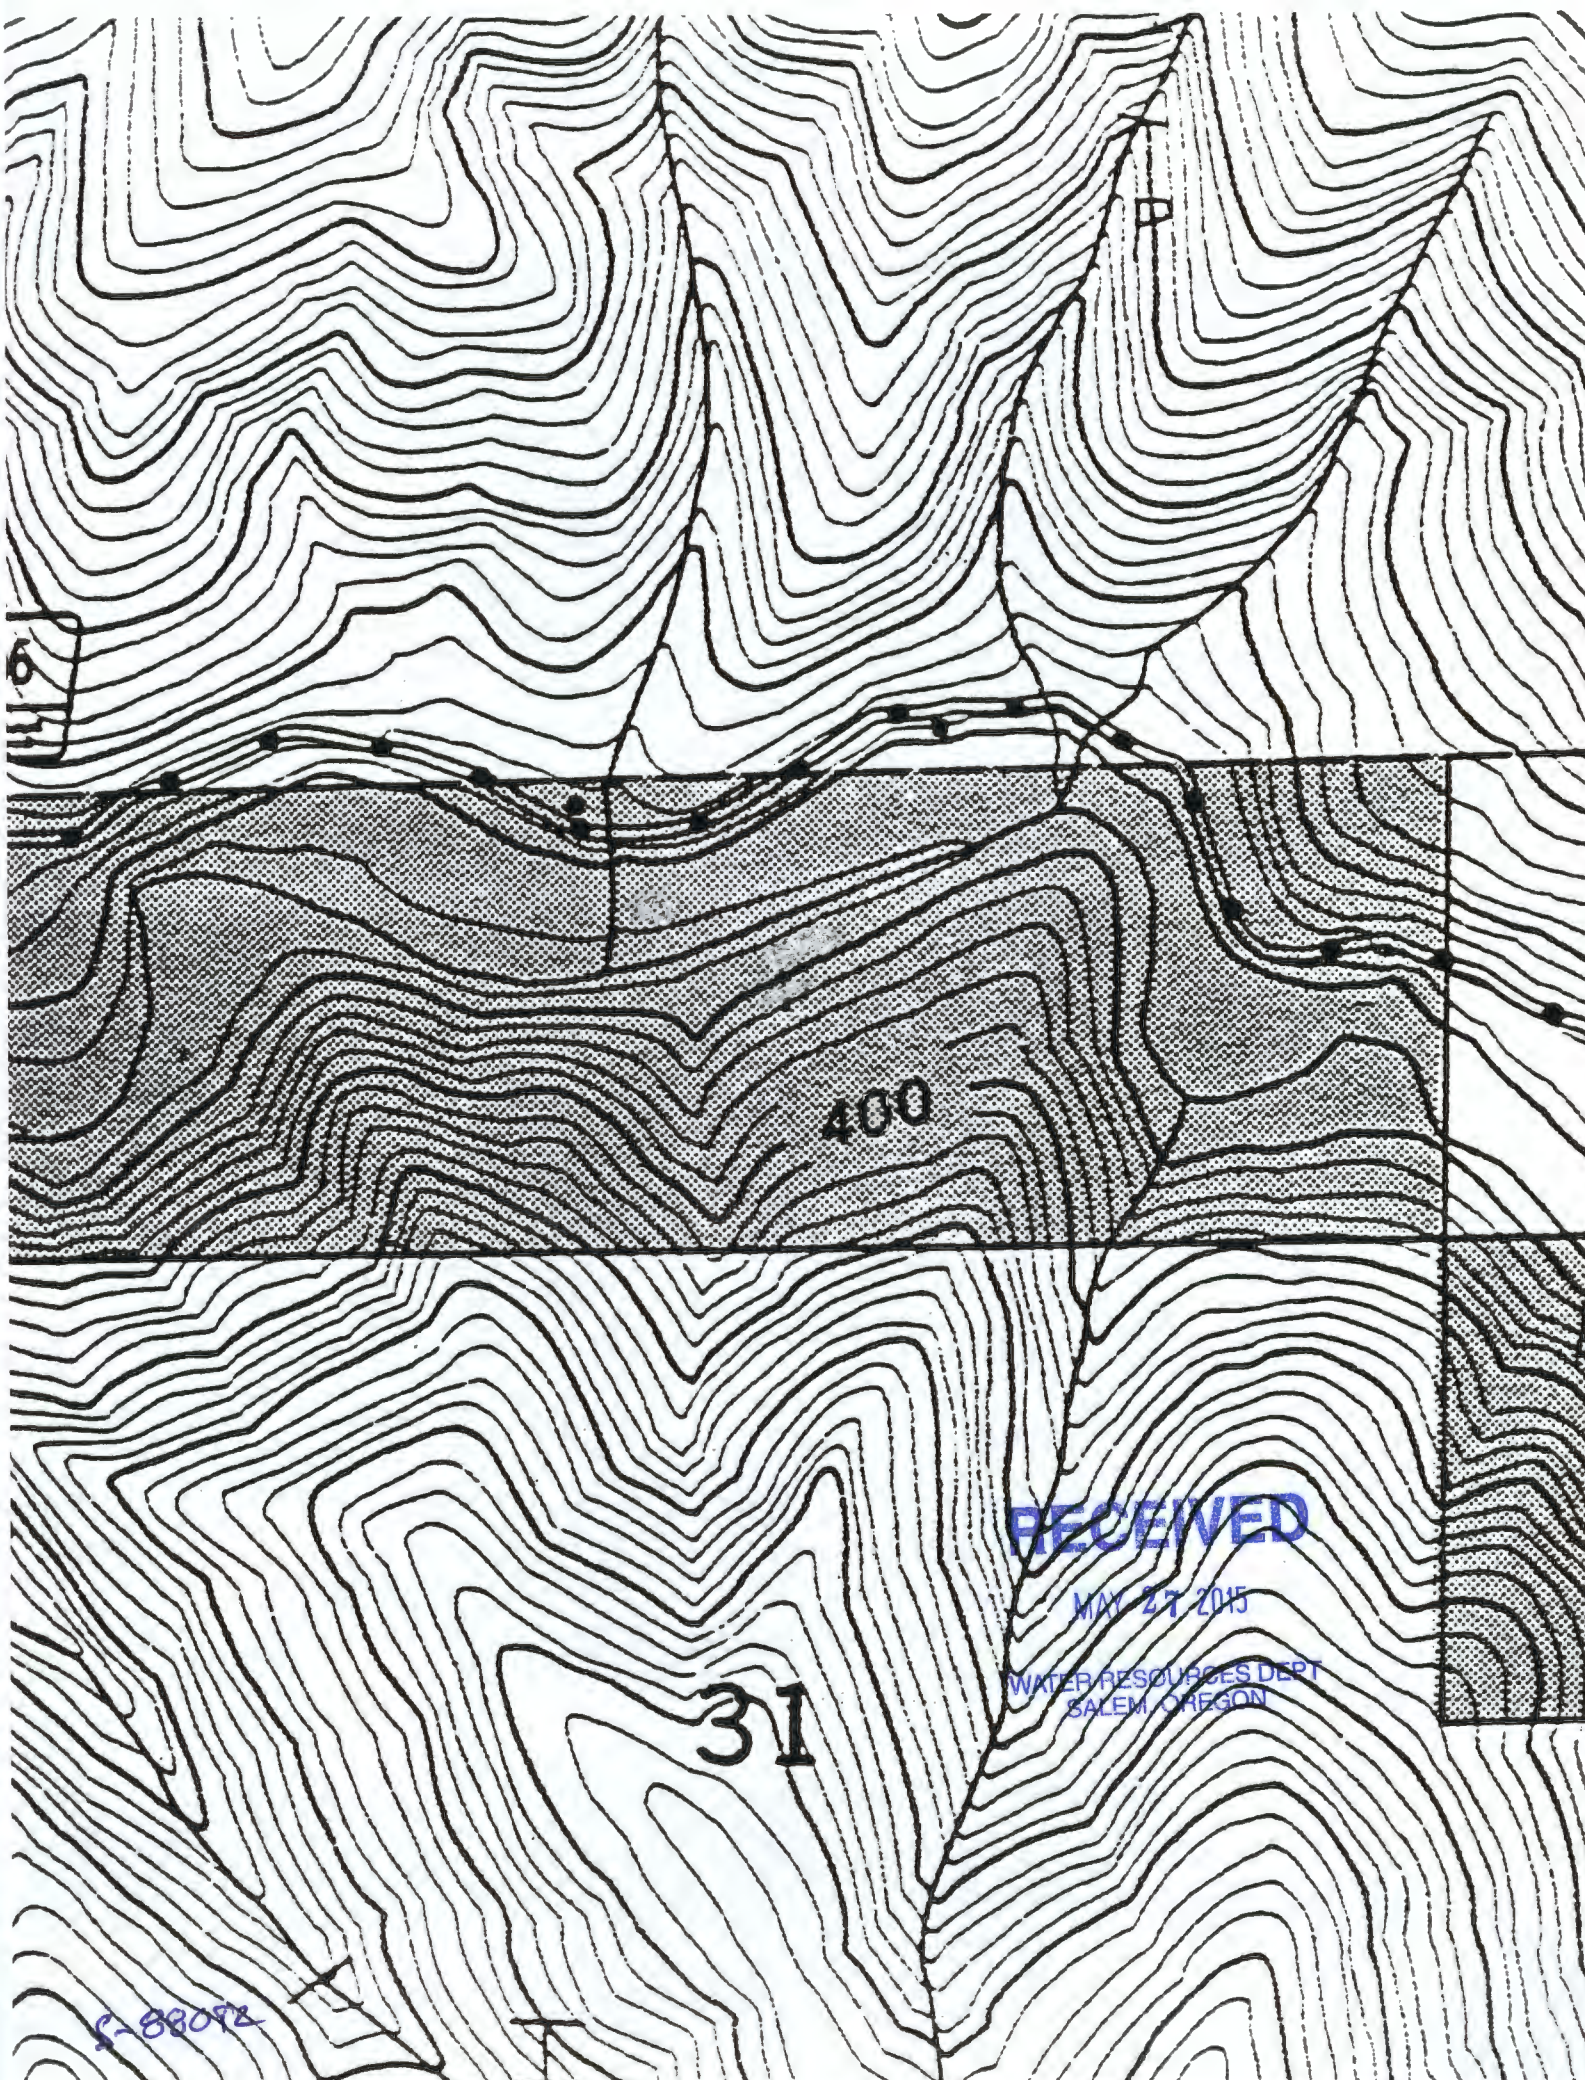

400

31

RECEIVED

MAY 27 2015

WATER RESOURCES DEPT
SALEM, OREGON

5-88092

6