

THIS MAP WAS PREPARED FOR
ASSESSMENT PURPOSE ONLY




SECTION 12 T.1N. R.40E. W.M.
UNION COUNTY
1" = 400'

map is not to scale
Reference only

01N40E12

CANCELLED.
301
500

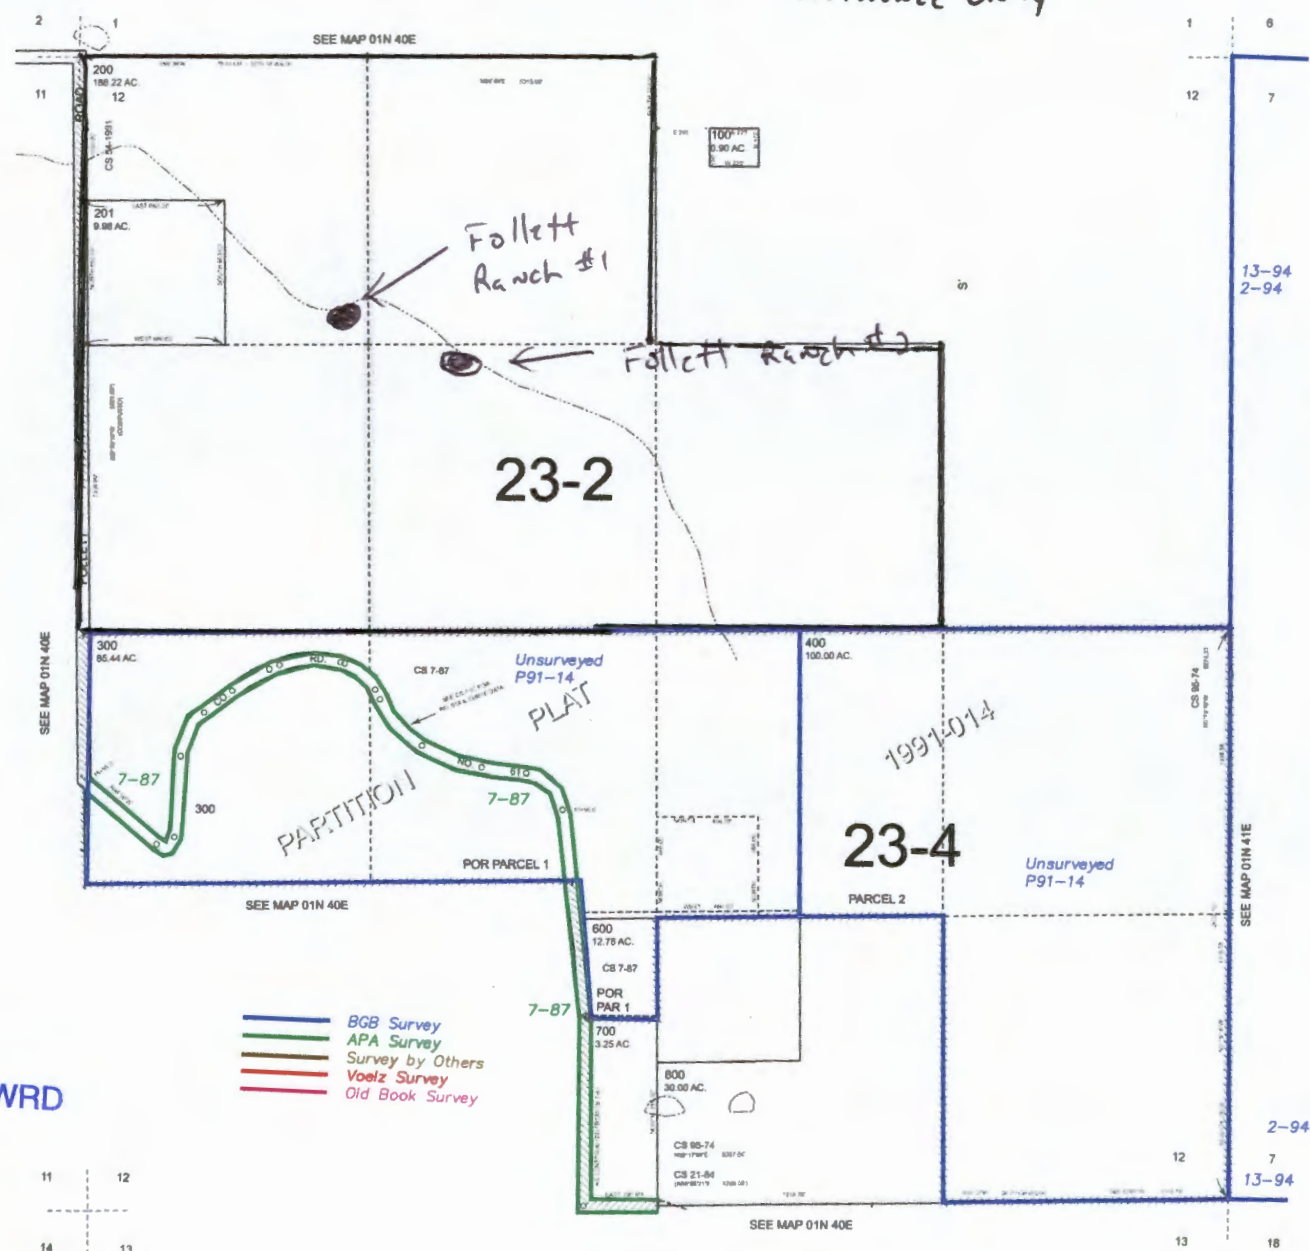

RECEIVED BY OWRD

MAY 28 2015

SALEM, OR

Revised: SH
3/7/2011

01N40E12

R-88003



Google earth

feet
meters

1000

500

RECEIVED BY OWRD

MAY 28 2015

SALEM, OR



R-0000