LEGEND

LINE TYPES

TAX LOT BOUNDARY	OLD PROPERTY LINE
ROAD RIGHT-OF-WAY	VACATED RIGHT-OF-WAY
RAILROAD	RAILROAD RIGHT-OF-WAY
STREAM, LAKE, ETC. TAX LOT BOUNDARY	STREAM, LAKE, ETC. NON-BOUNDARY
SUBDIVISION BOUNDARY	PARTITION PLAT BDY.
TAX CODE BOUNDARY	EASEMENT

SYMBOL TYPES

D.L.C.

CONTROL POINTS

SURVEY MONUMENTS

G.L.O. CORNERS

SECTION 1/4 SEC 1/16 SEC

NUMBERS

TAX CODE NO.

000 00 00 0

ACREAGE – ALL ACREAGES EXCLUDE ANY PORTION THAT MAY LIE WITHIN THE INDICATED PUBLIC RIGHT OF WAYS.

TICK MARKS – WHEN A TICK MARK IS INDICATED ON THE EXTENSION OF A LINE, THEN THE DIMENSION GOES TO THE TICK MARK. GENERALLY THIS IS USED WHEN DIMENSIONS GO INTO PUBLIC RIGHT OF WAYS.

ARROWS ARE USED WITH DIMENSIONS IN AREAS OF GREATER COMPLEXITY.

NOTICE: This map was created for Assessor's Office use ONLY.

Assessor "We Care" GIS Geographic Information System

Irrigated Area

SCALE 1" = 880' or 1:4800

Plot file created: May 19, 2007

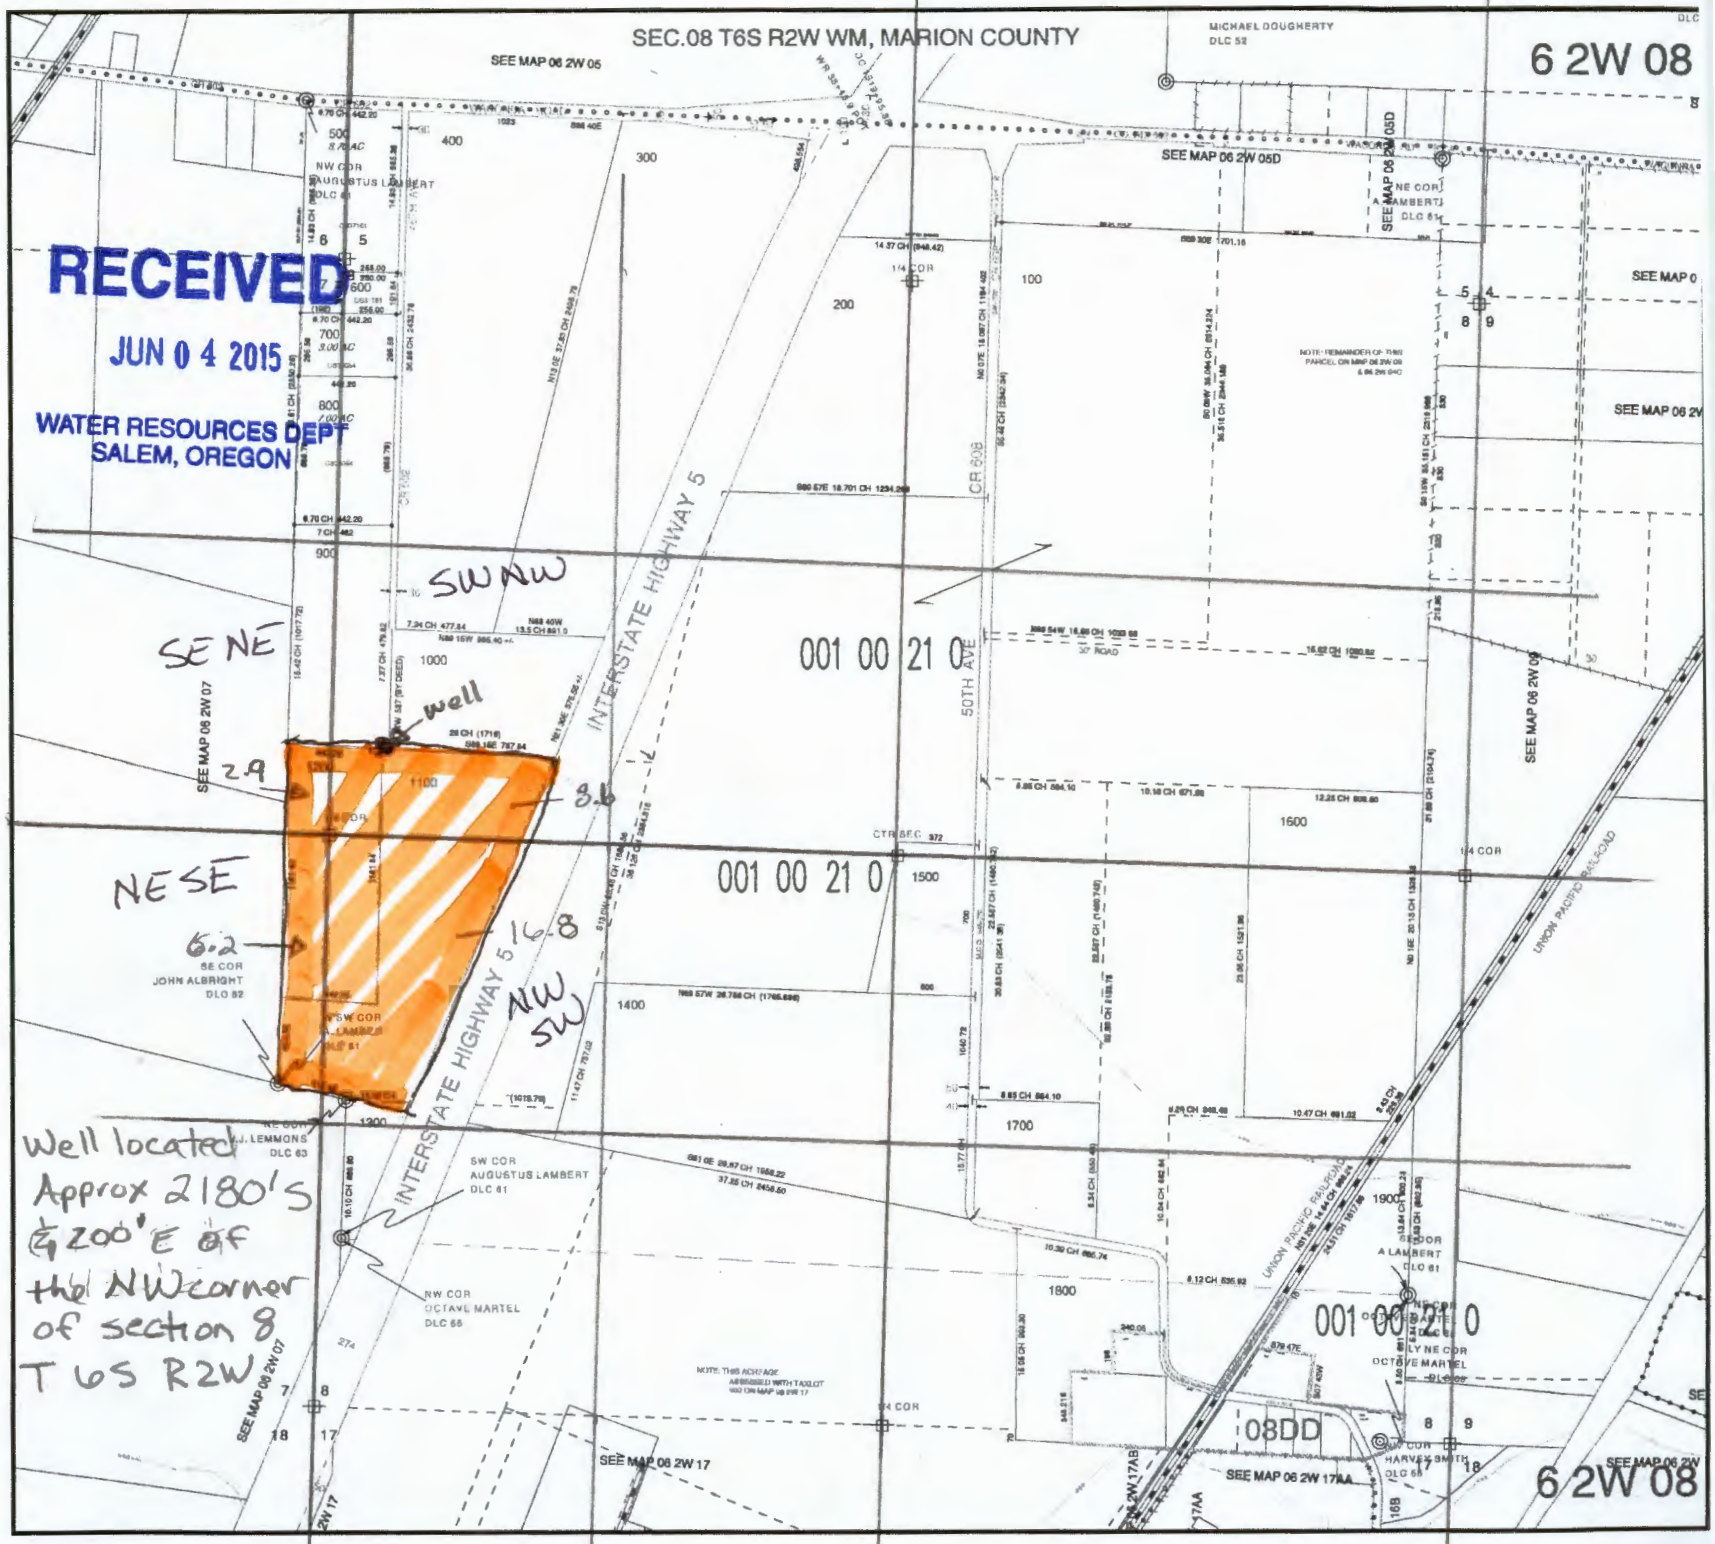

RECEIVED
JUN 0 4 2015
WATER RESOURCES DEPT
SALEM, OREGON

Well located Approx 2180'S & 200'E of the NW corner of section 8 T 6S R2W