


T.7S.R.4W., W.M.

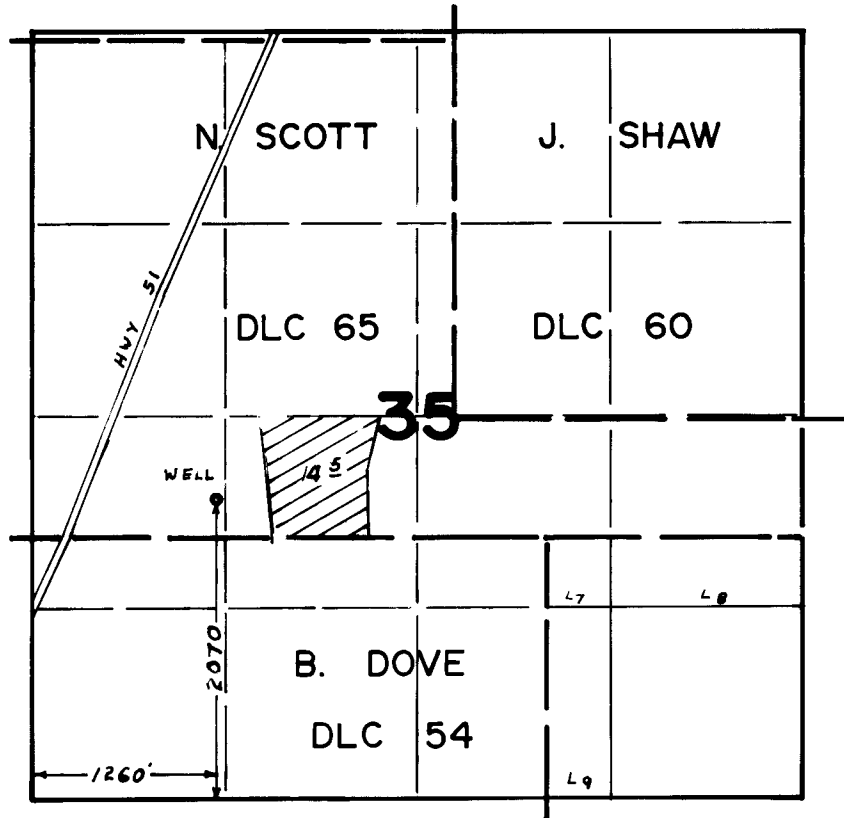


FINAL PROOF SURVEY UNDER

Application No. G-7848. Permit No. G-7725.
IN NAME OF

.....WALTER BROWN.....

Surveyed OCT. 13. 1978., by S.P. APPLGATE

T. 7 S. R. 4 W. W.M.

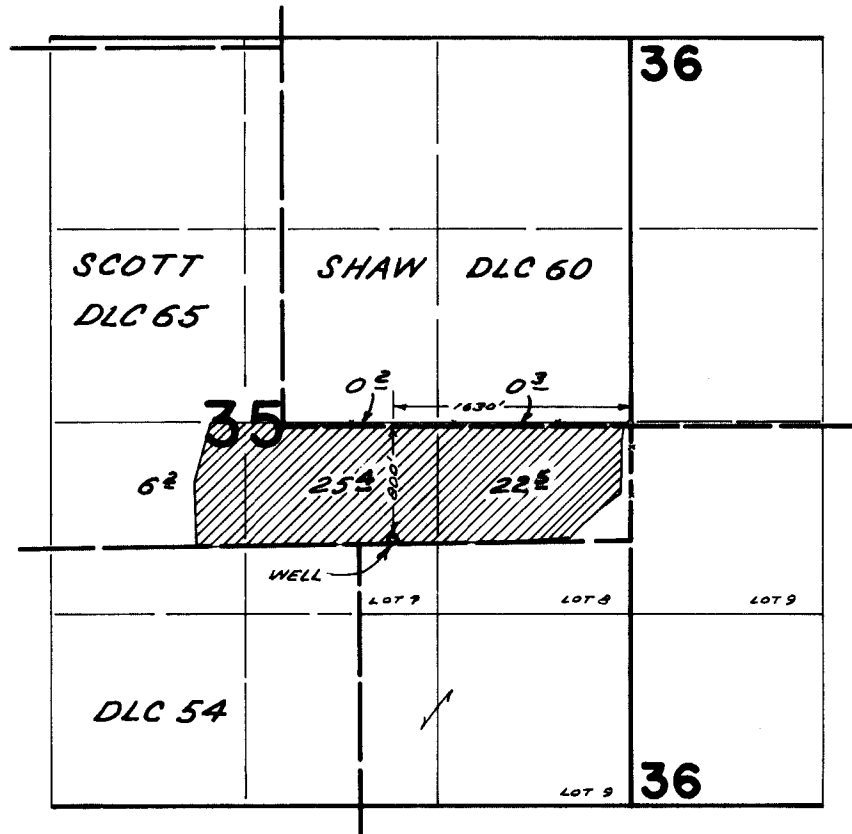

FINAL PROOF SURVEY UNDER

Application No. G-3541 Permit No. G-3331
IN NAME OF

WALTER BROWN

Surveyed Apr. 25 1969, by D. BUELL