


T38S R5W Sec32

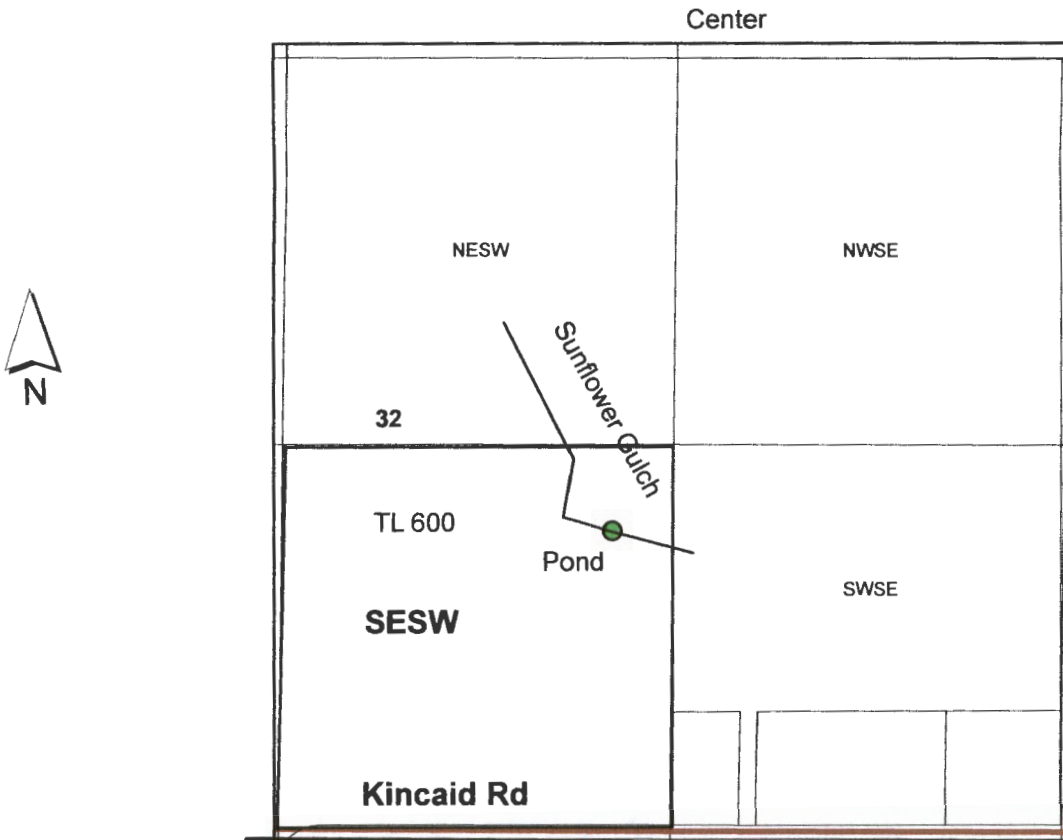

1 inch = 660 feet

Pond is 1646 ft south and 215 ft west from center Sec 32.

R-88087

RECEIVED BY OWRD
RECEIVED BY OWRD
JUN 01 2015
JUN 12 2015
SALEM, OR
SALEM, OR