


T. 4N

R. 34

R. 35

Application No. G-9009  
Permit No. G 8371

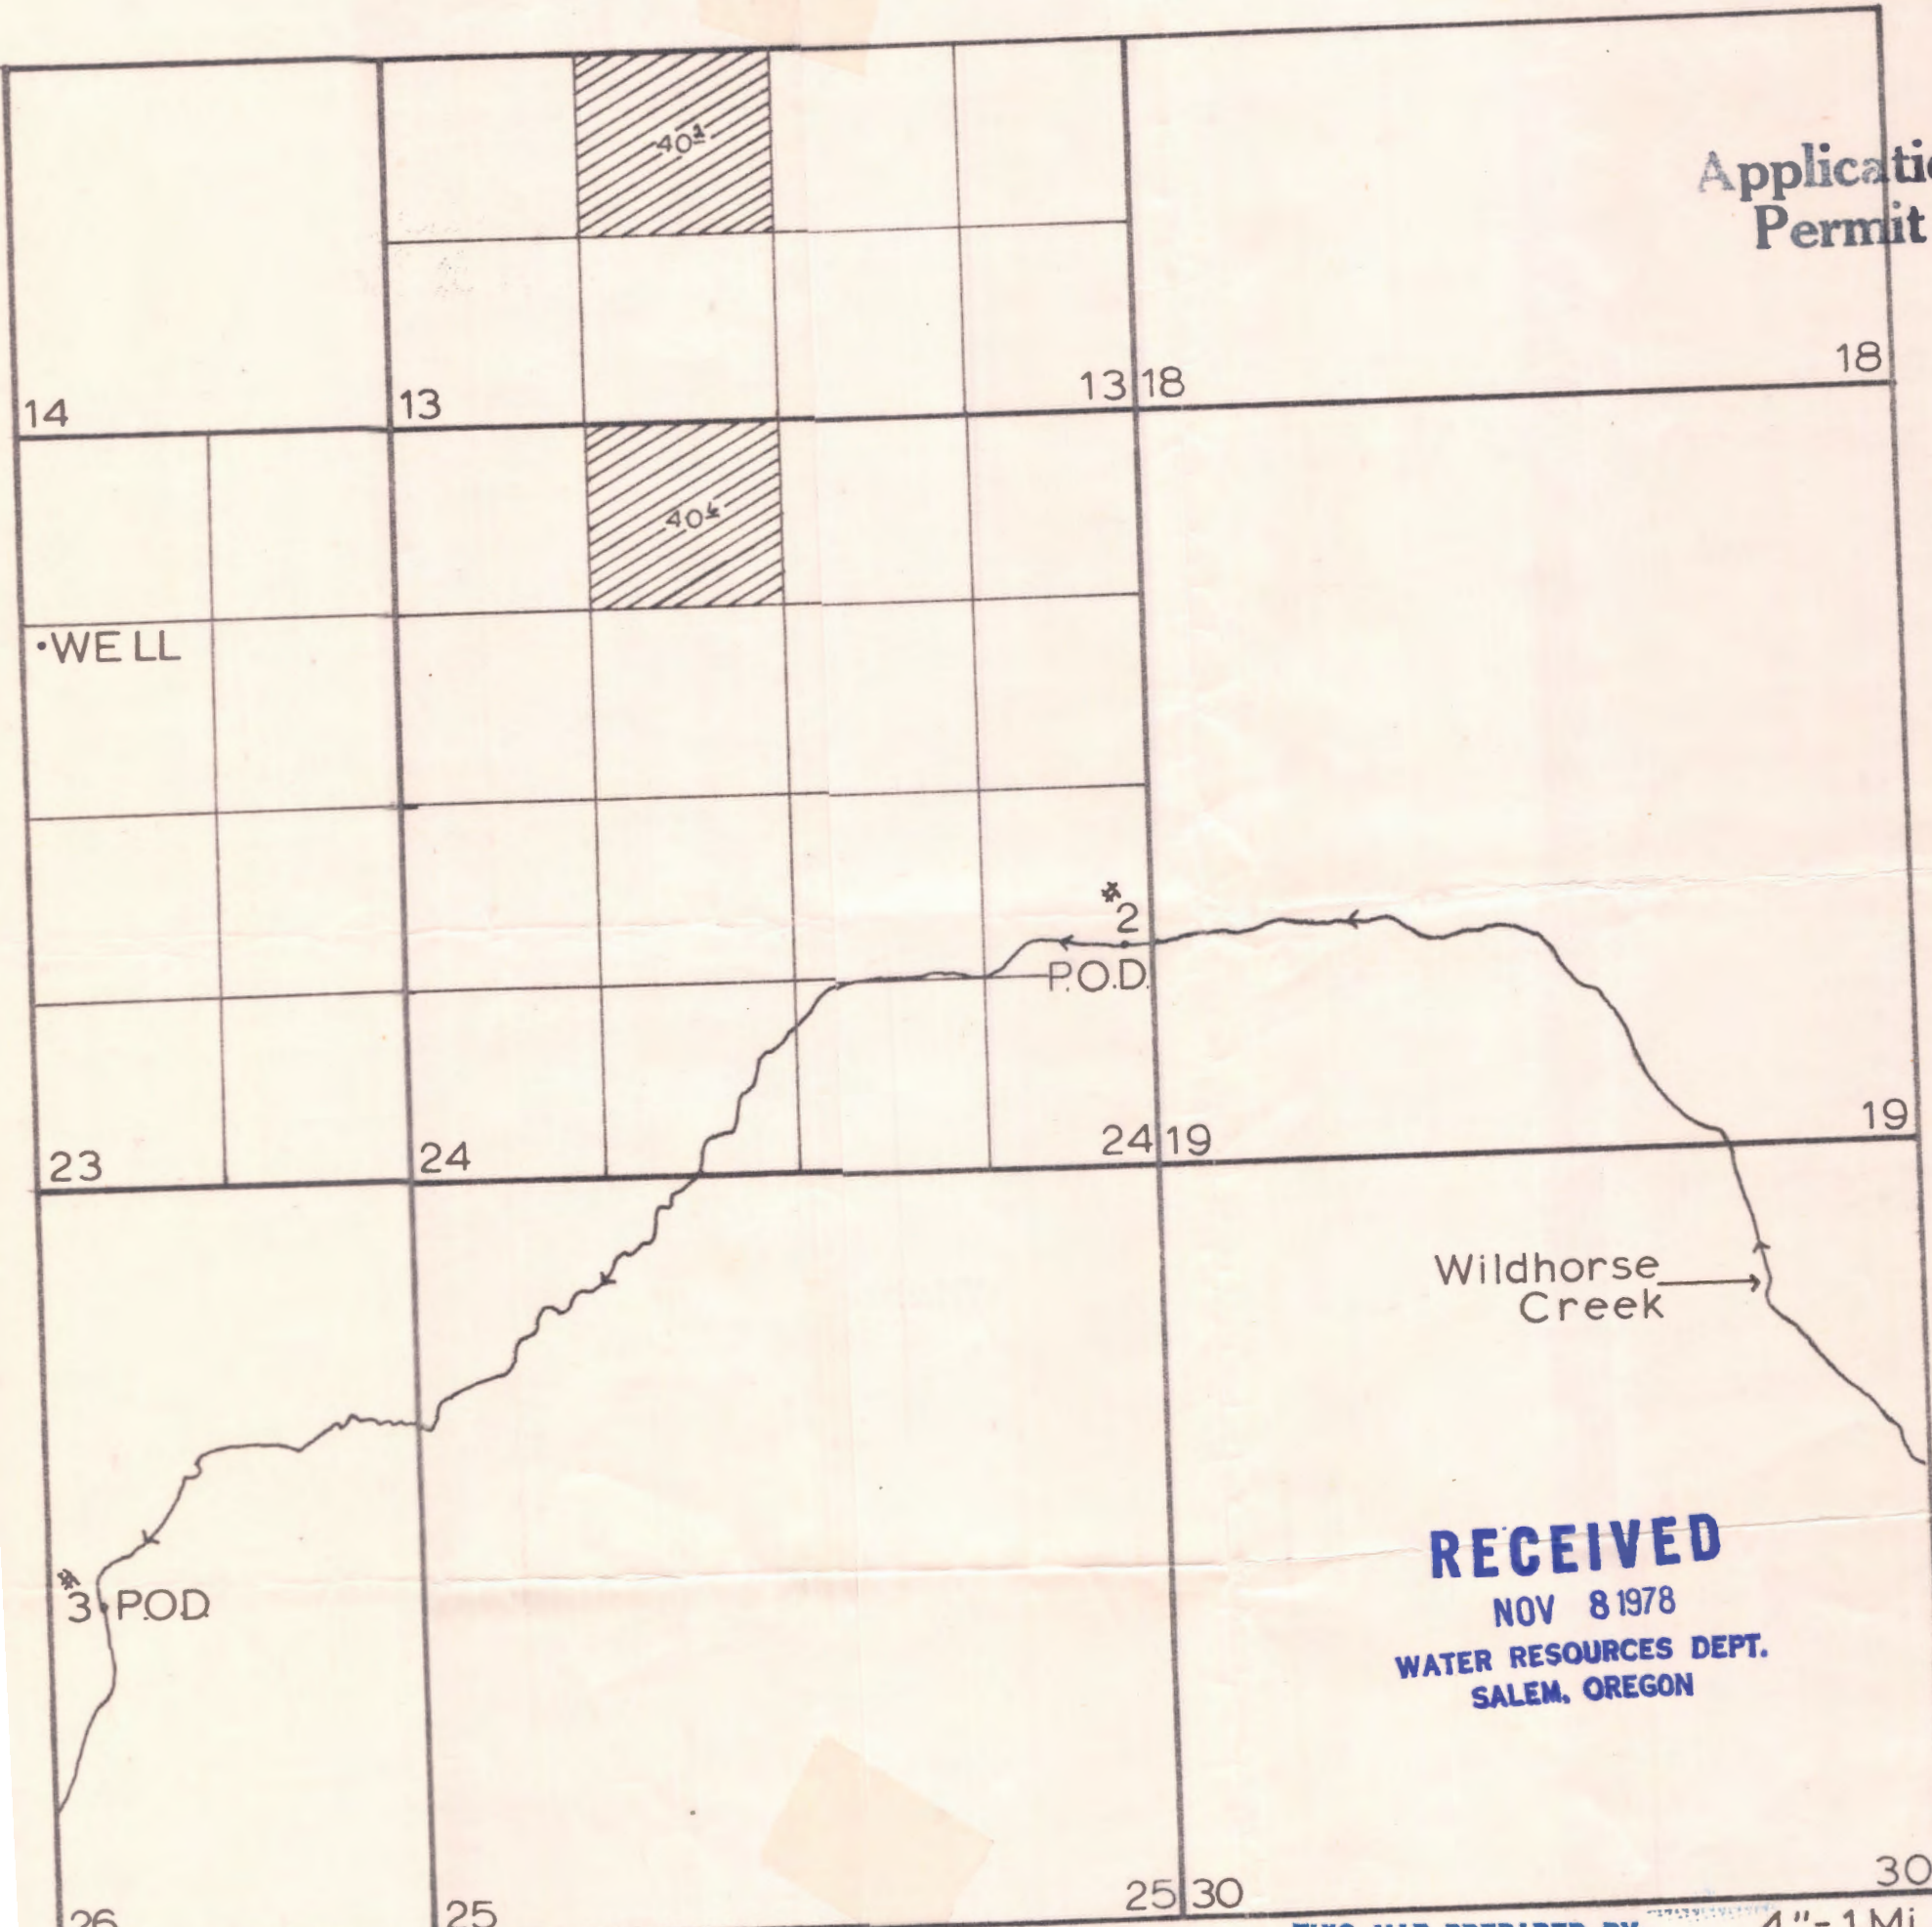

T.4N R.35E

**RECEIVED**  
NOV 8 1978  
WATER RESOURCES DEPT.  
SALEM, OREGON



WELL LOCATED 1240' N. & 100' E. FROM CENTER SEC 23  
 P.O.D. 1 LOCATED 300' S. & 1910' E. FROM CENTER SEC 32  
 P.O.D. 2 LOCATED 1550' N. & 200' W. FROM SE COR SEC 24  
 P.O.D. 3 LOCATED 2400' N. & 390' E. FROM SW COR SEC 26

THIS MAP PREPARED BY: Jerry Holcomb 4" = 1 Mi.  
 FROM INFORMATION FURNISHED BY THE APPLICANT.