


SECTION 18, T4S R5W W.M.
YAMHILL COUNTY

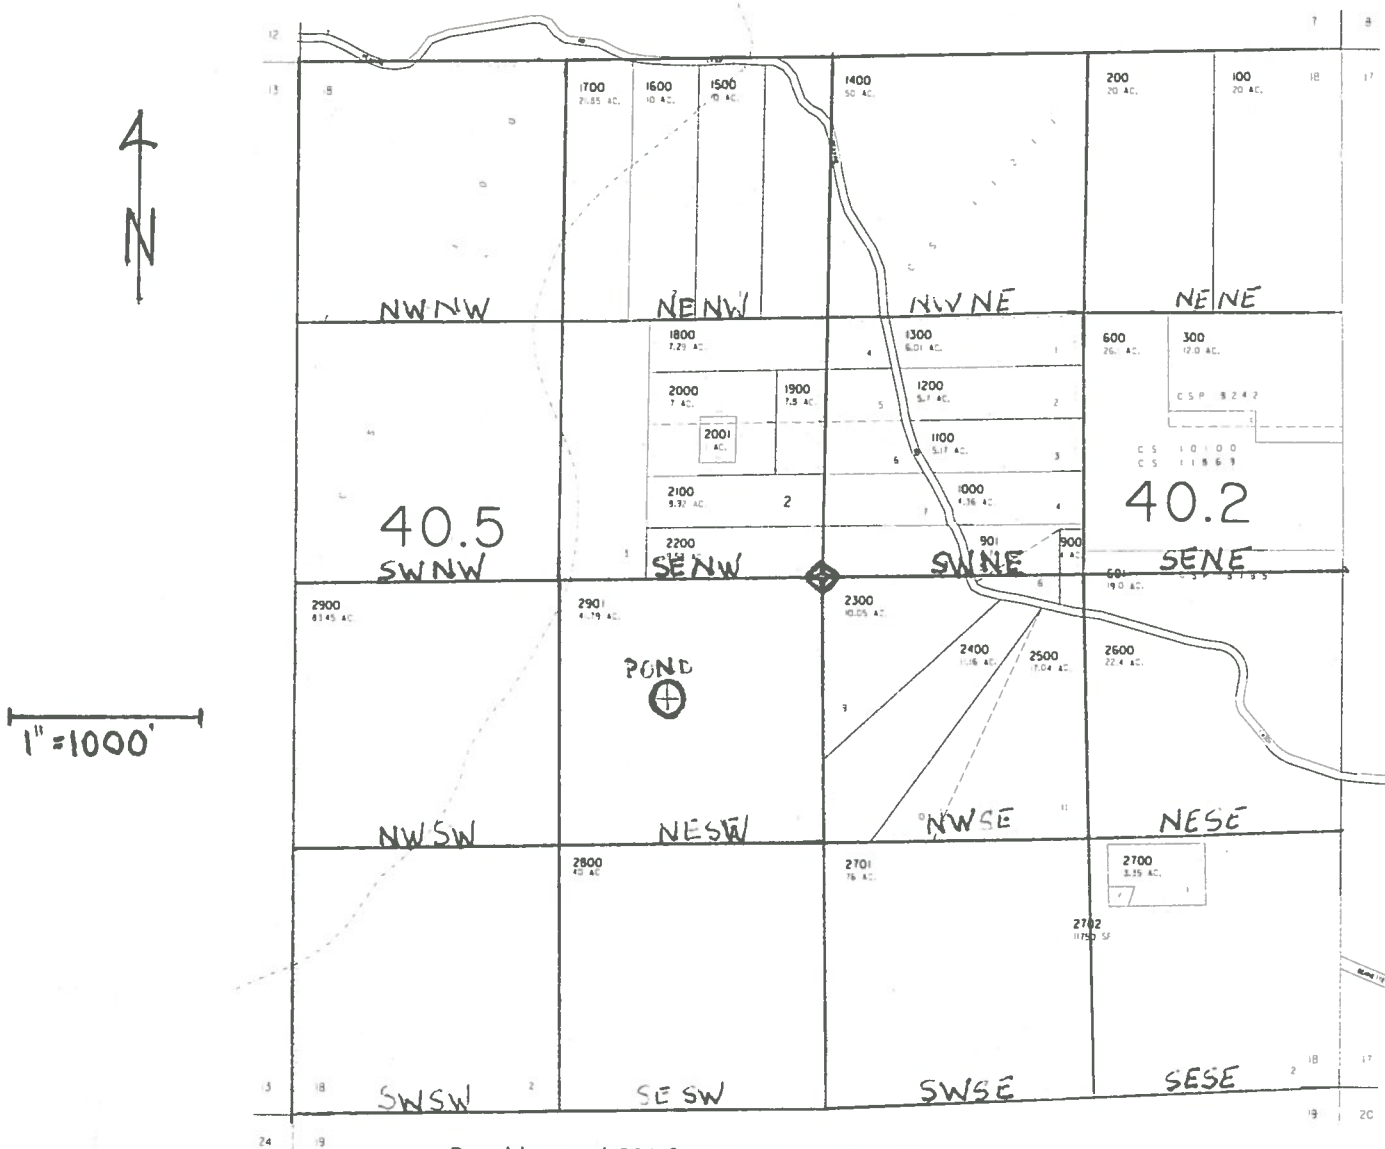

Pond located 600 feet South and 800 feet West
from the center of Section 18, Township 4 South, Range 5W

RECEIVED

JUN 25 2015


WATER RESOURCES DEPT
SALEM, OREGON

R-08104

R 4518

Yamhill County Map


- Boundaries
- Newberg ByPass
- Construction Phase 1
- Construction Phase 2
- Construction Phase 3
- Railroads
- Streams
- Taxlots
- right of ways
- taxlot lines
- taxlot polygons
- Taxlots History
- Townships
- Zoning

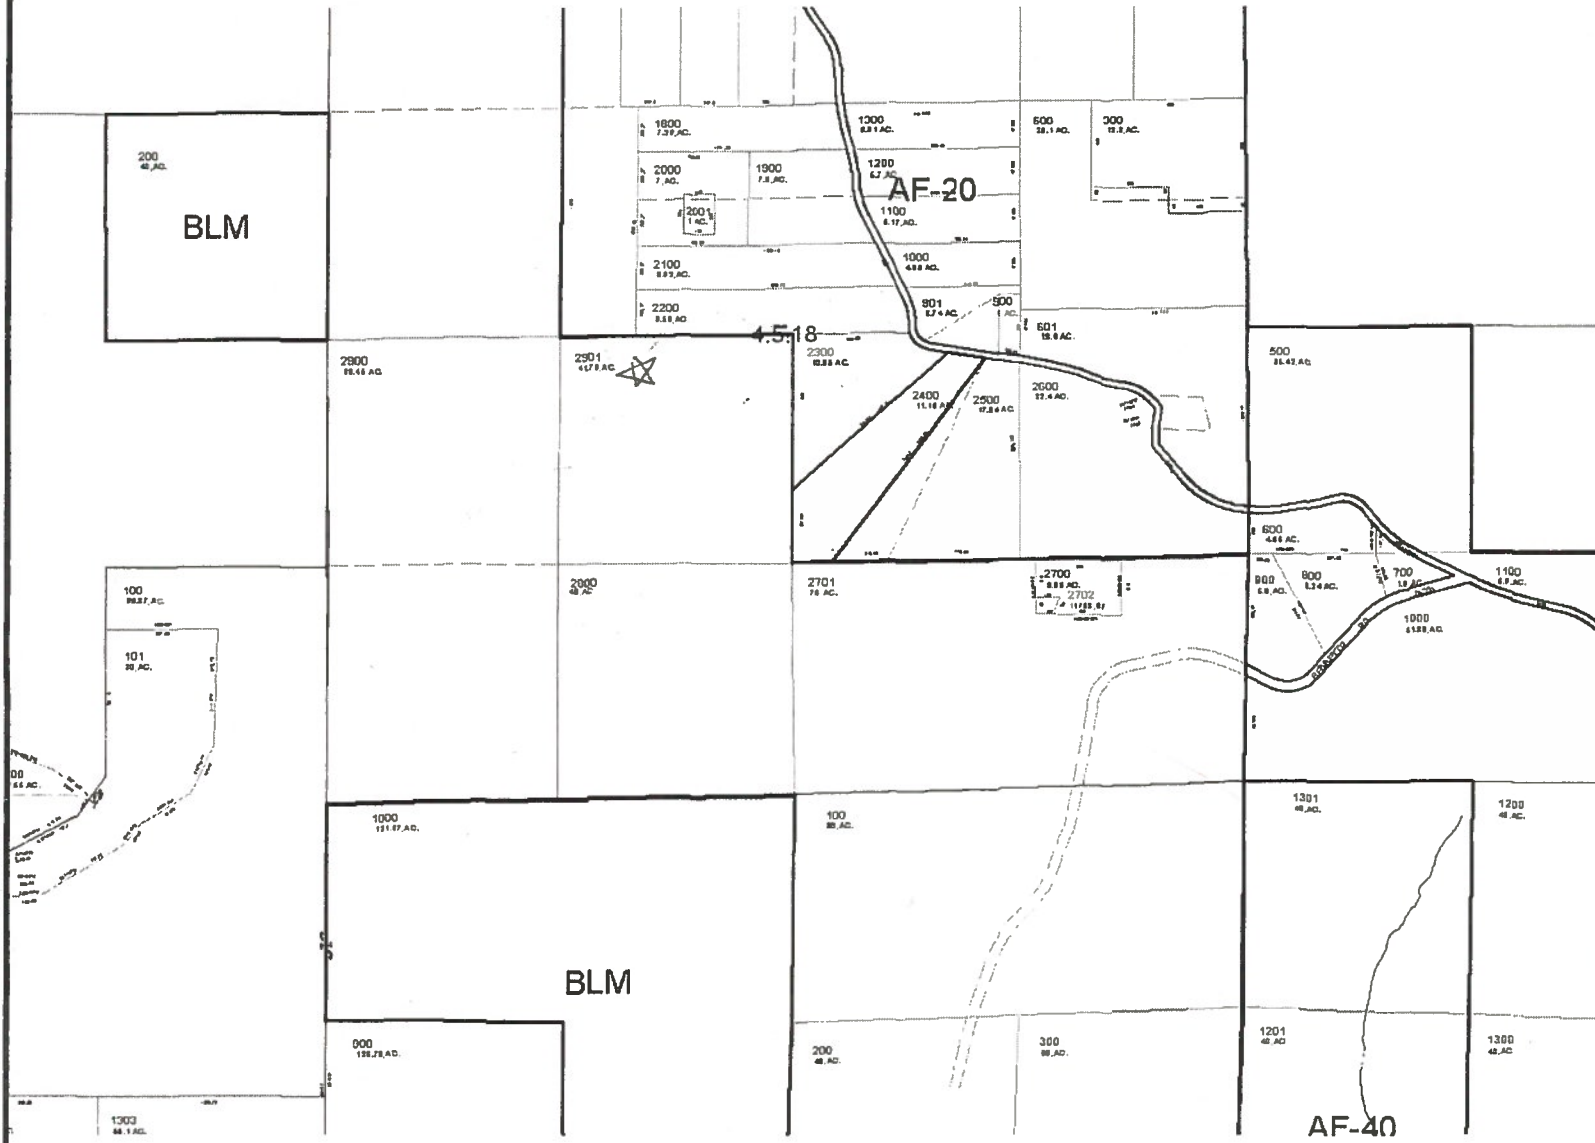

RECEIVED

JUN 25 2015

WATER RESOURCES DEPT
SALEM, OREGON

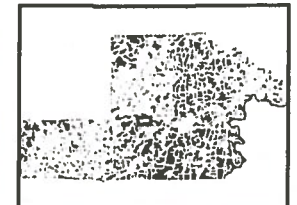

This map was produced using the Yamhill County GIS data. The GIS data is maintained by the county to support its governmental activities. The county is not responsible for map errors, omissions, misuse or misinterpretation.

1 in. = 1084 ft.



6/26/2006

