


RECEIVED

T. 17 S., R. 20 E., W.M.

AUG 04 2015

OWRD

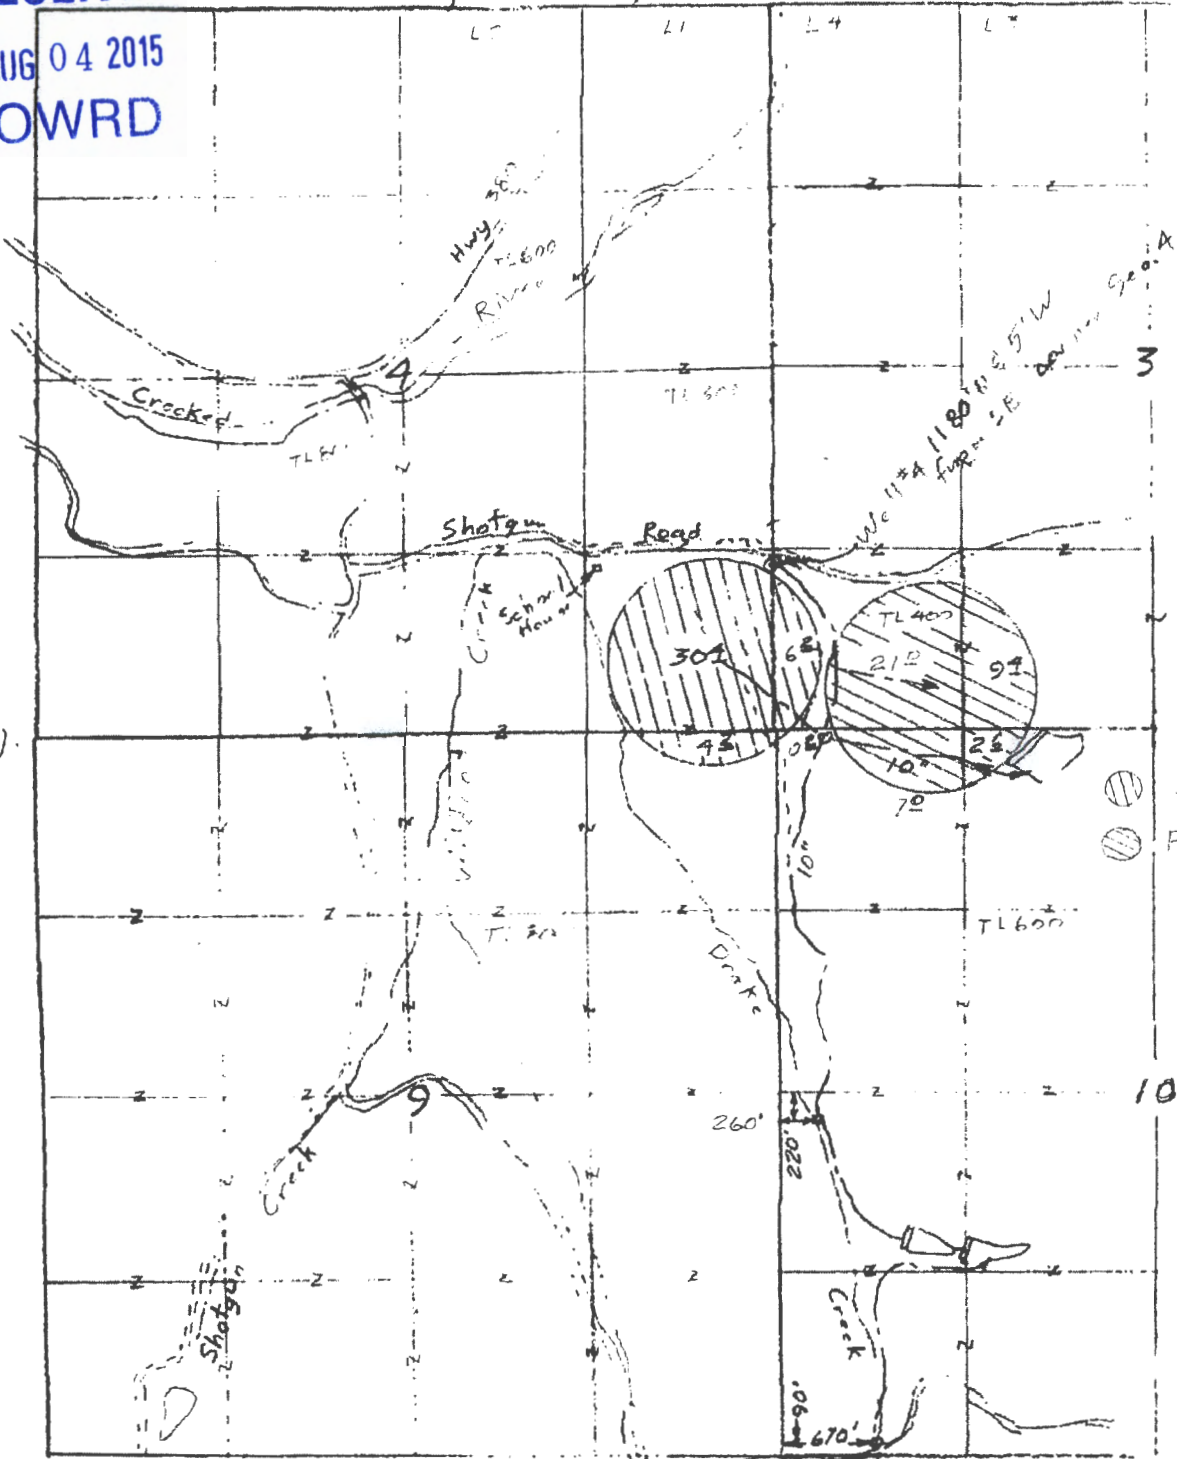


Scale
 1" = 1320'
 (4" = 1 mile)

Supp 41°
 Primary 40°

Application Map (Amended 8/4/15)
 for

Shotgun Ranch, LLC

This map is for the purpose of locating a water right only and has no intent to provide legal dimensions or the locator of property lines.

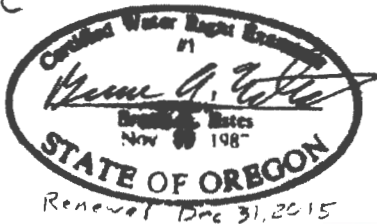

ESTES SURVEYS, LLC
 PO Box 17810 Salem, OR 97306-7518 (503) 695-7555
 60382 Arnold Rd Bend, OR 97702 (541) 382-7391

G-18112