


R-00100

RECEIVED BY OWRD

JUL 16 2015


SALEM, OR

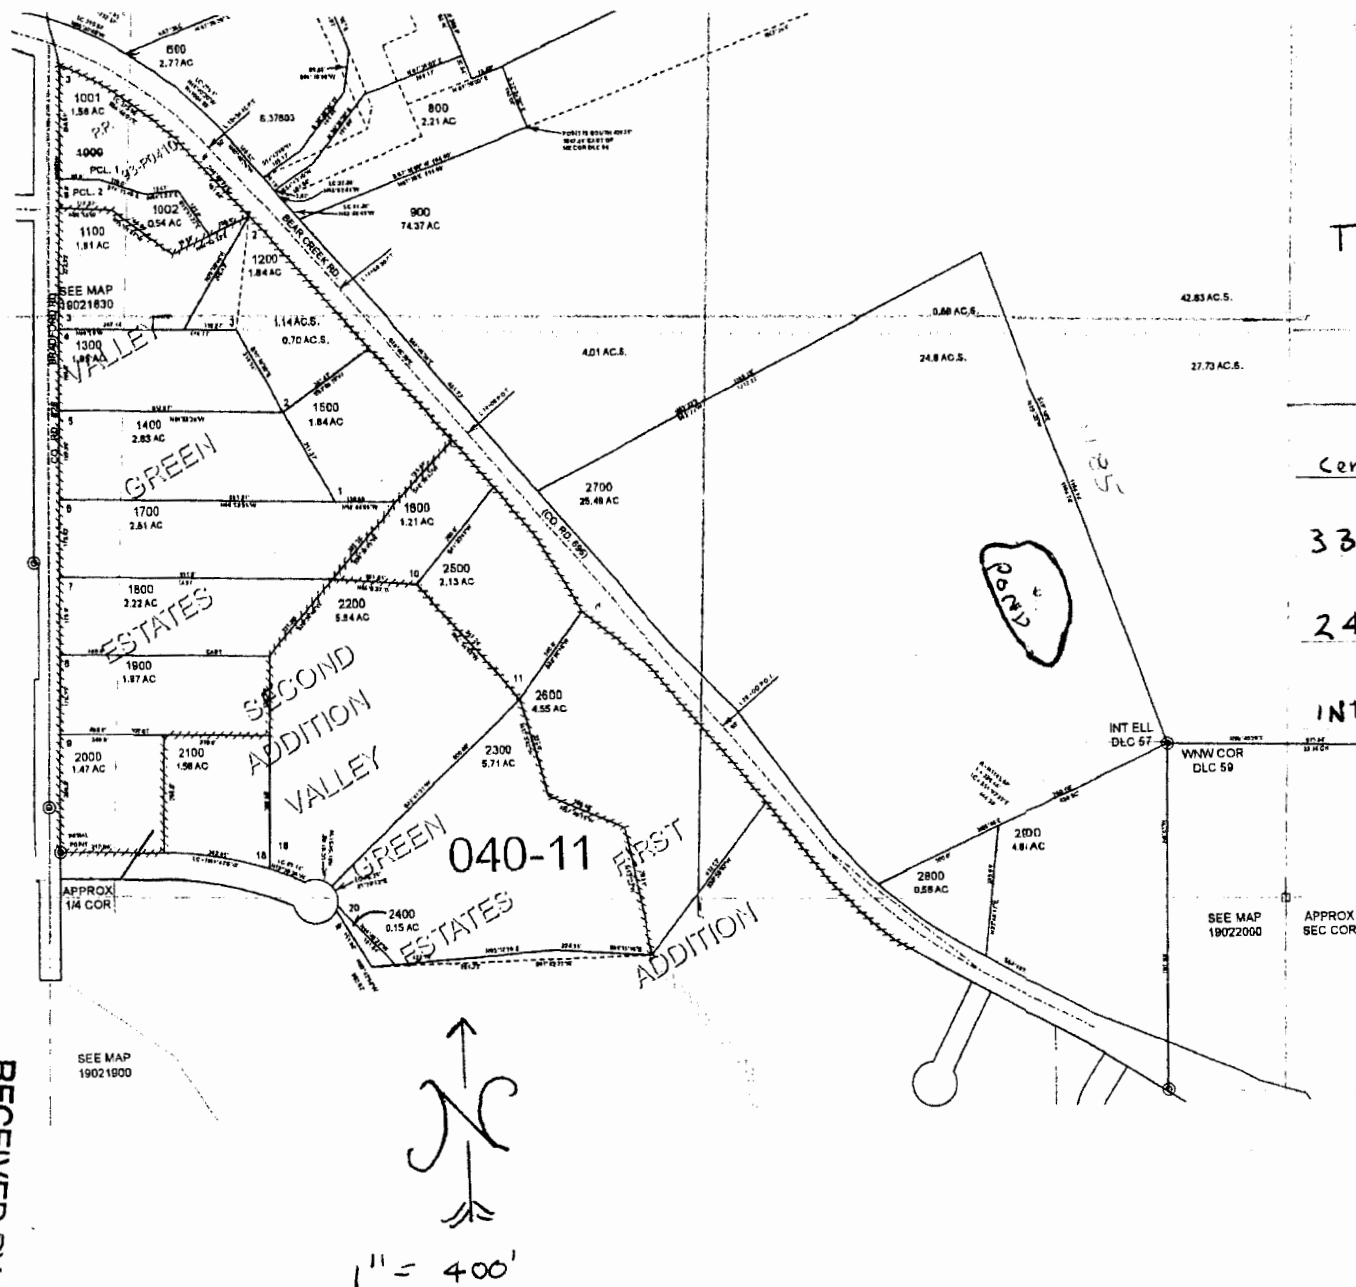

T19S, R2W Sec 18
SE 1/4 SE 1/4

center of Pond is
335 ft. North and
240 ft. West of

INT ELL DLC 57

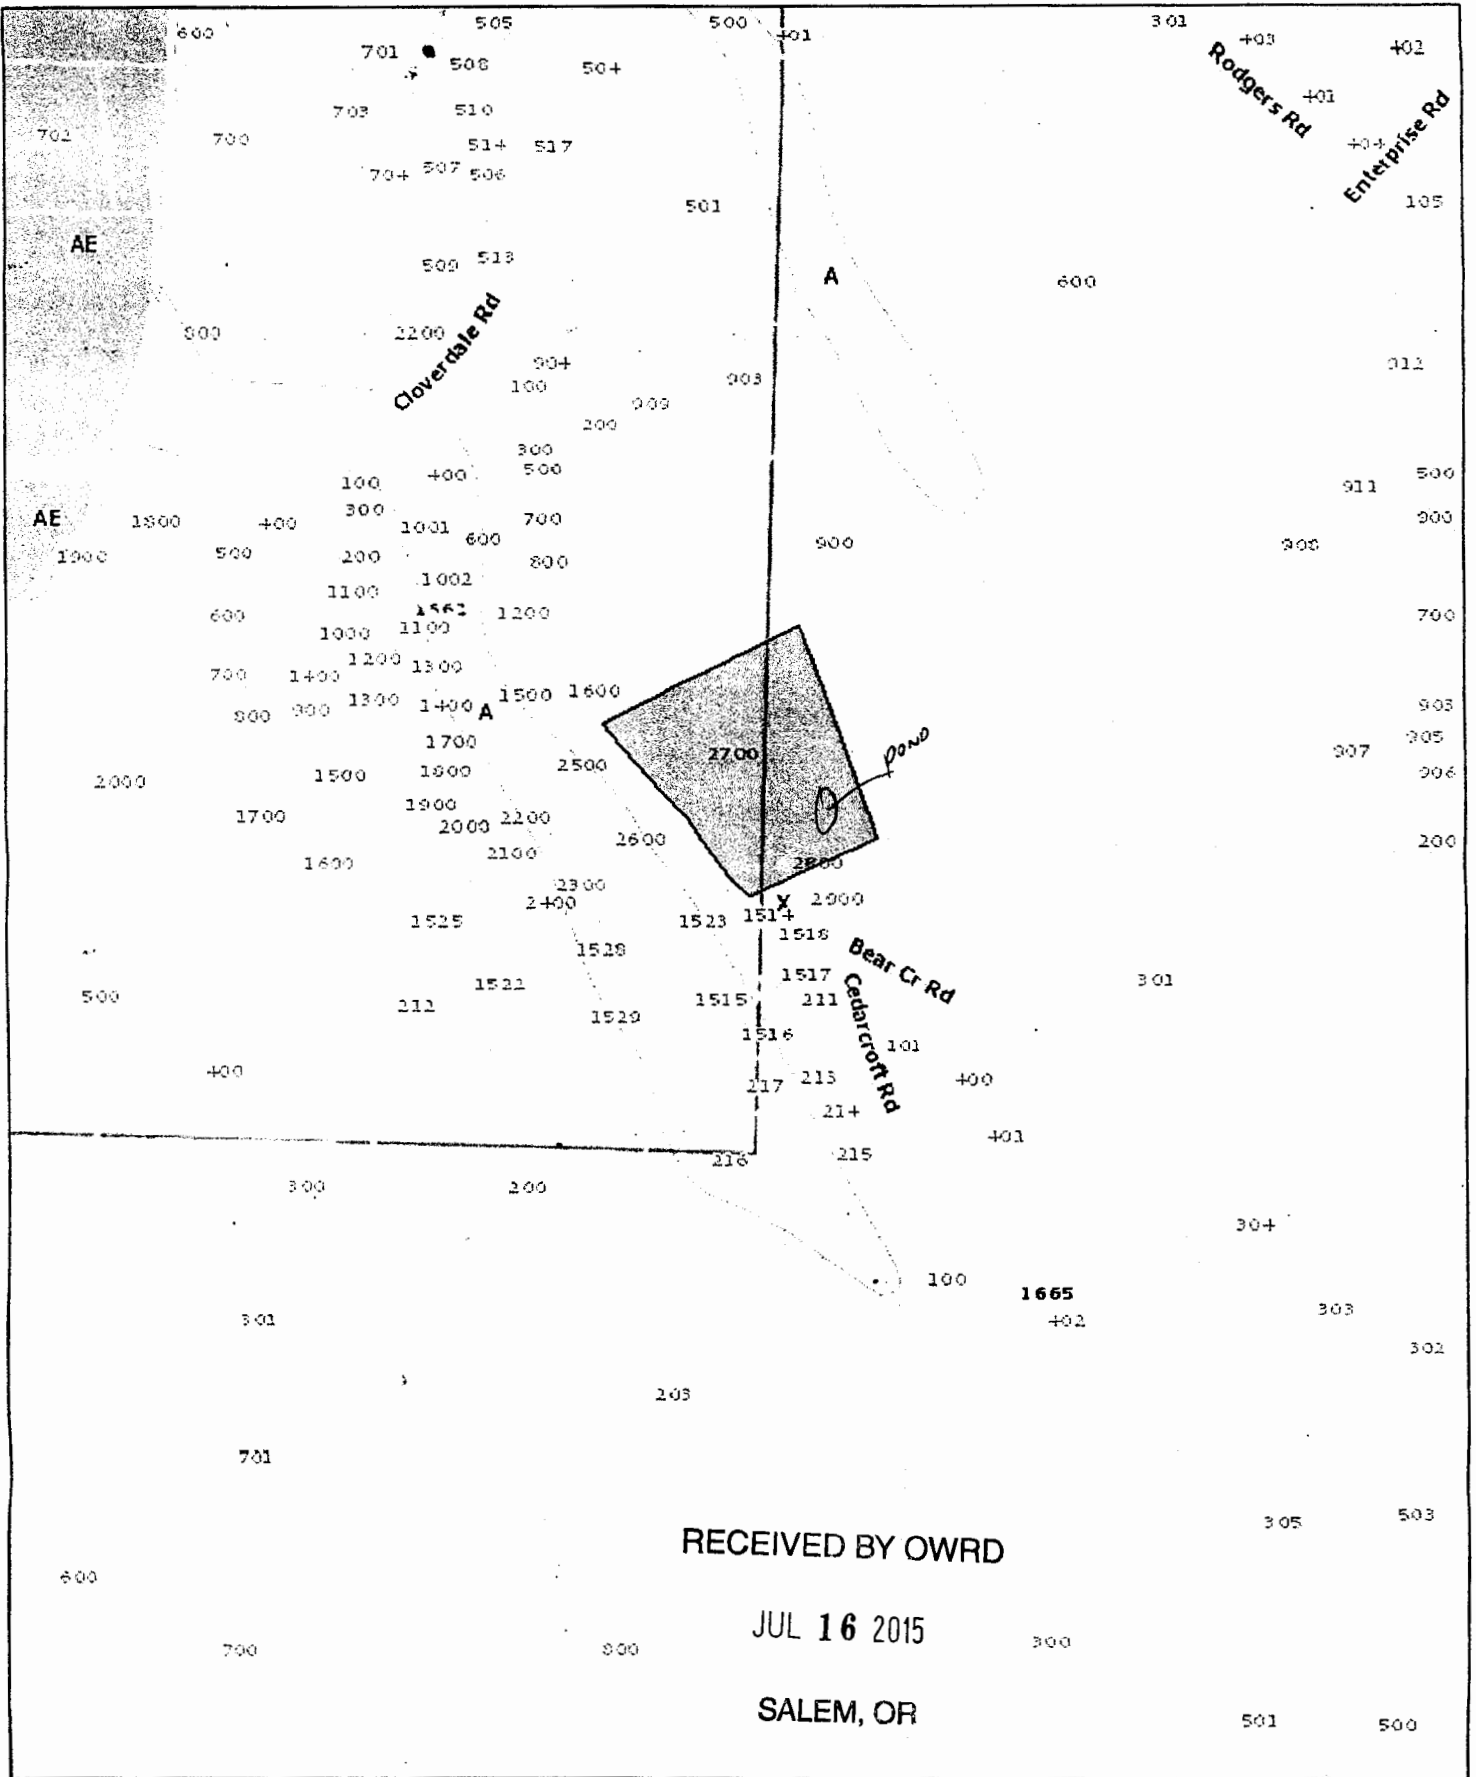

The information on this map was derived from digital databases on the Lane County regional geographic information system. Care was taken in the creation of this map, but is provided "as is". Lane County cannot accept any responsibility for errors, omissions or positional accuracy in the digital data or the underlying records. Current plan designation, zoning, etc., for specific parcels should be confirmed with the appropriate agency. There are no warranties, expressed or implied, accompanying this product. However, notification of any errors will be appreciated.



Lane County, Oregon

R-88108