

R-28109

SECTION 6 T.3S. R.1E. W.M.

CLACKAMAS COUNTY

1" = 400'

This map was prepared for assessment purposes only.

3 IE 6
& INDEX

CANCELLED
702
401
100

24000


25000

26000

11
701
100

WASHINGTON COUNTY

WASHINGTON COUNTY

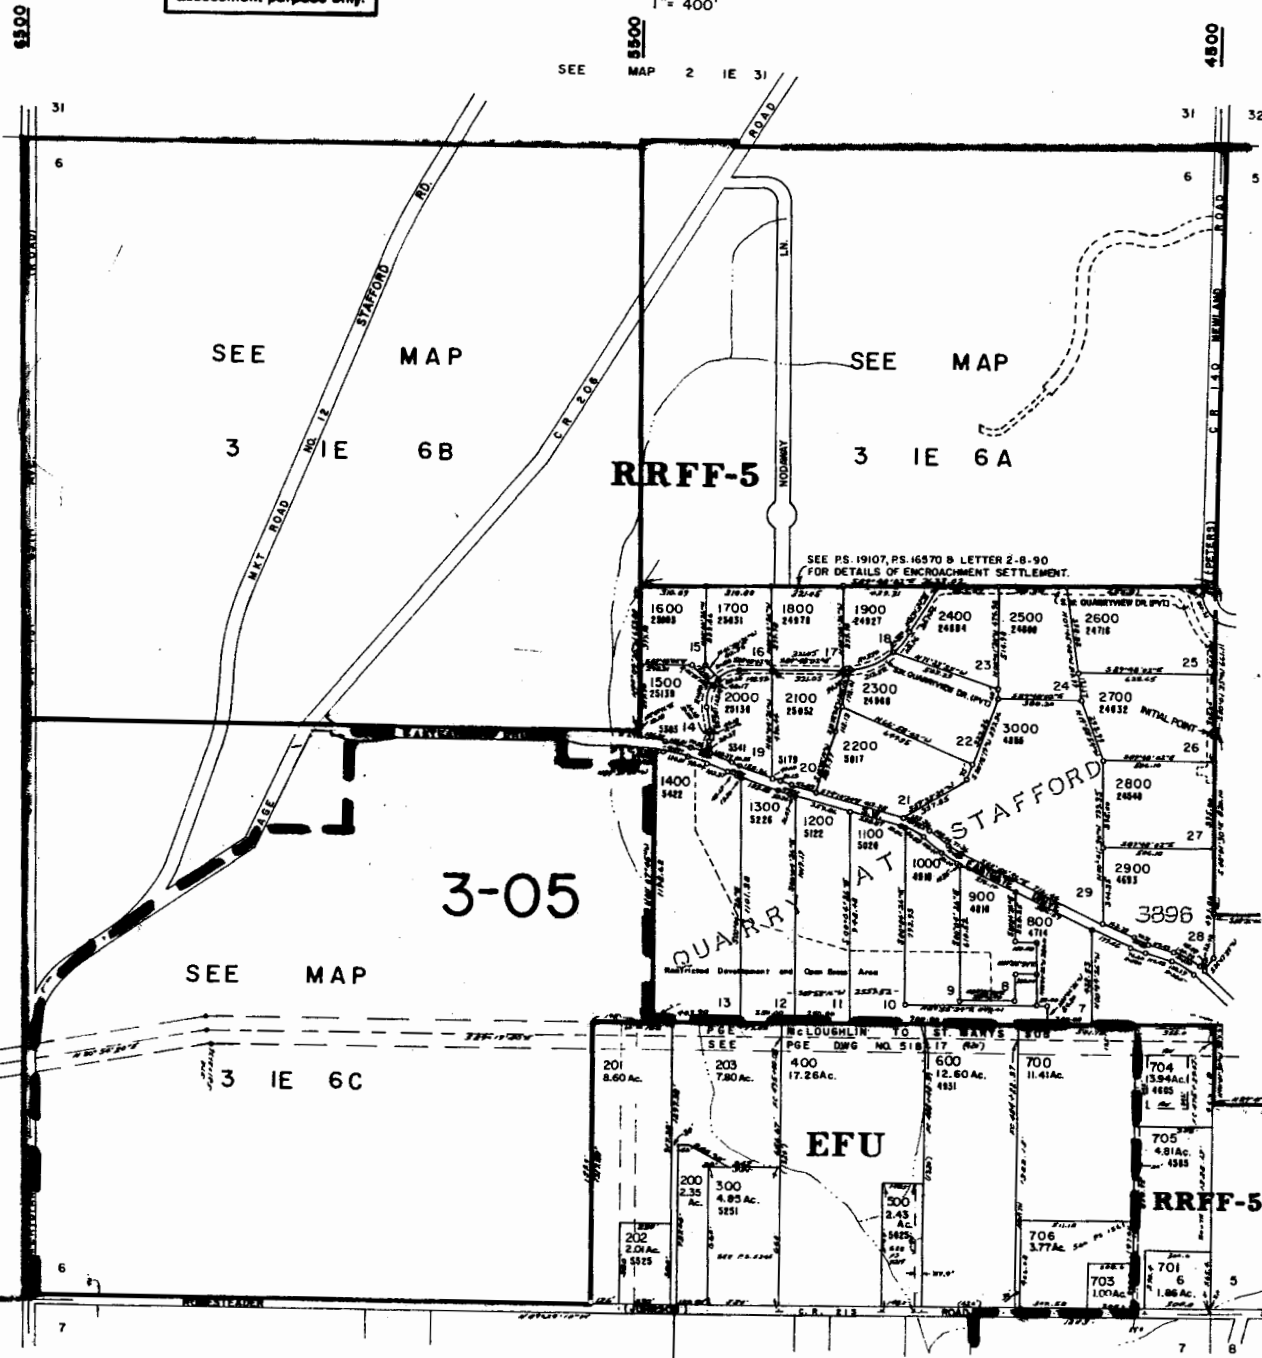

SEE MAP 3 IE 5B

SEE MAP 3 IE 5C

SEE MAP 3 IE 7B

SEE MAP 3 IE 7

SEE MAP 3 IE 7A

3 IE 6
& INDEX
BOOK 27

RECEIVED BY OWPD

JUL 17 2015

SALEM, OR

Jonathan Todd WR Application


1" = 1320'

Tax Lot: 1400

Jonathan Todd
Jonathan Todd 7/14/2015



Township 3 South, Range 1 East, Section 6

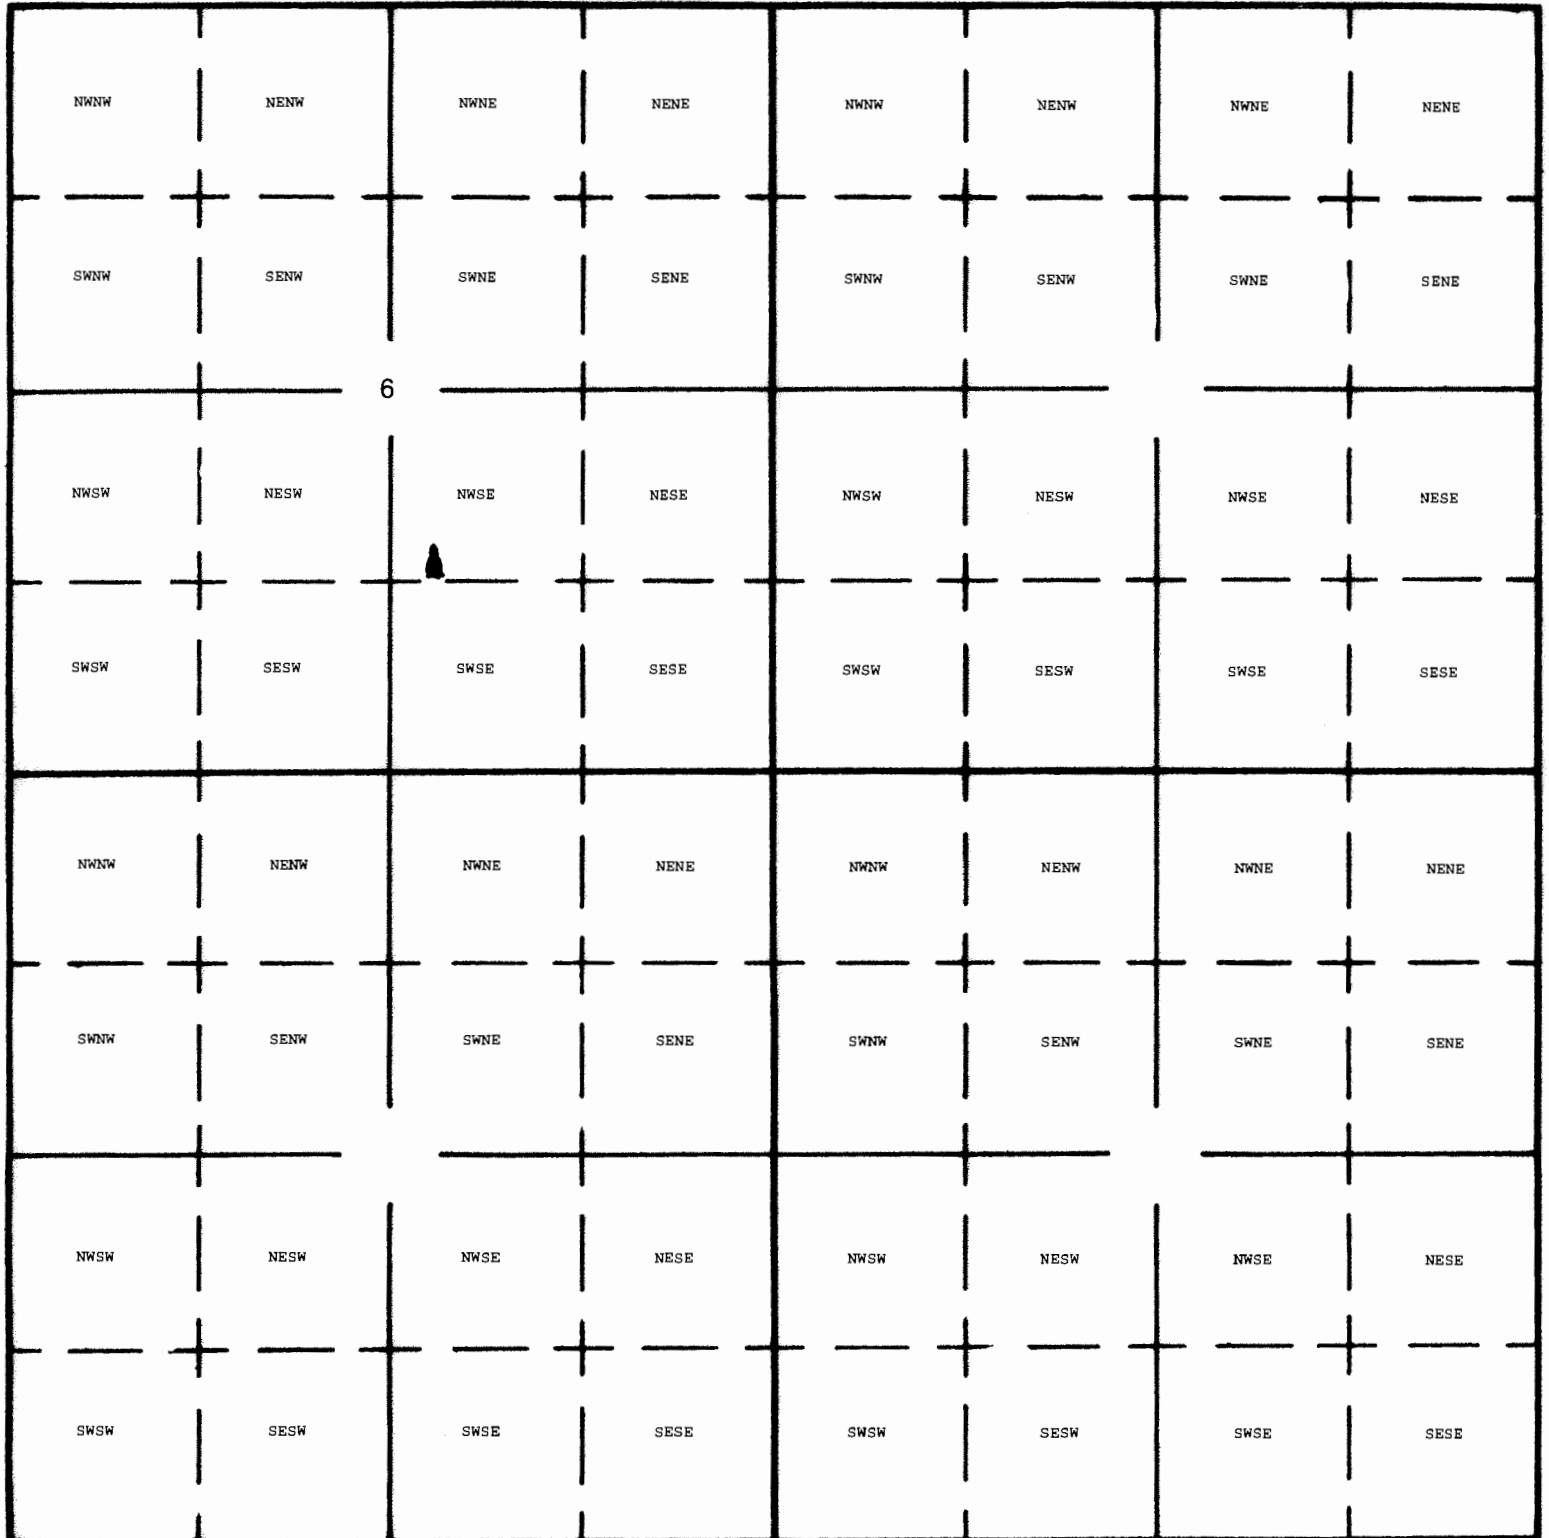

South

RECEIVED BY OWRD

Center of dam: Lat 45.33583 Long -122.73204
1260 Feet South and 330 Feet East from the Center of Section 6

JUL 17 2015

SALEM, OR

R-98109