


Oregon Water Rights Map

Printed: April 20, 2015


Oregon Water Resources Department
725 Summer St NE, Suite A, Salem, OR 97301
(503)988-0900

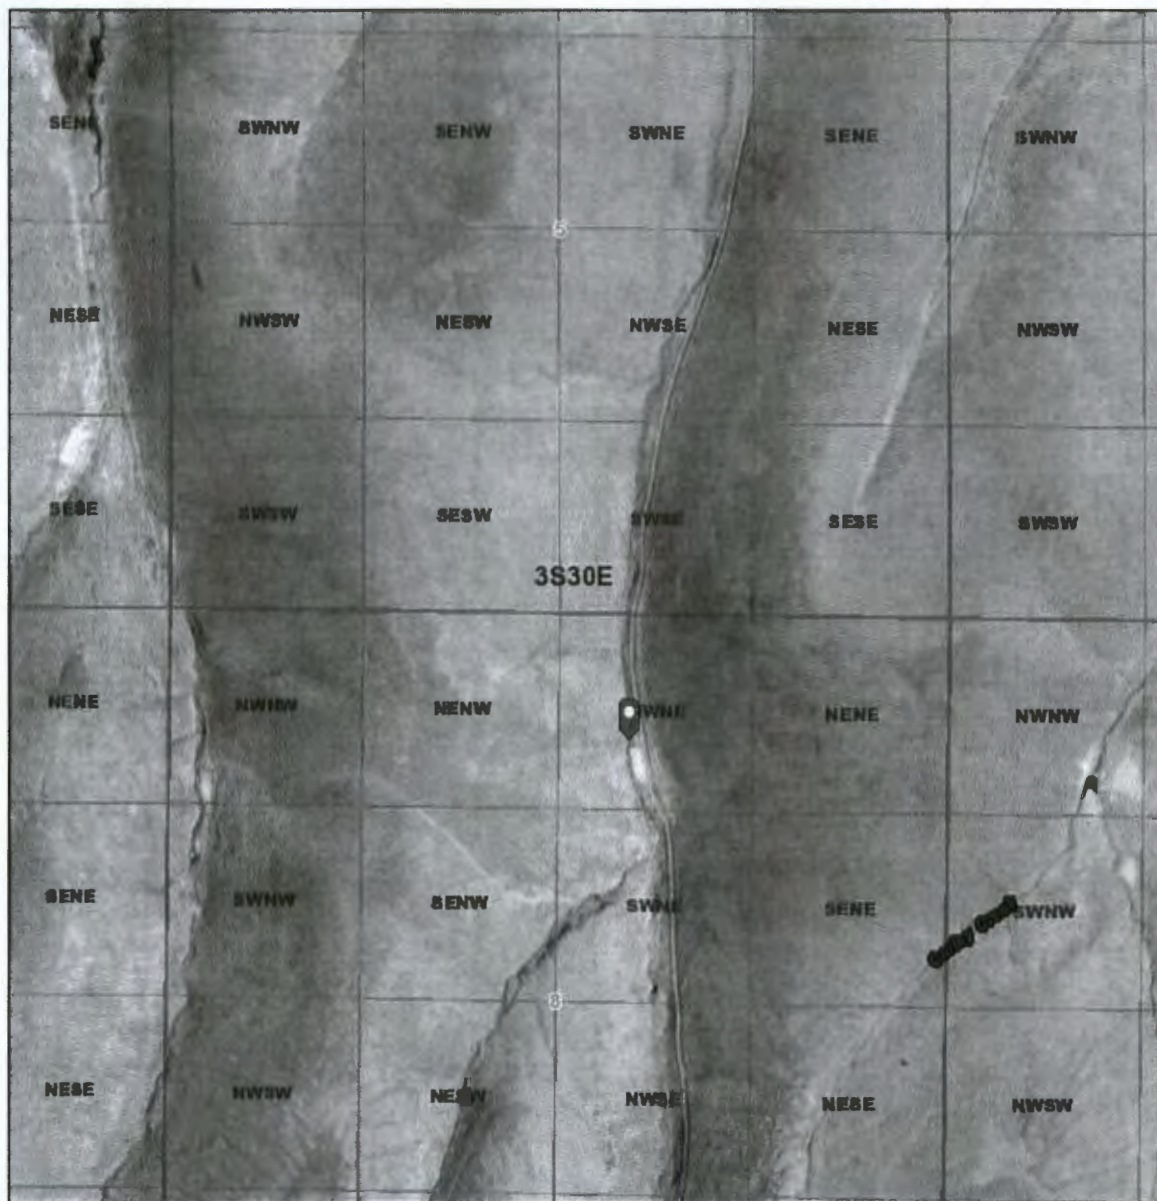

1" = 1320'

Water Rights by Type	
Points of Diversion	Pieces of Use
•	Storage Water
▲	Surface Water
▼	Groundwater
By Primary/Supplemental	
•	Primary
•	Supplemental

Water Rights by Use	
Recreation	Livestock
Fish	Irrigation
Wildlife	Mining
In stream	Power
Misc	Commercial
Agriculture	Domestic

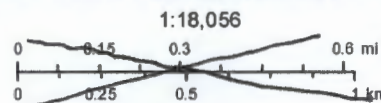

RECEIVED BY OWRD

JUL 06 2015

Disclaimer: <http://www.oregon.gov/owrd/pages/MAPS/index.aspx#Disclaimer>

SALEM, OR

T 3 S R 30 E SEC 8

Dam located 456 feet North and
505 feet East from
the South West corner
of the NW 1/4 NE 1/4

R-88111

RECEIVED BY OWRD

JUL 17 2015

SALEM, OR