


JACKSON COUNTY

Water diverted from } Sec 16 T.37 S., R.2 E., W. M.
and used on } TAX LOT 5500

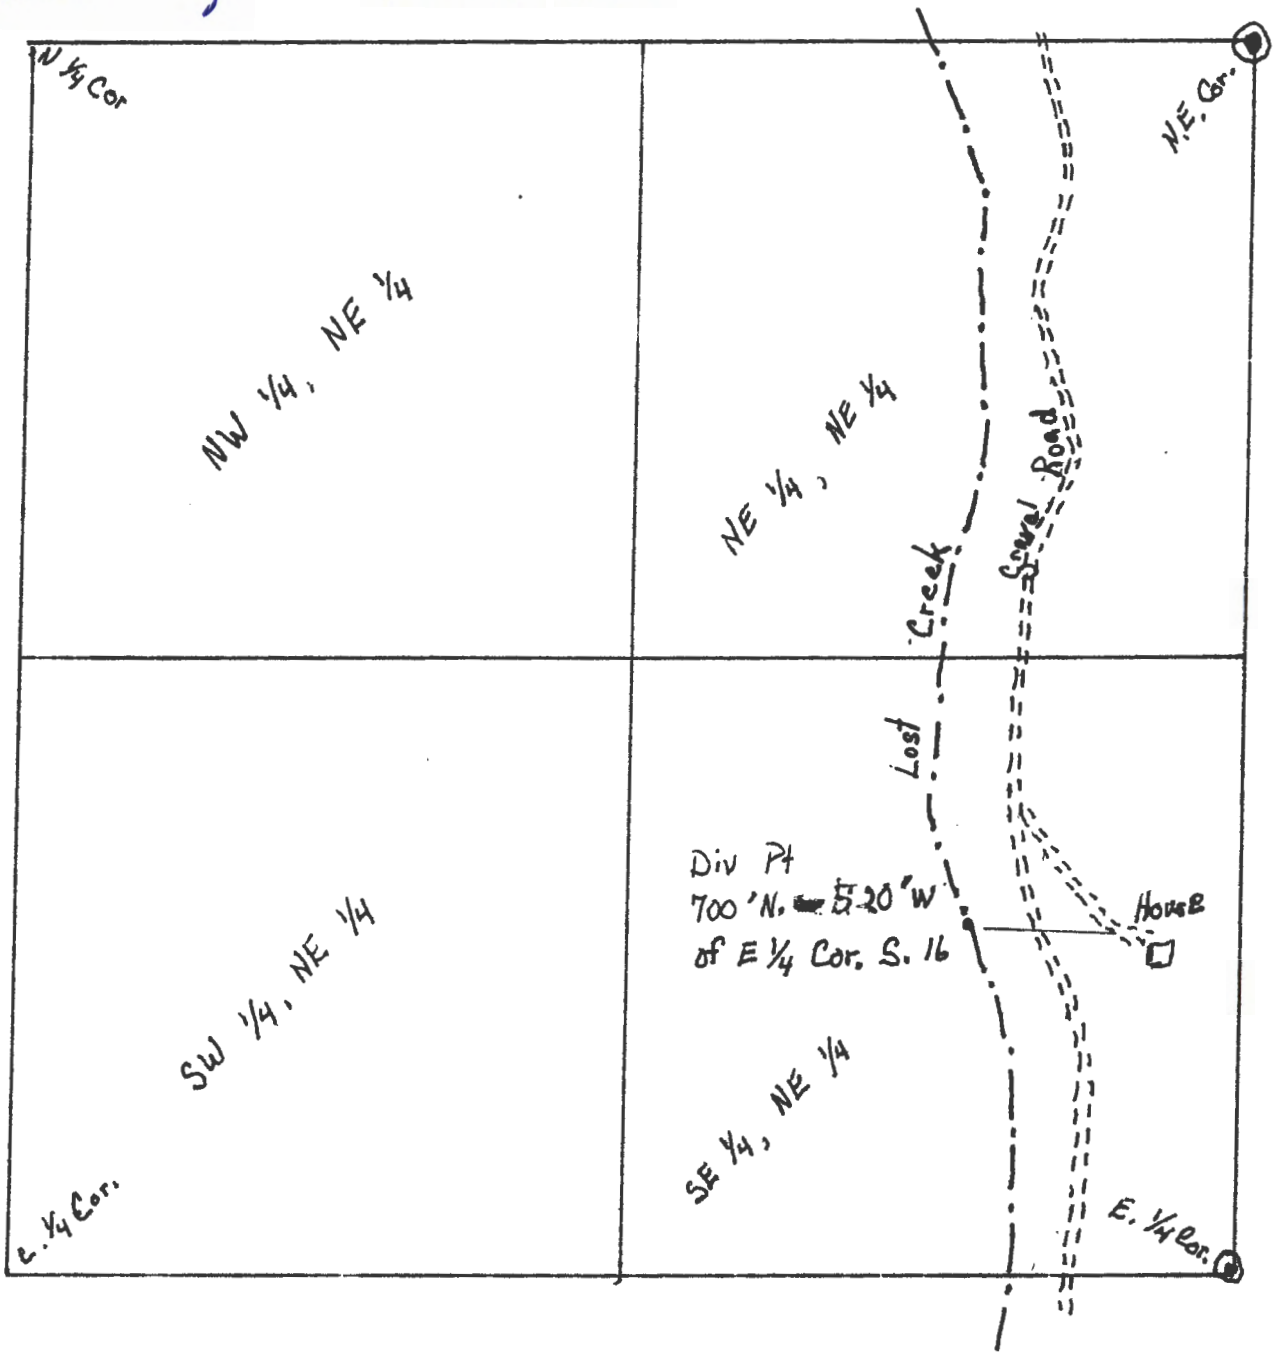

N ↑
Scale 1" = 400'

S-8813

RECEIVED

JUL 28 2015

OWRD