

MAP 2800

SEE MAP 17082933





SEE MAP 17082933

MAP 3000

MAP 0000

T17S, R2W Sec 29
SE 1/4, SW 1/4
850' N & 485' W
of S 1/4 corner

Pond

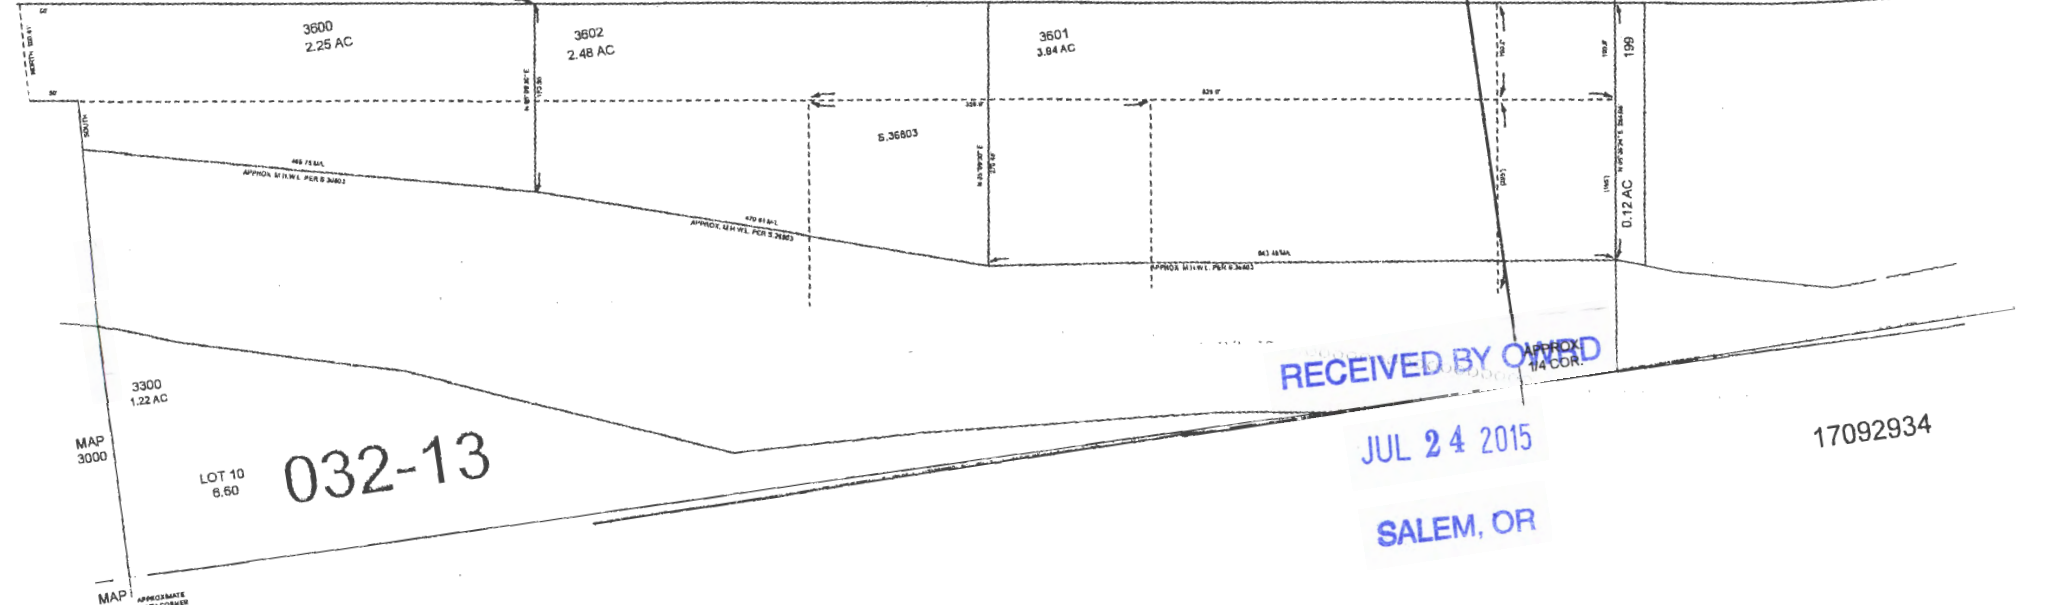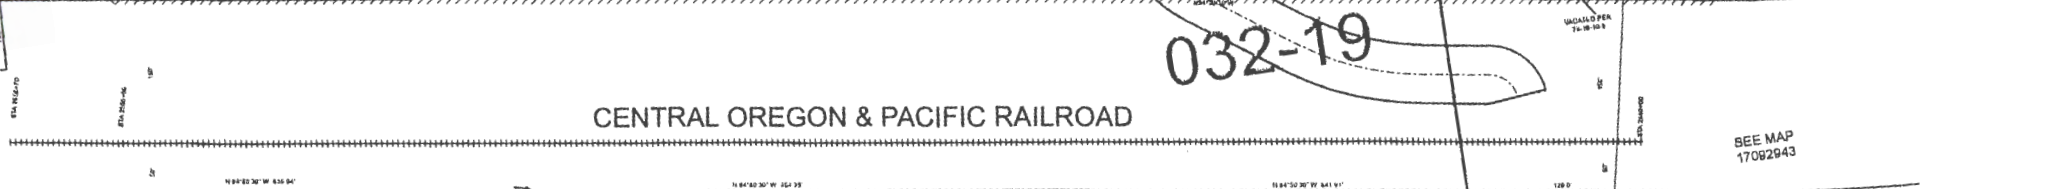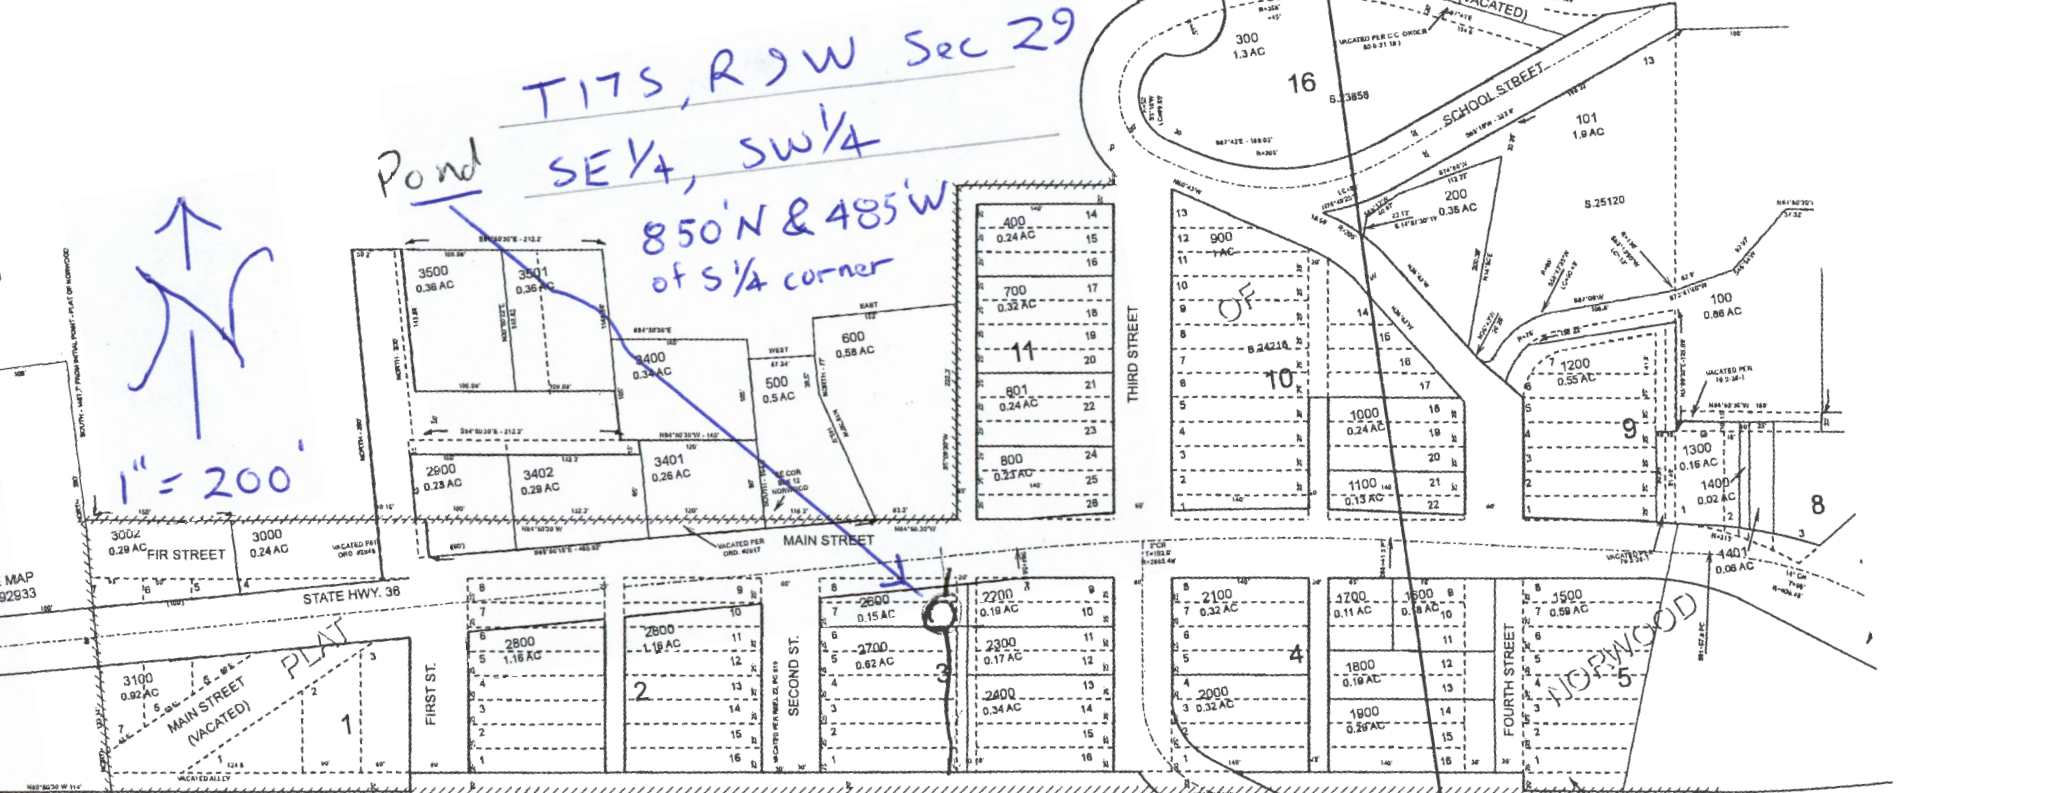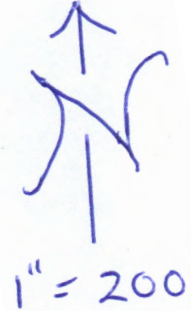

032-19

032-13

RECEIVED BY OARD

JUL 24 2015

SALEM, OR

17092934

GRADE CODES TO 1989 STATUS USE