

Tom Schmidt

1" = 1320'

Tax Lot: 400


Township 4 South, Range 5 West, Section 36



**RECEIVED**

APR 13 2015

WATER RESOURCES DEPT  
SALEM, OREGON

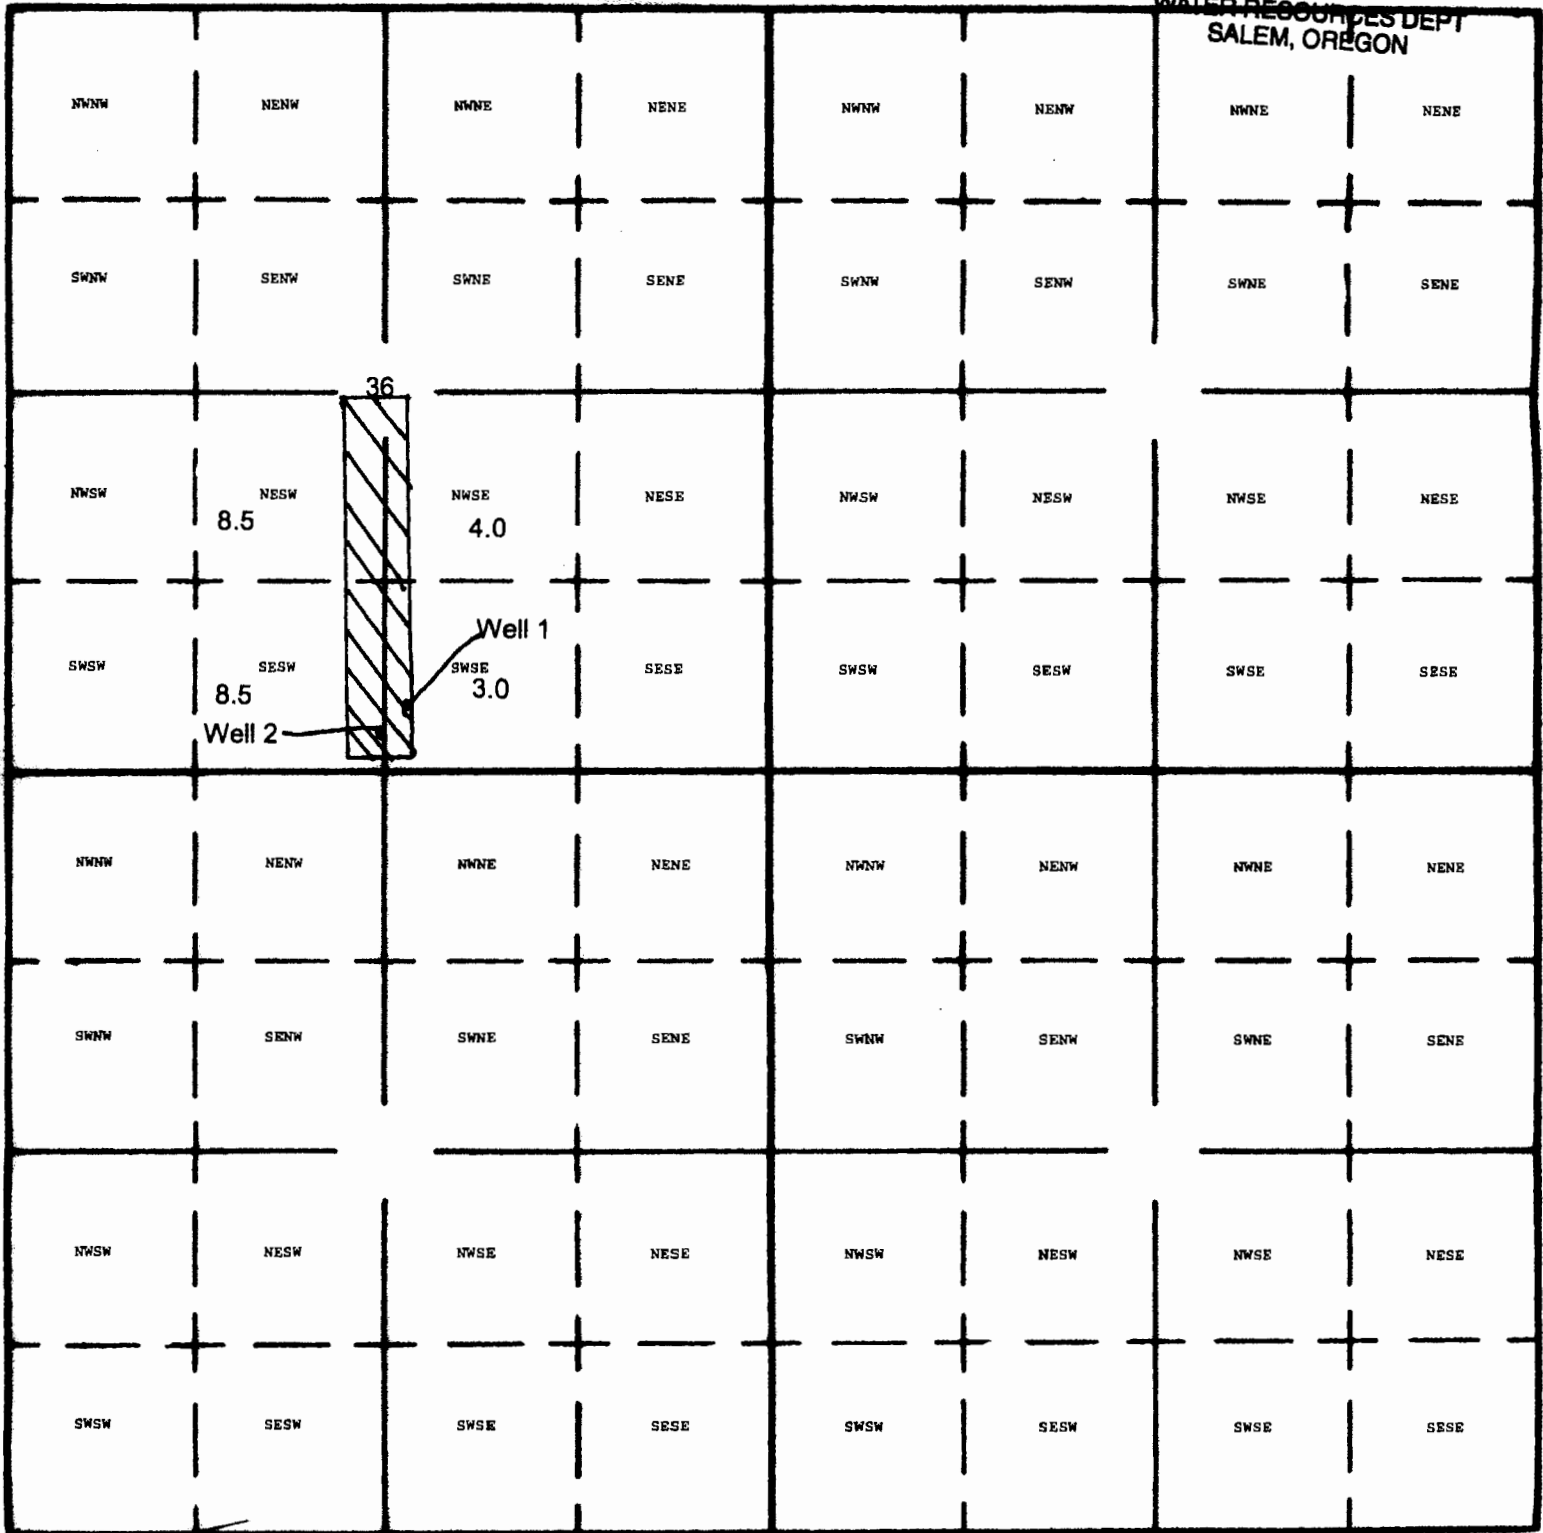

*Shane J Schmidt*

South 4-11-2015

**RECEIVED**

Well 1 (YAMH 6308) location: 2115 Feet South and 115 Feet East from the Center of Section 36  
Lat: 45.17383 Long: -123.24807

AUG 10 2015

Well 2 location: 2400 Feet South and 15 Feet West from the Center of Section 36

WATER RESOURCES DEPT  
SALEM, OREGON

~~66-1571~~  
G-18125