

Township	Rang	Section	Tax Lot	1/4 1/4	Acres
18s	47e	20	300	NENE	32.6
			300	NWNE	32.8
			300	SWNE	25.9
			300	SENE	36.9
				Total	128.2

RECEIVED BY OWRD

AUG 10 2015

SALEM, OR

RECEIVED BY OWRD

JUL 27 2015

SALEM, OR

RECEIVED BY OWRD

FEB 19 2014

SALEM, OR

RECEIVED BY OWRD

JAN 27 2014


SALEM, OR

G-1762

G-18126

G-18126


THIS MAP WAS PREPARED FOR ASSESSMENT PURPOSES ONLY

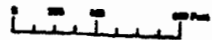

SECTION 20 T.18S. R.47E. W.M.
MALHEUR COUNTY
1" = 90.2' Approx.

USE THIS TO LOCATE WELL

18S47E20
CANCELLED
1988

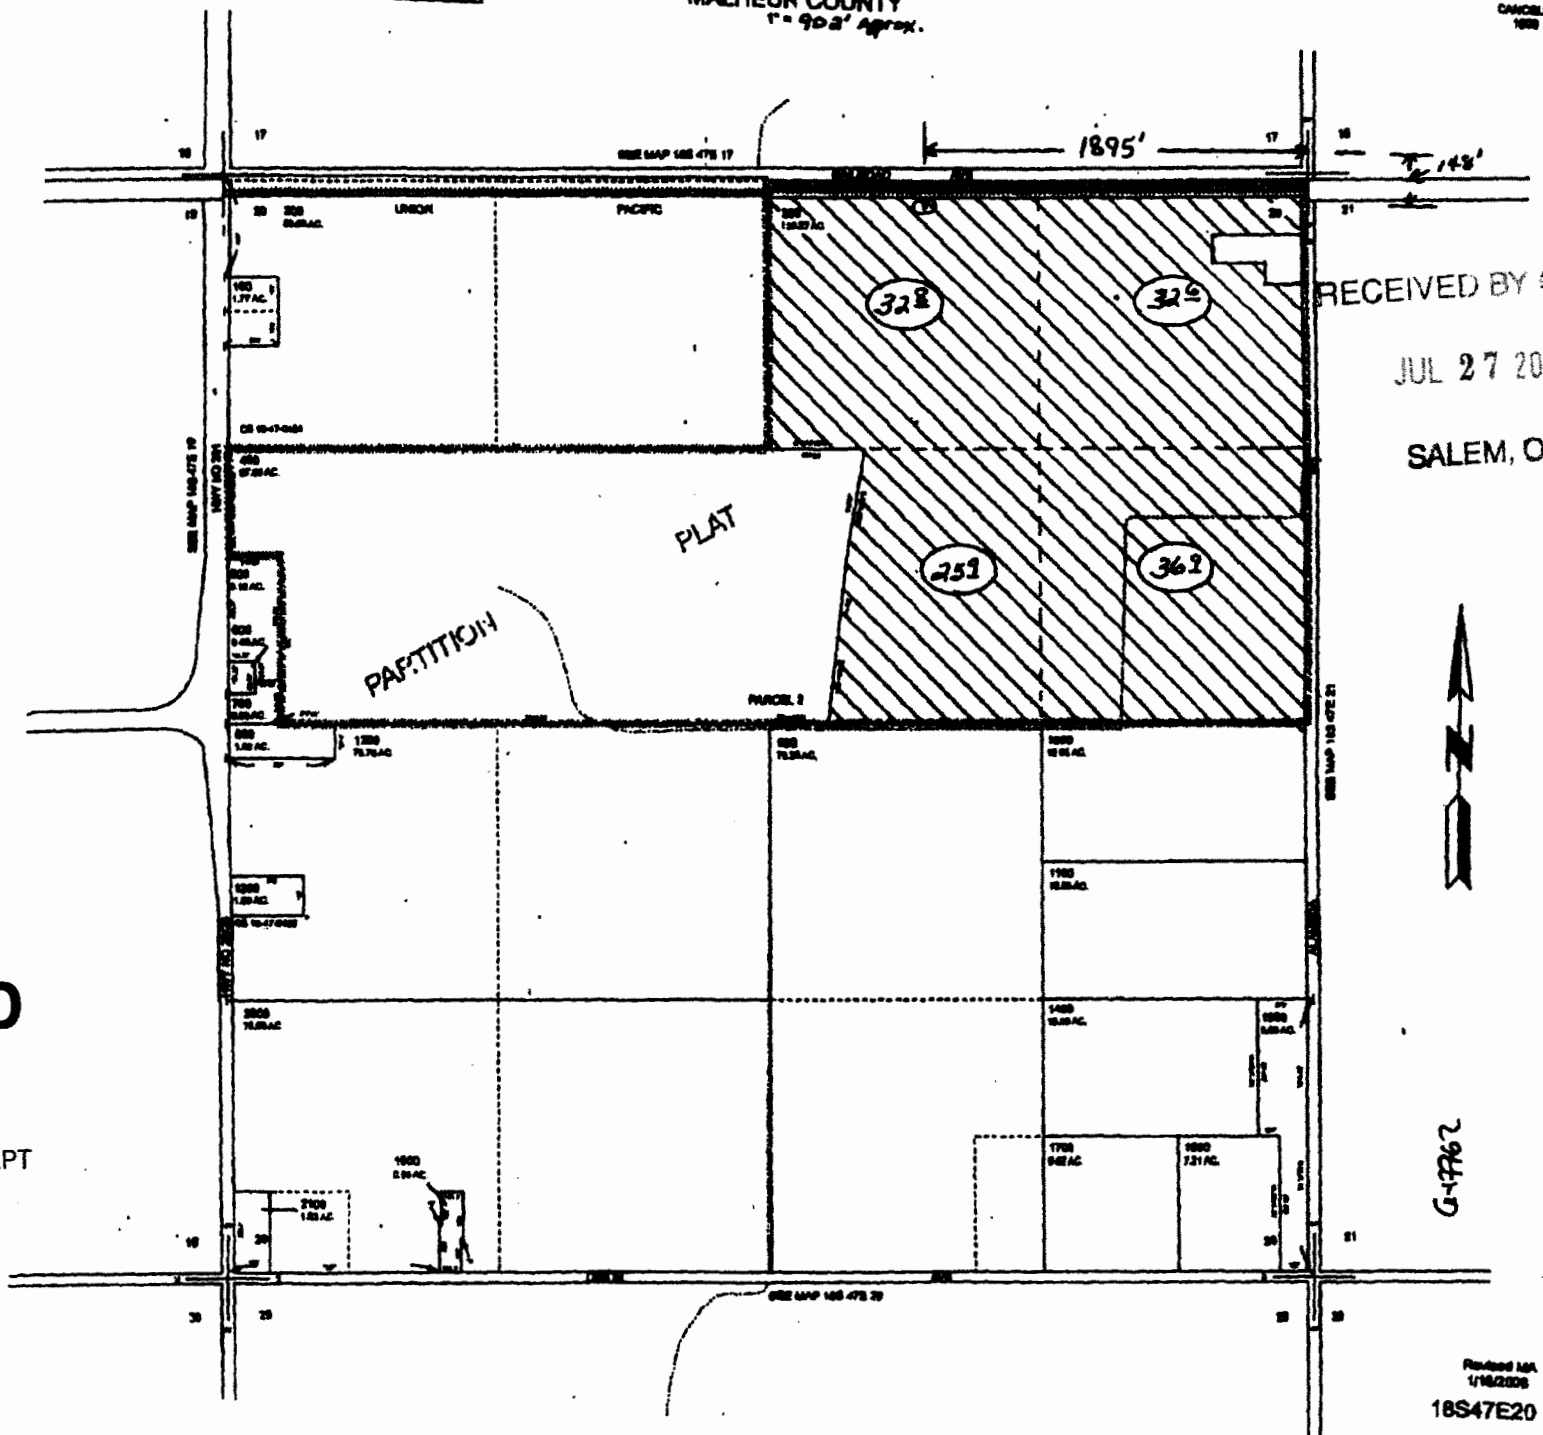

RECEIVED BY OWRD

JUL 27 2015

SALEM, OR



G-1762


RECEIVED

AUG 10 2015

WATER RESOURCES DEPT
SALEM, OREGON


Revised 1/18/2009
18S47E20

ED FOR
ONLY

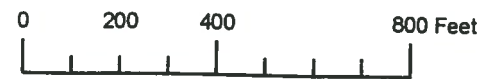

SECTION 20 T.18S. R.47E. W.M.
MALHEUR COUNTY
1" = 400'

18S47E20
CANCELLED:
1800

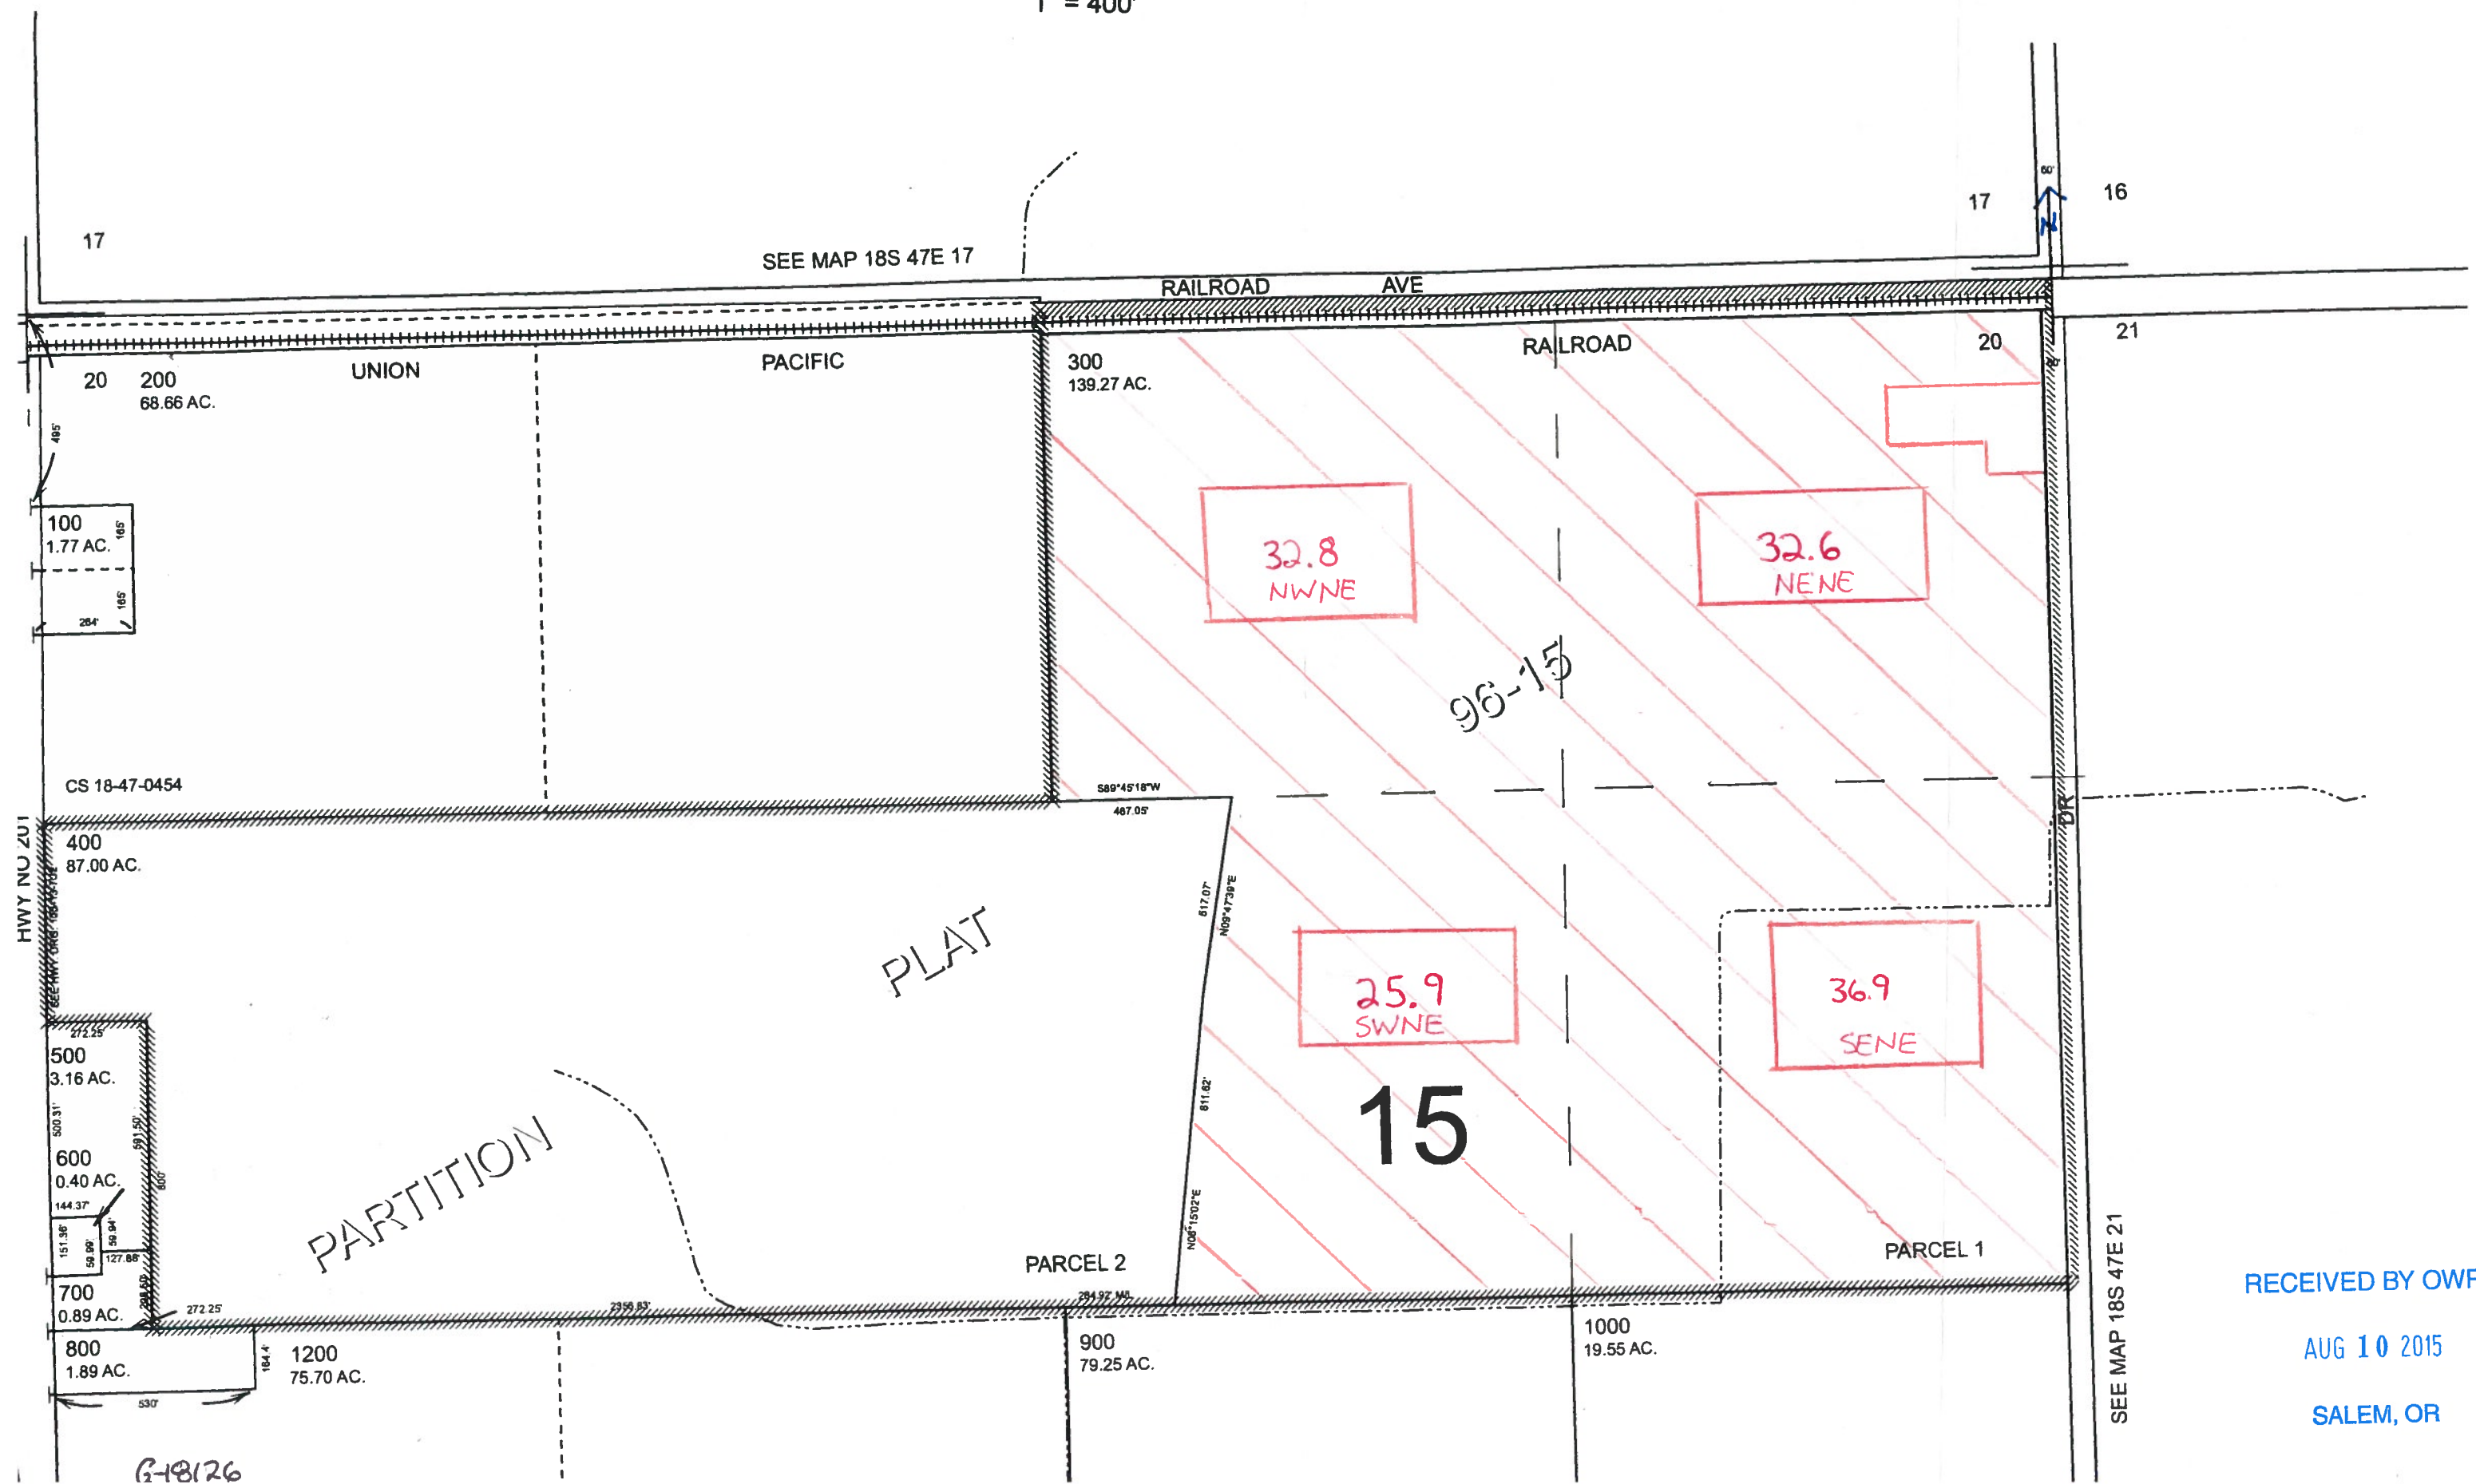

RECEIVED BY OWRD
AUG 10 2015
SALEM, OR

G-18126