






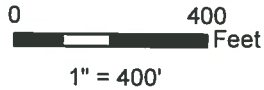


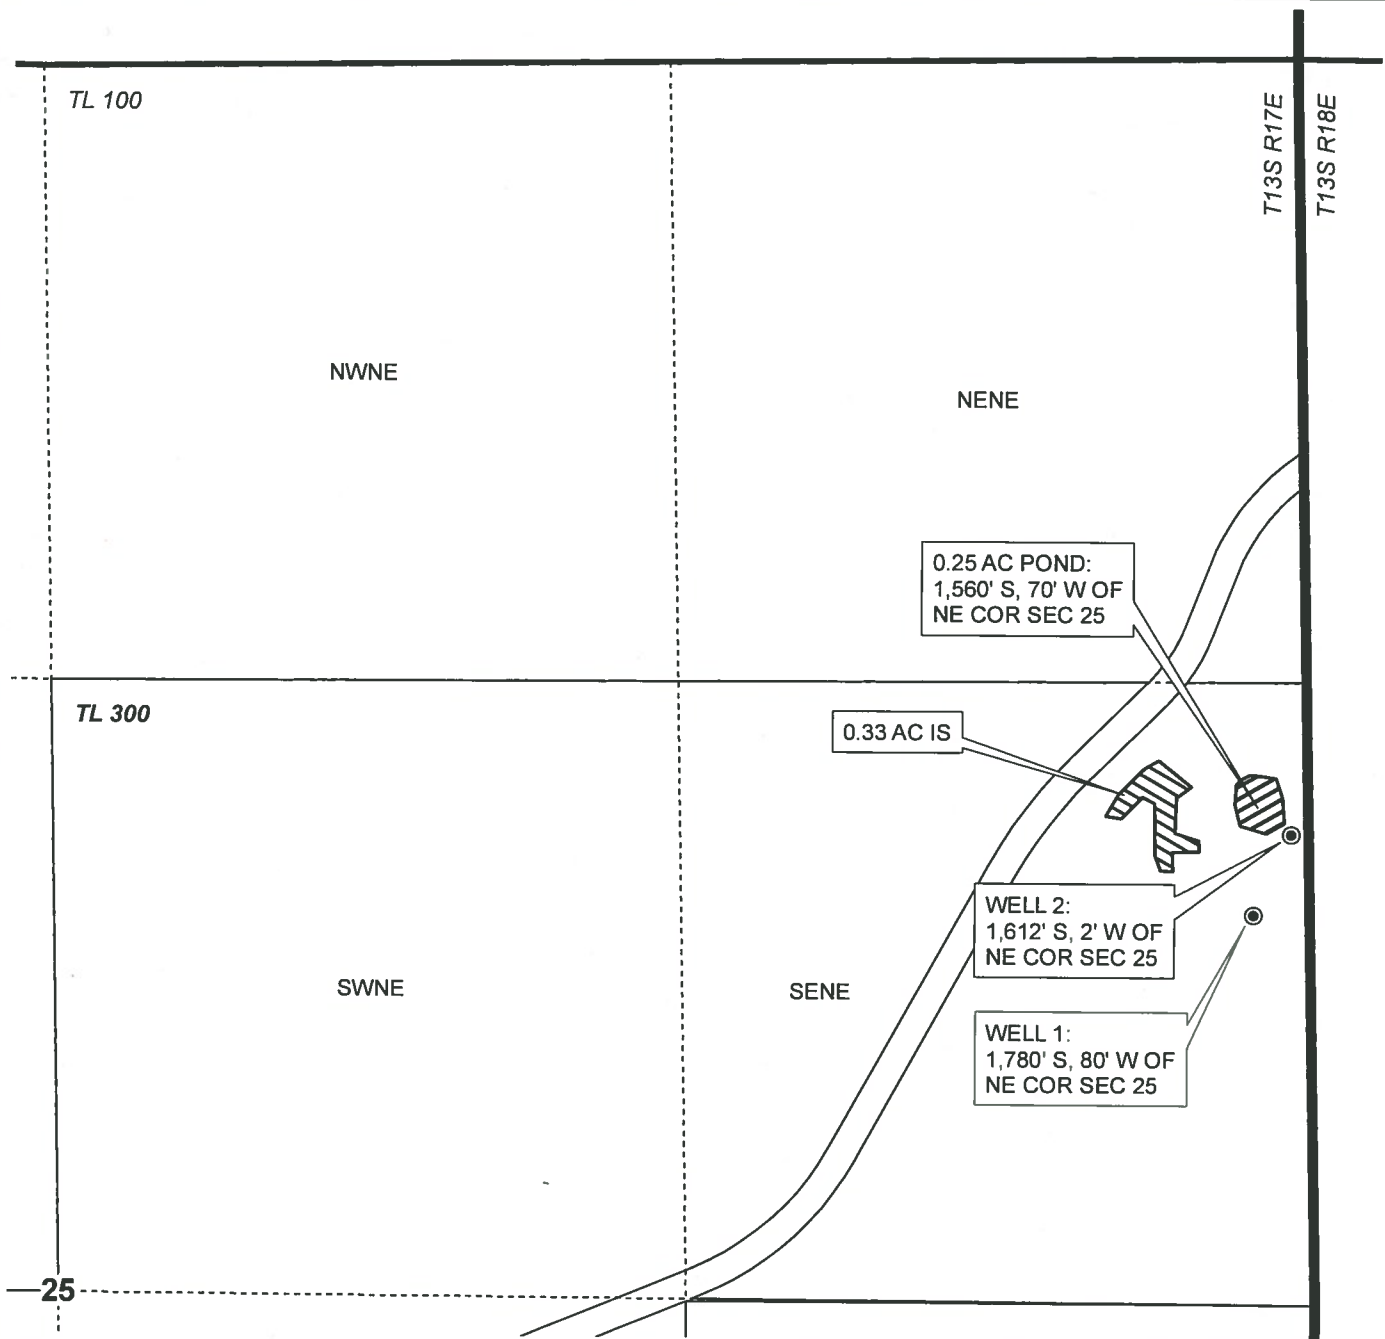
**T13S, R17E  
SECTION 25, WM**

CROOK COUNTY, OREGON



**Legend**

-  Township
-  Section
-  Quarter Quarter
-  Tax Lot
-  Place of Use - IS
-  Place of Use - Pond, FW
-  Well



**RECEIVED**

JAN 25 2016

WATER RESOURCES DEPT  
SALEM, OREGON

**GROUNDWATER APPLICATION MAP**  
Randy Arnett

NOTE: THIS MAP IS NOT INTENDED TO  
PROVIDE LEGAL DIMENSIONS OR LOCATIONS  
OF PROPERTY OWNERSHIP LINES.

JANUARY 25, 2016

**WATER RIGHT SERVICES, LLC**  
PO BOX 1830, BEND, OR 97709  
CCB# 197121 [www.oregonwater.us](http://www.oregonwater.us)  
541-389-2837 [JOHNSHORT@USA.COM](mailto:JOHNSHORT@USA.COM)

WATER SUPPLY WELL REPORT - Map with location identified must be attached and shall include an approximate scale and north arrow

**CROO 54251**

6/28/2015

RECEIVED BY OWRD

Map of Hole

JUL 27 2015

SALEM, OR

**STATE OF OREGON  
WELL LOCATION MAP**

This map is supplemental to the WATER SUPPLY WELL REPORT

**Oregon Water Resources Department**

725 Summer St NE, Salem OR 97301  
(503)986-0900



**LOCATION OF WELL**

Latitude: 44.41477778 Datum: WGS84

Longitude: -120.62622222

Township/Range/Section/Quarter-Quarter Section:

WM 13S 17E 25 SENE

Address of Well:

12800 NE MILL CREEK

**Well Label: 115195**

**Printed: June 28, 2015**

DISCLAIMER: This map is intended to represent the approximate location of the well. It is not intended to be construed as survey accurate in any manner.

Provided by well constructor



G-1210x




R 75135

CERTIFICATE NO. 69401


RECEIVED  
DEC 1 1994  
WATER RESOURCES DEPT.  
SALEM OREGON

Inter-Cover

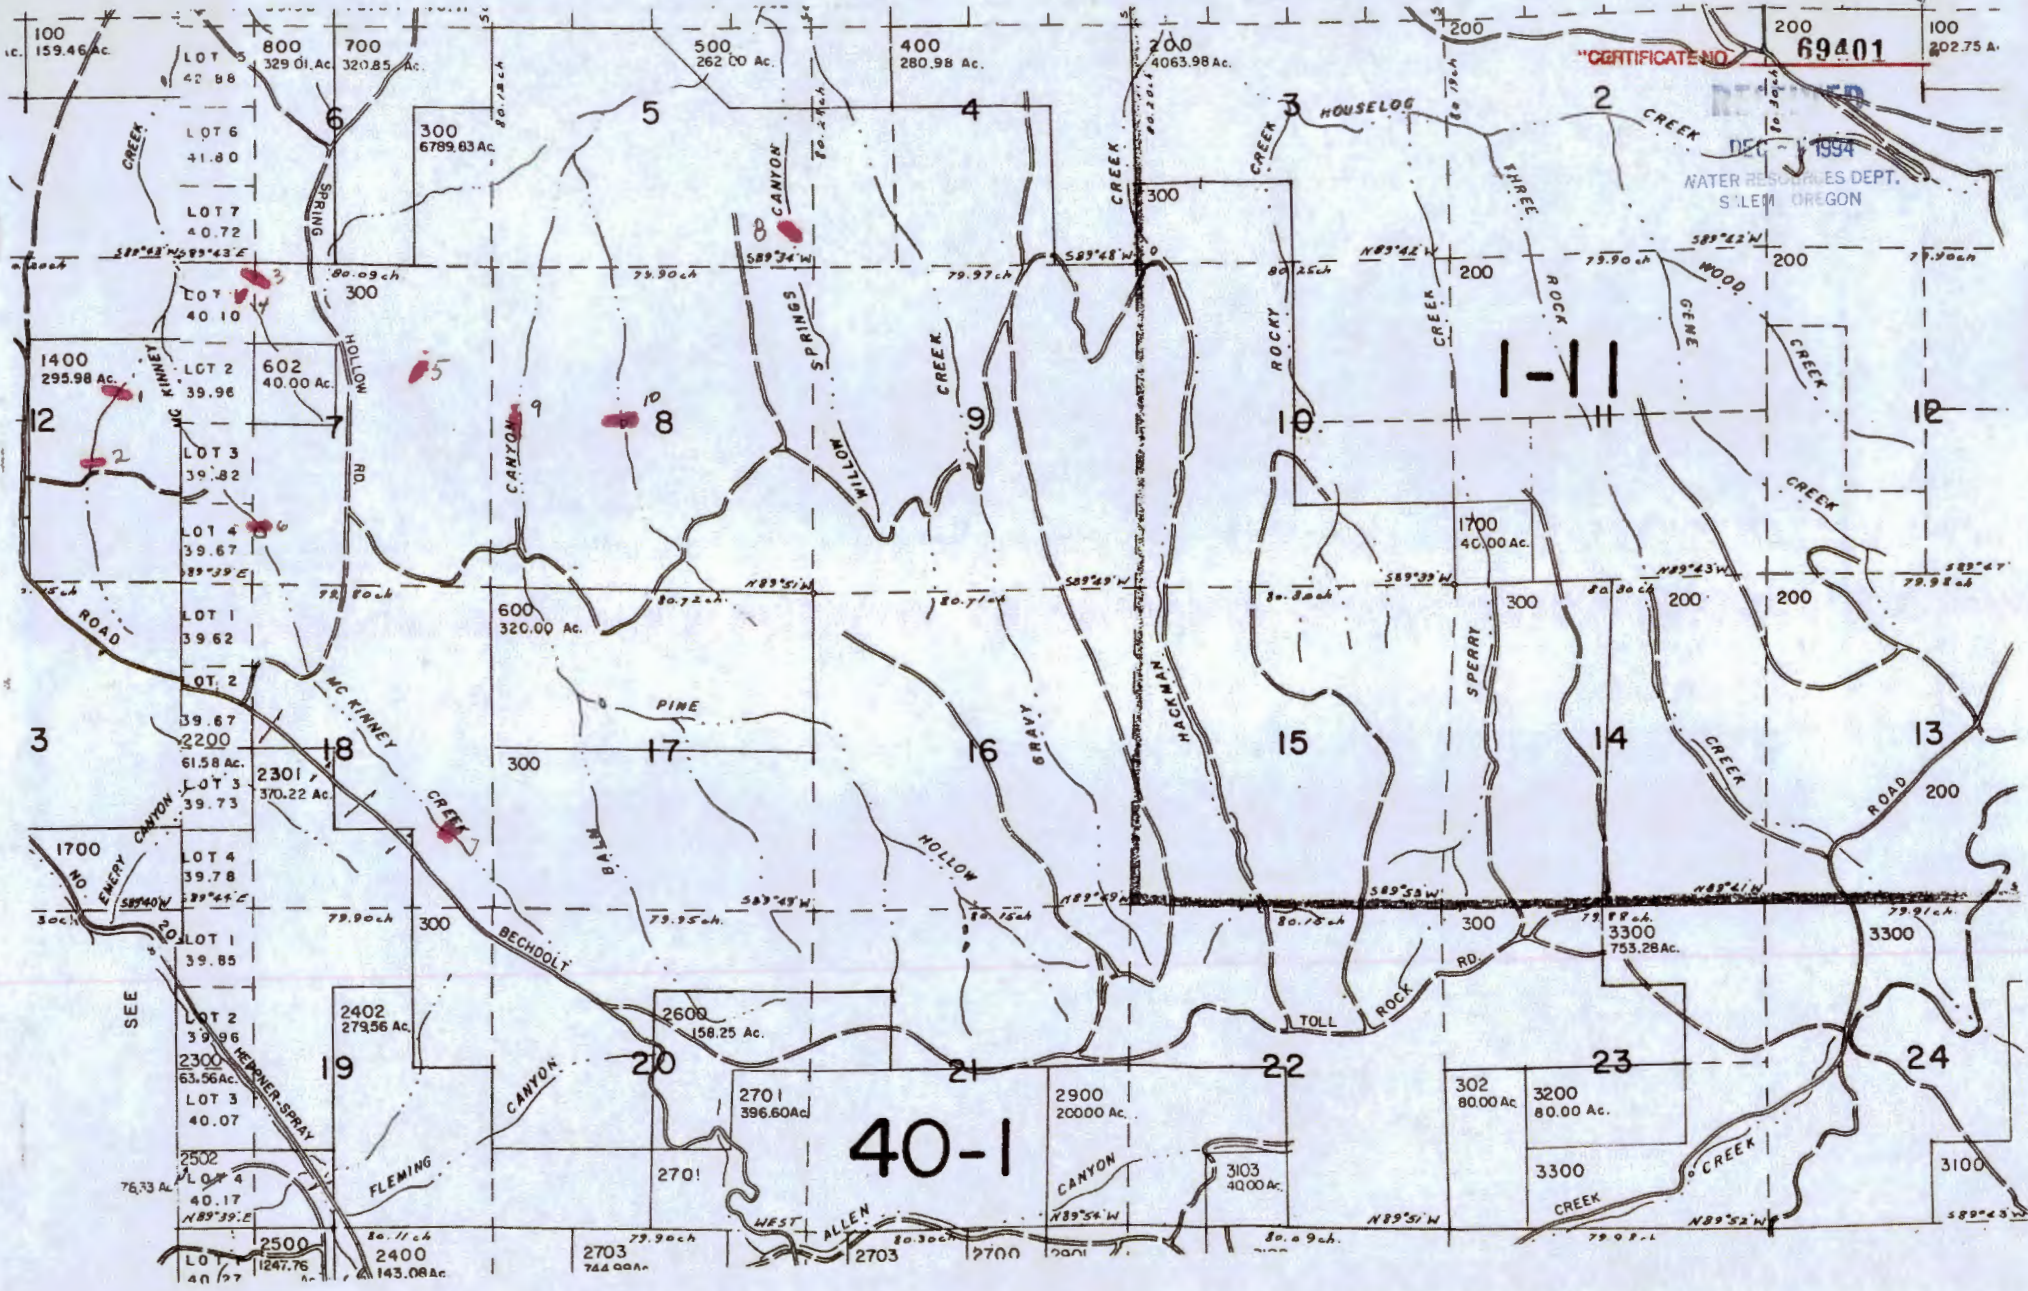



THIS MAP WAS PREPARED FOR ASSESSMENT PURPOSE ONLY

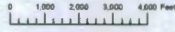


T.13S. R.17E. W.M. CROOK COUNTY 1" = 2000'

SEE MAP 12S 17E

13S17E & INDEX

Cancelled 200 201 ThRU 204

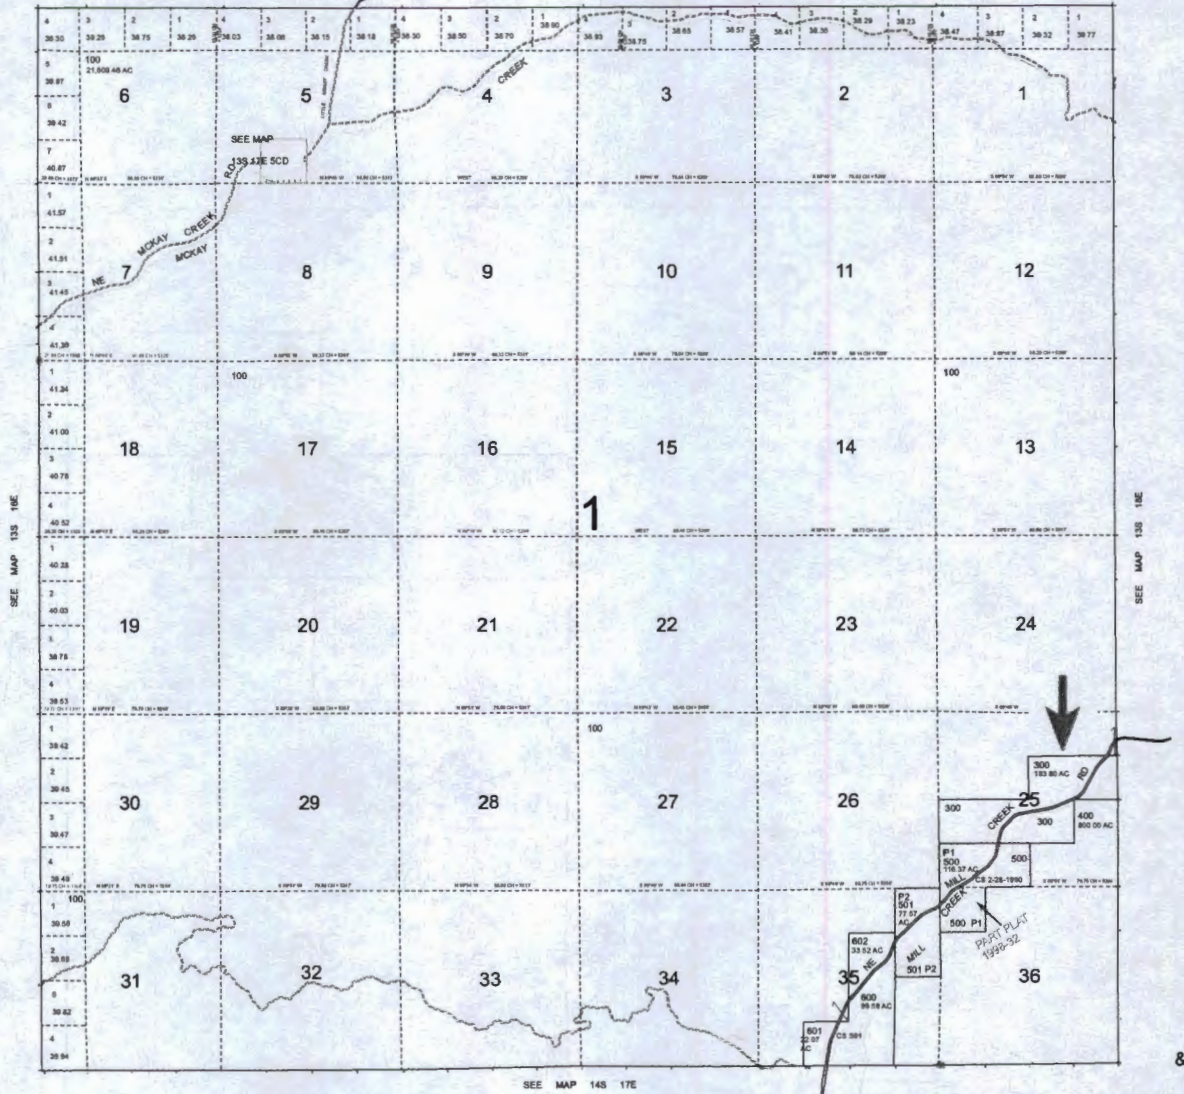

Revised: CC 8/13/2000

& INDEX 13S17E



COMPLIMENTS OF AmeriTitle

This sketch is furnished for information purposes only to assist in property location with reference to streets and other parcels. No representation is made as to accuracy and the Company assumes no liability for any loss occurring by reason






# COMPLIMENTS OF AmeriTitle

This sketch is furnished for information purposes only to assist in property location with reference to streets and other parcels.

No representation is made as to accuracy and the Company assumes no liability for any loss occurring by reason or reliance thereon.

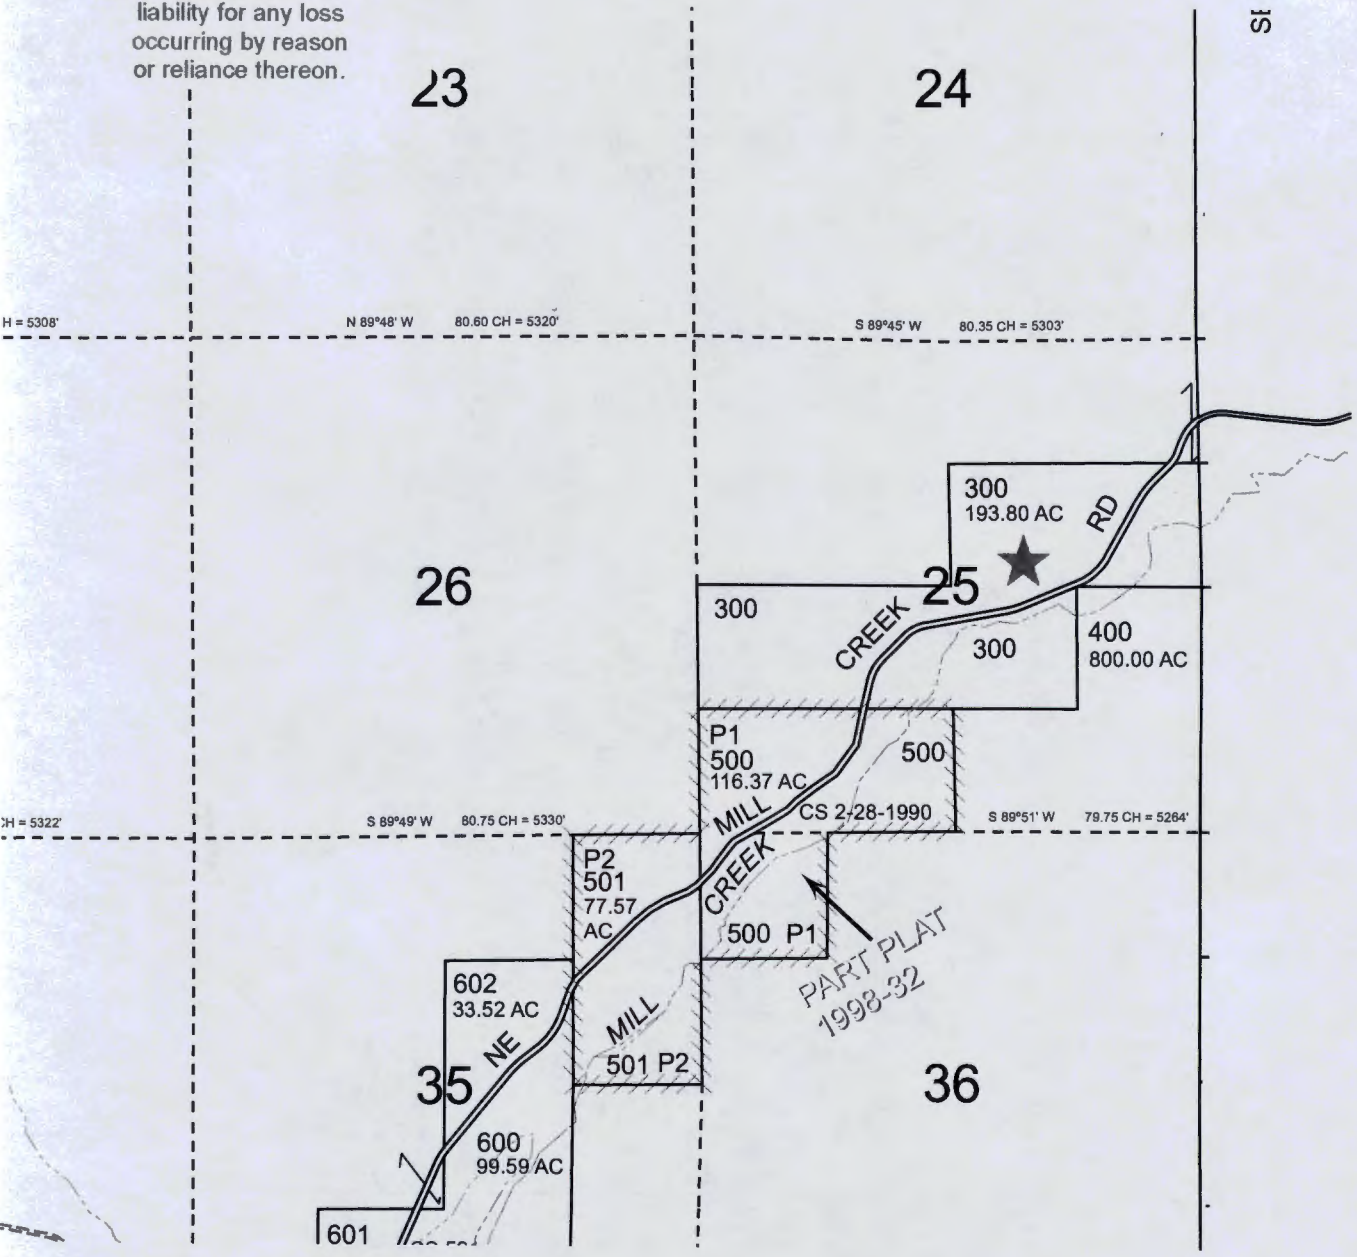

Revised: CC  
9/13/2000