


# T35S R7W NE Sec 26

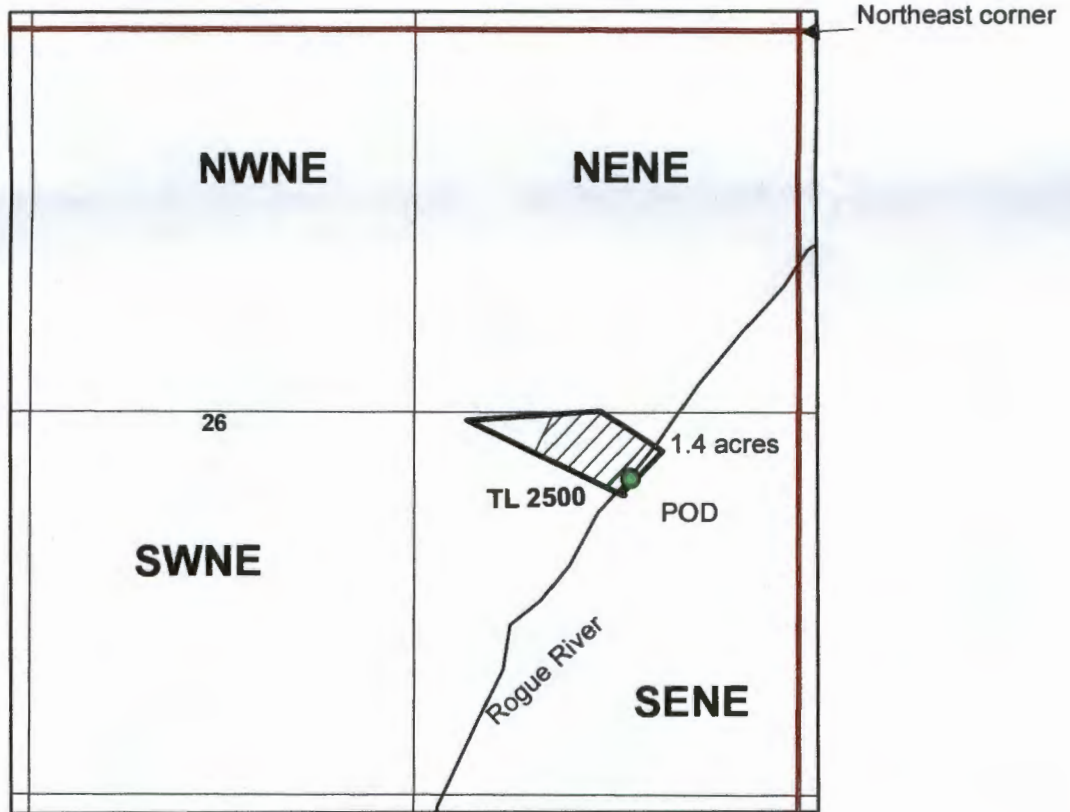


RECEIVED BY OWRD

AUG 17 2015

SALEM, OR

1 inch = 660 feet

**POD is 1564 ft south and 590 ft west from the northeast corner of Section 26**

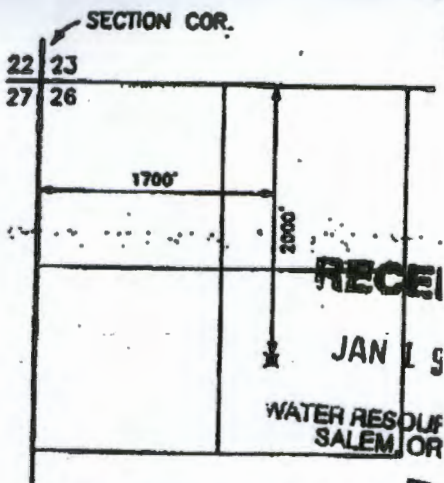

LOST CREEK RESERVIOR *Ri*  
 POINT OF DIVERSION  
 T.33S., R.1E., W.M.  
 SCALE 1" = 1320'

*S-88120*

WATER