

PROPOSED TARA-DEVON
RESERVOIR (MULTI-PURPOSE)

BENTON COUNTY, OREGON
3,000,000 GALLONS
9.2 ACRE FEET
10' DAM HEIGHT


NO WETLANDS

PROPERTY OWNERS:

FRANK ~~XXXXXXXXXX~~
1480 JAMESTOWN ST. S.E.
SALEM, OR 97302

RESERVOIR LOCATED FROM
SW CORNER SECTION 28
440 FT EAST
680 FT NORTH

SCALE: 1" = 400'

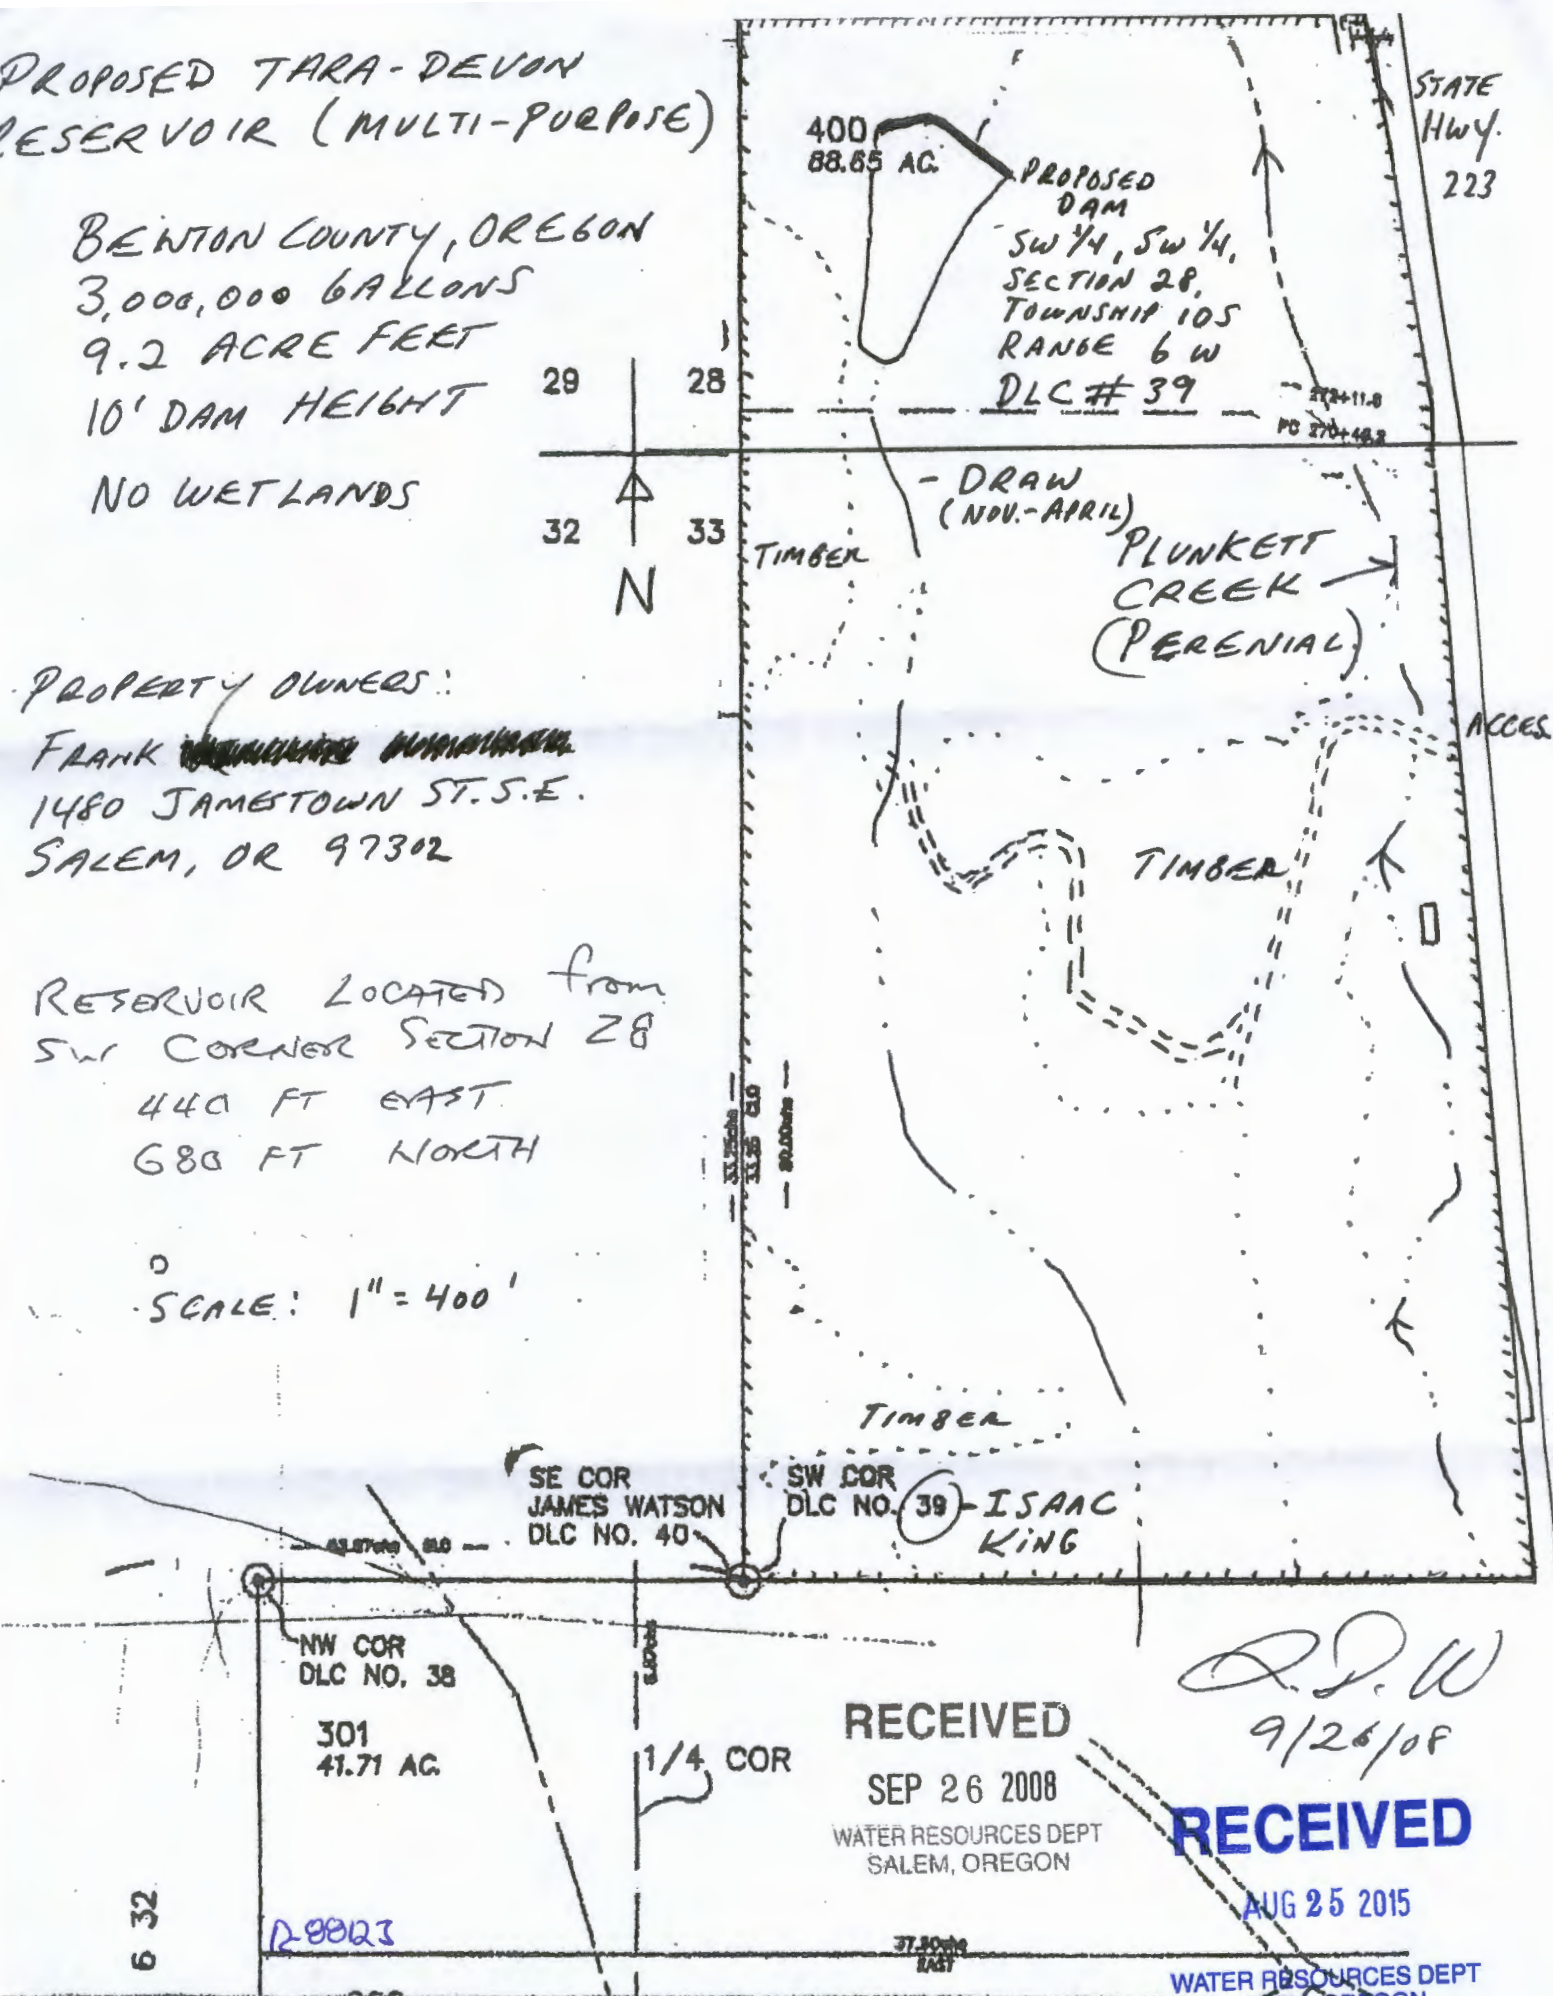

RECEIVED
SEP 26 2008
WATER RESOURCES DEPT
SALEM, OREGON

R.D.W.
9/26/08

RECEIVED
AUG 25 2015

WATER RESOURCES DEPT
SALEM, OREGON

DRAWN TO SCALE WITH INDIA INK
