

Hwy 62

1480 Mill Cr. Dr.  
Prospect, OR  
Lot 801

Road on Property

Convent 

span ditch 

50'

Pond

42'

110'

75'

Road on Property

out Let Control

RECEIVED BY OWRD

AUG 20 2015

SALEM, OR

Mill cr. Dr.  
Road


R-8812

↓ TO Rogue River

# Alternate Reservoir Location Map

## Janet Cook

### Map ID: 33S-2E-12-NW/NW Taxlot 801

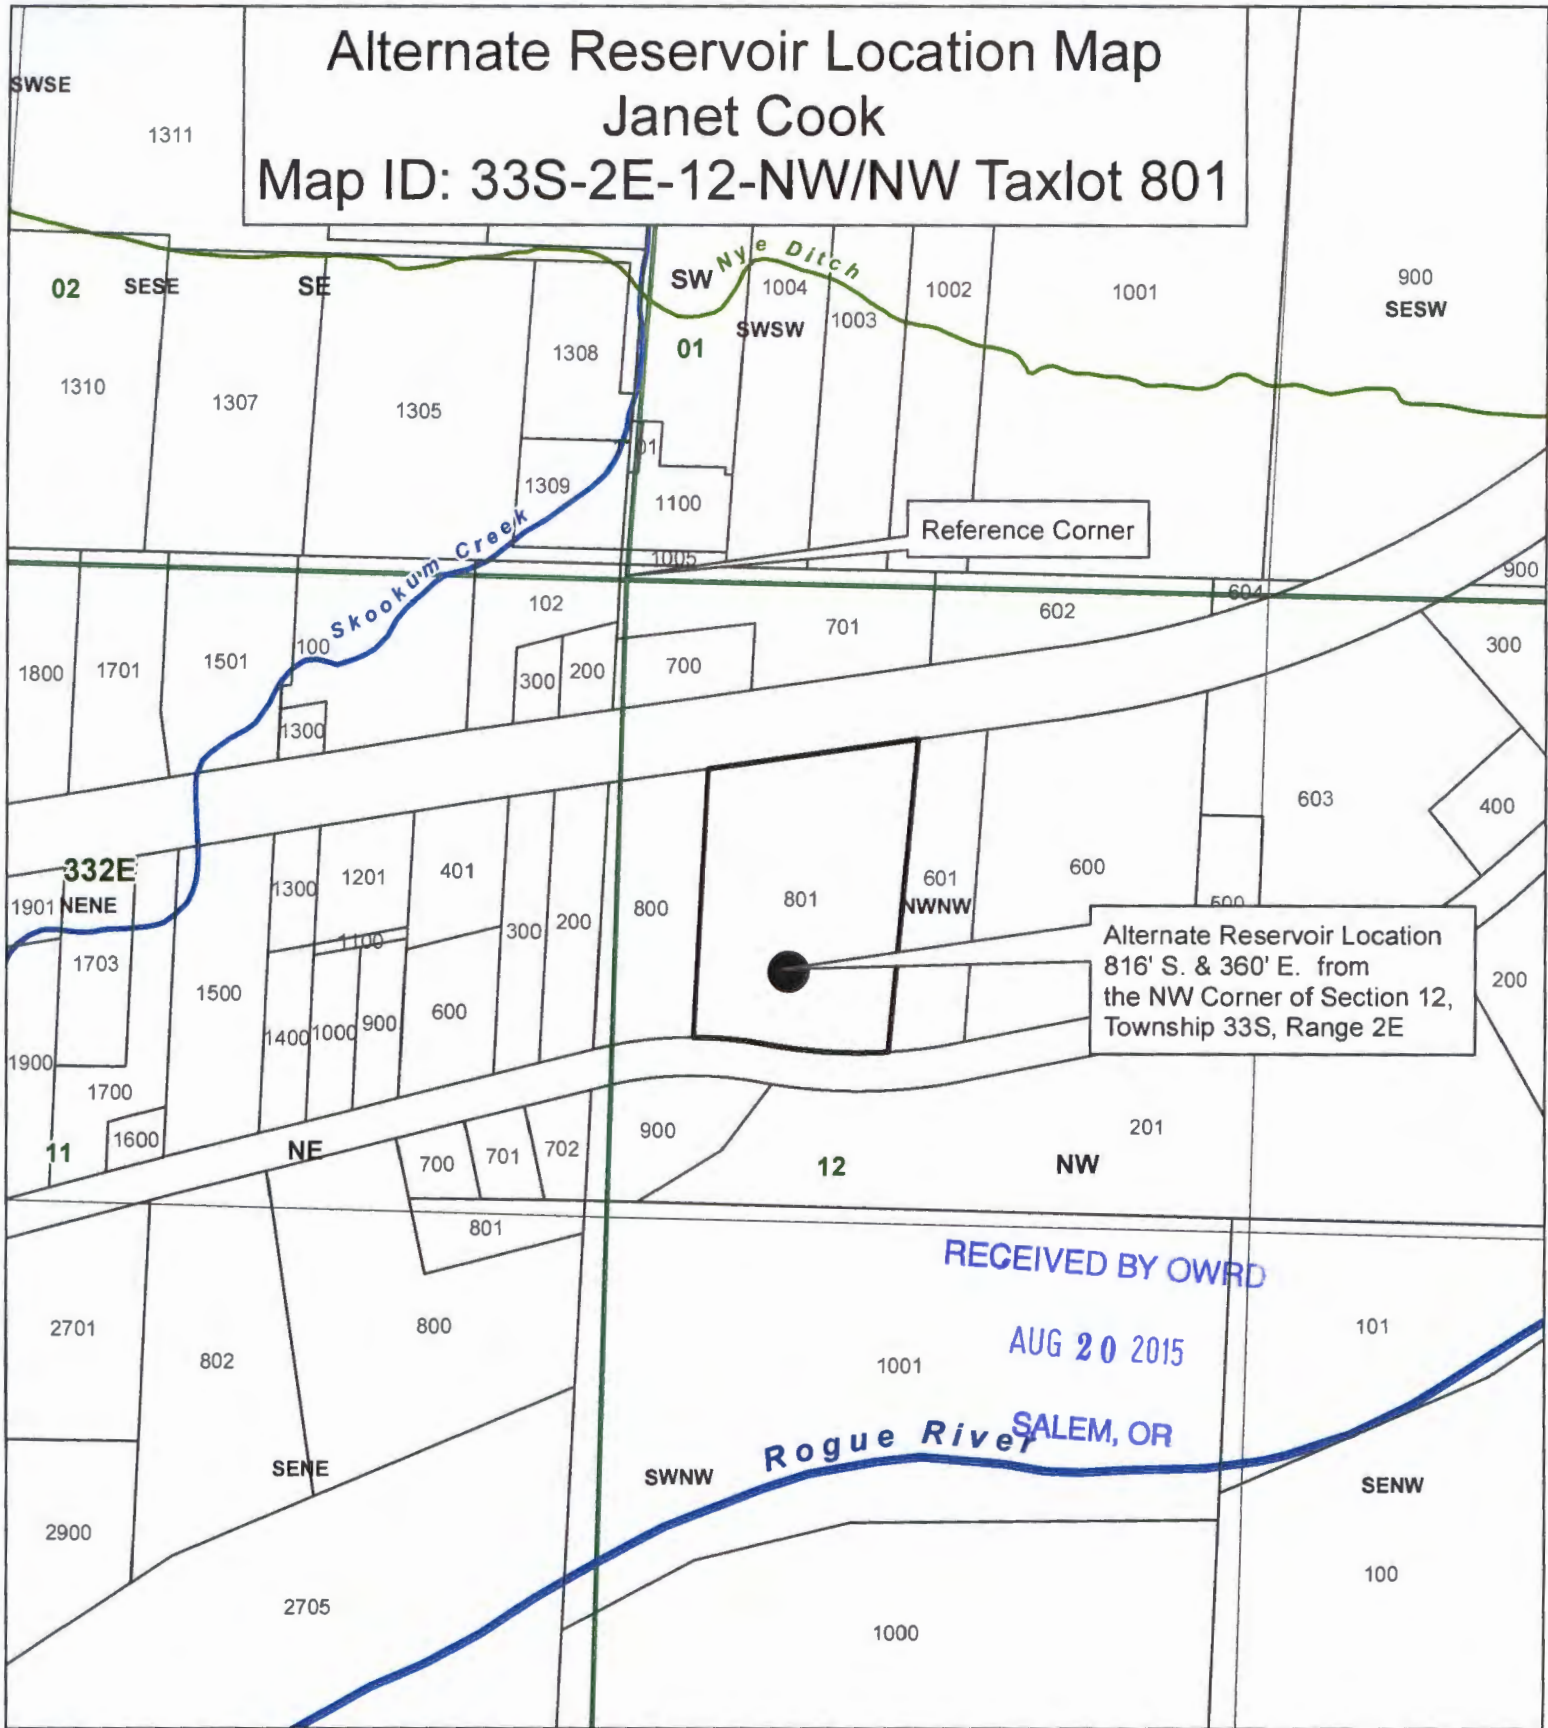


Alternate Reservoir Location  
816' S. & 360' E. from  
the NW Corner of Section 12,  
Township 33S, Range 2E

RECEIVED BY OWRD  
AUG 20 2015  
SALEM, OR

#### Legend

- Alt. Reservoir
- Taxlot 801
- Taxlots
- Townships
- Sections
- Quarter Sections
- Quarter Quarter Sections

1 inch = 400 feet

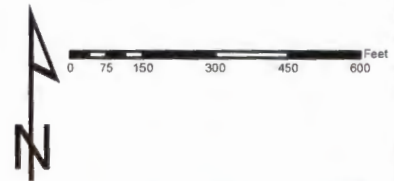

JACKSON COUNTY  
**WATERMASTER**

Prepared by Travis Kelly

This map is based on a digital database compiled by Jackson County from a variety of sources. Jackson County cannot accept responsibility for errors, omissions, or positional accuracy. There are no warranties, expressed or implied.

12-88121