


T. 4N.R. 29E.W.M.

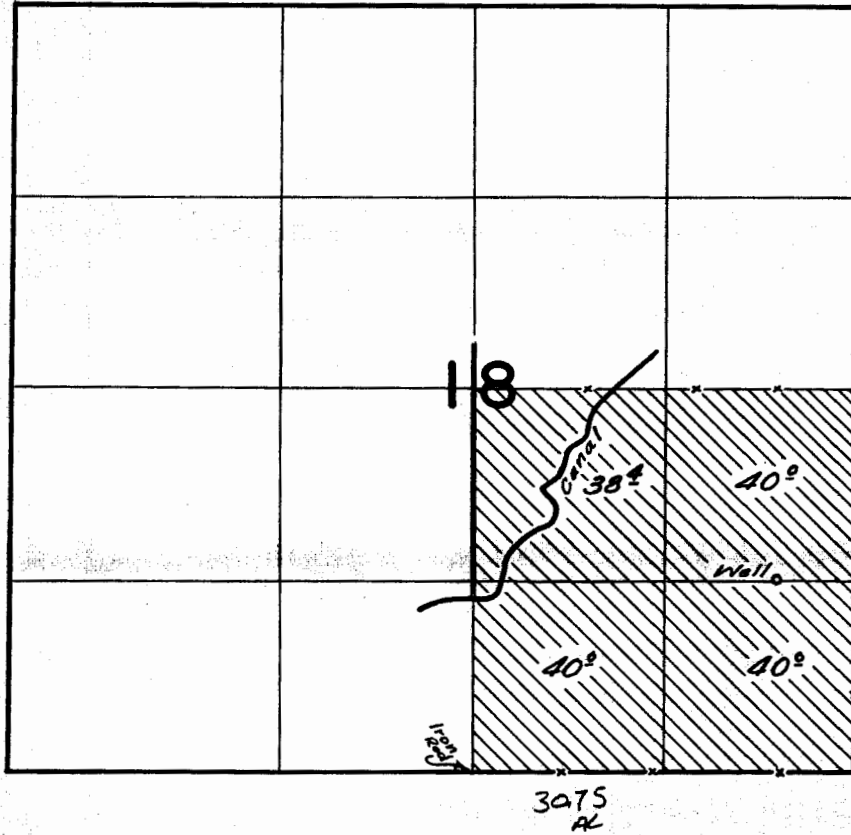

FINAL PROOF SURVEY
UNDER

Application No. 41-56A Permit No. 41-517
IN NAME OF

MILTON & GLADYS CULP

Surveyed Sept. 21, 1961, by CA. Smith