


T.13 & 14 S., R.10 W. W.M.

RECEIVED

NOV 02 1998

WATER RESOURCES DEPT.
SALEM, OREGON

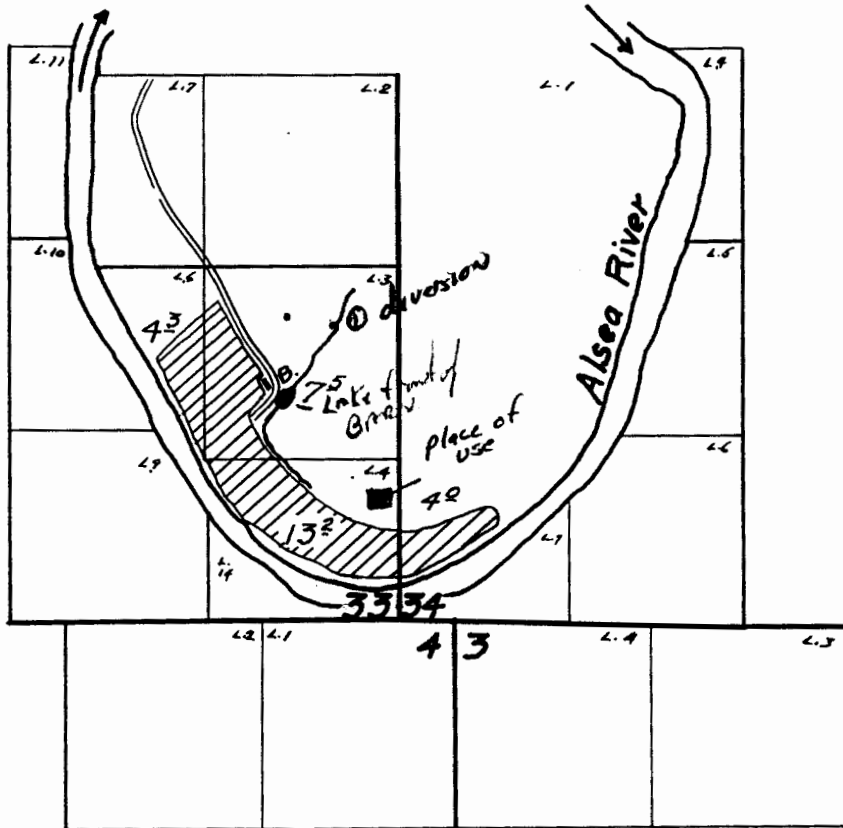

Point of diversion is: 2046' N + 462' W from SE Corner Section 33.

Scale: 1" = 1320'