

FILE #: P79967 RVD SALEM: RVD REGION: COUNTY: JA

NAME: LEONARD L PARRISH ADDRESS: 225 RAPP ROAD CITY, STATE: TALENT, OR PHONE NO. 503-535-6907 EXEMPT? NO

TRSQQ: 38-01-26

MAP & TL: TL 100(7) 38-1N-26C T.L.100

INSPECTED BY: [Signature] INSPECTION DATE: 11/8/95 TALKED TO: (NO ONE HOME)

SOURCE(S) OF WATER: WAGNER CREEK

USE(S) OF WATER: IRRIGATION

DESCRIBE POND: EXCAVATED - OFF CHANNEL

DESCRIBE DAM: EARTHEN DAM 6' HIGH

SURFACE AREA: 270' X 240' (MAX. FULL POOL) = 300' X 300' 2.05A

ASSUMED AVERAGE DEPTH: 5'

DISCREPANCIES:

1.485A  
5'  
0.4  
-----  
9.0AC

REMARKS: FILLS POND DURING IRRIGATION SEASON FOR IRRIGATION.

CT: 16056

ROGUE RIVER DEGREE.

AERIAL PHOTO VERIFIED

POND GUESSED TO BE BUILT

~~TLD USE AERIALS~~

~~WAGNER CREEK ON TLD 100~~

~~1.485A  
5'  
0.4  
-----  
2.9 ≈ 3.0 ACFT  
TOTAL~~

RECEIVED

MAY - 2 1997


PROPOSED

CEPTION AREAS WITH

JACKSON COUNTY

3816

WATER RESOURCES DEPT.  
SALEM, OREGON

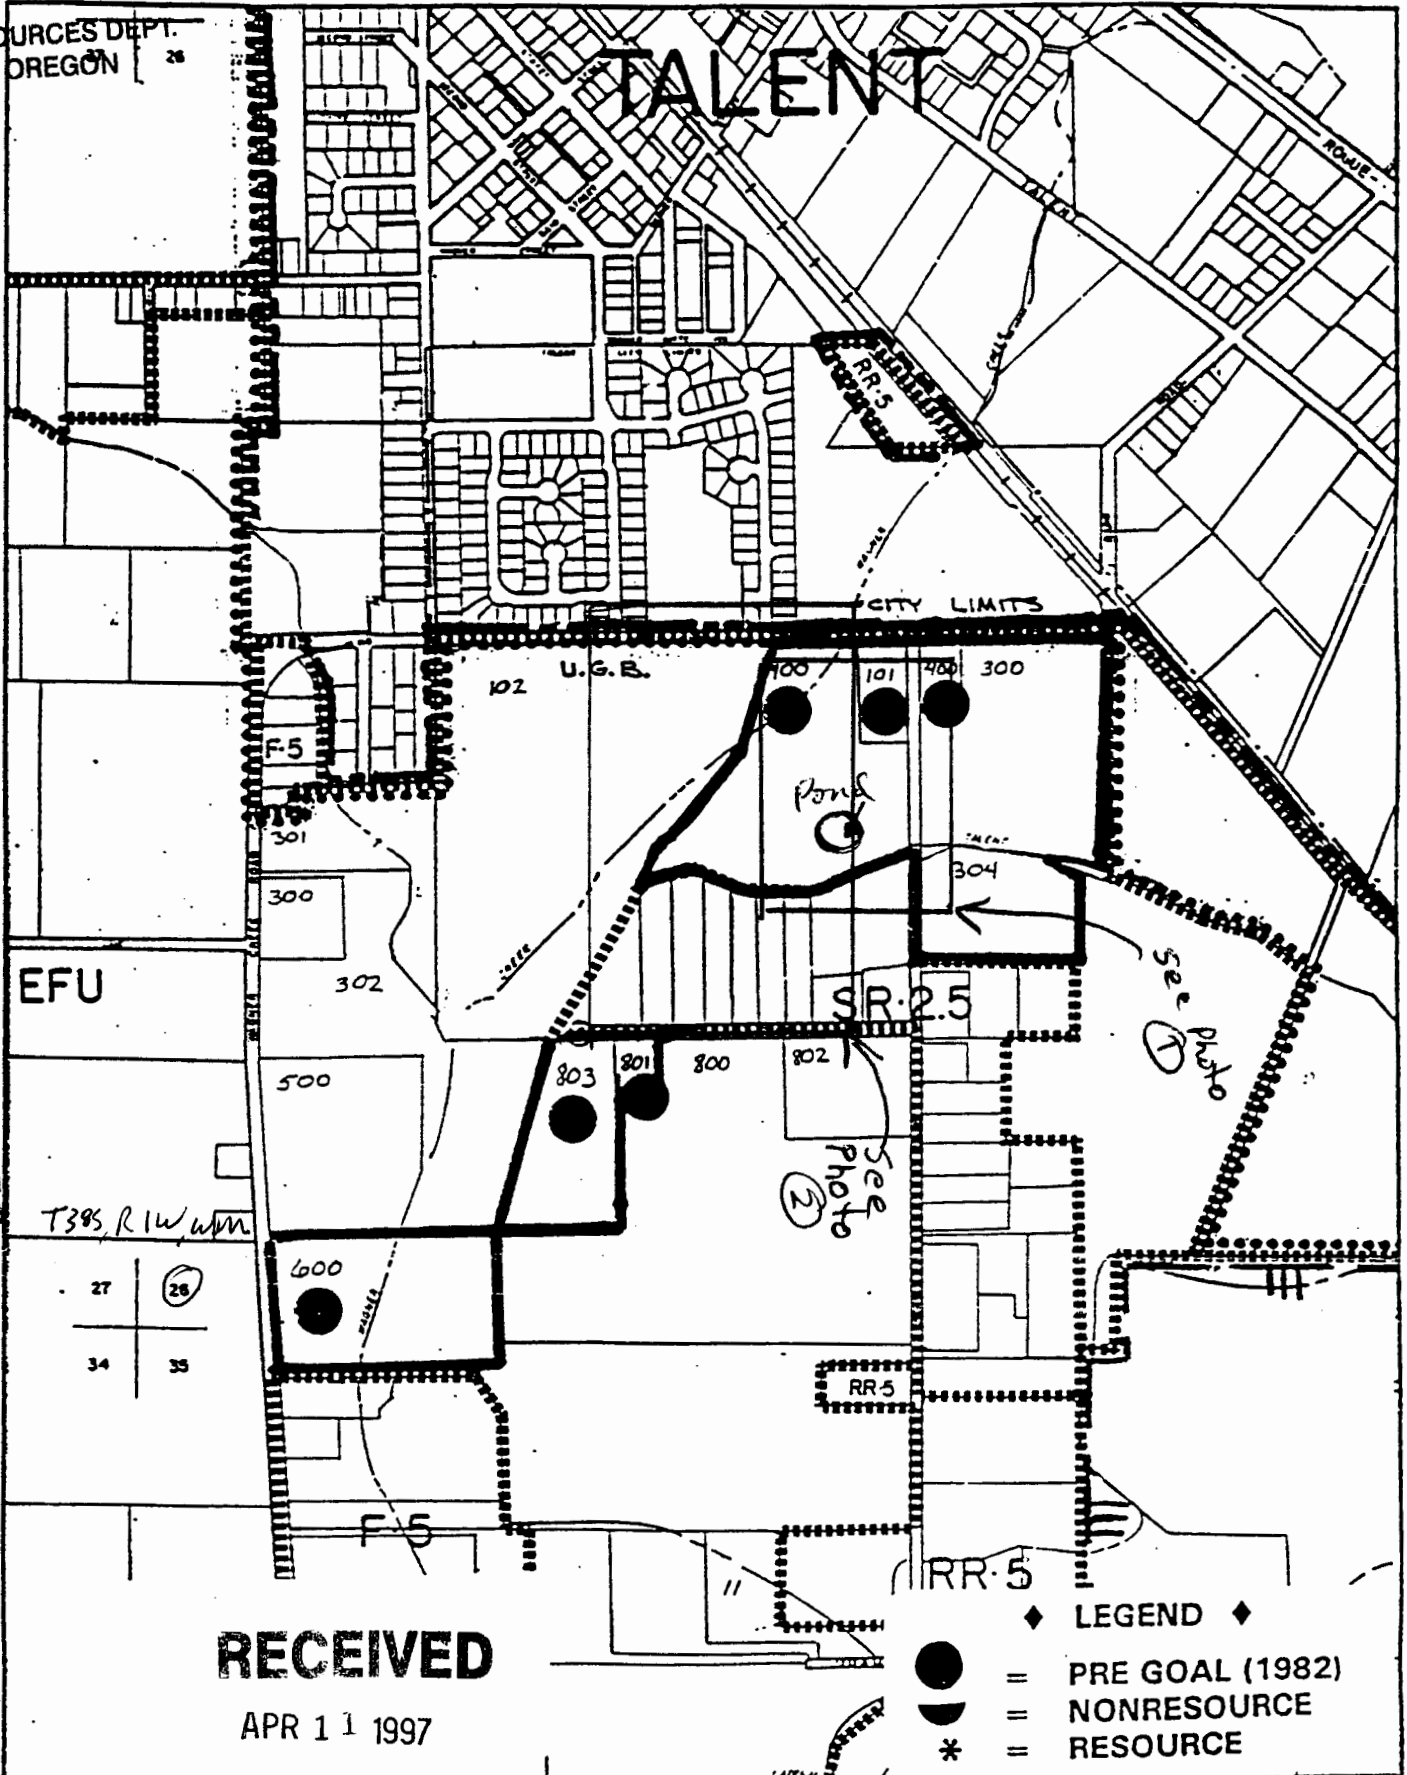

Copy Added to P-79967 on 12/5/87 DS  
From File R-83304

RECEIVED

APR 11 1997

6/21/93 WATER RESOURCES DEPT.  
SALEM, OREGON



ZONING



MAP 2  
AREA FF