


T. 17S., R. 23E., W.M.

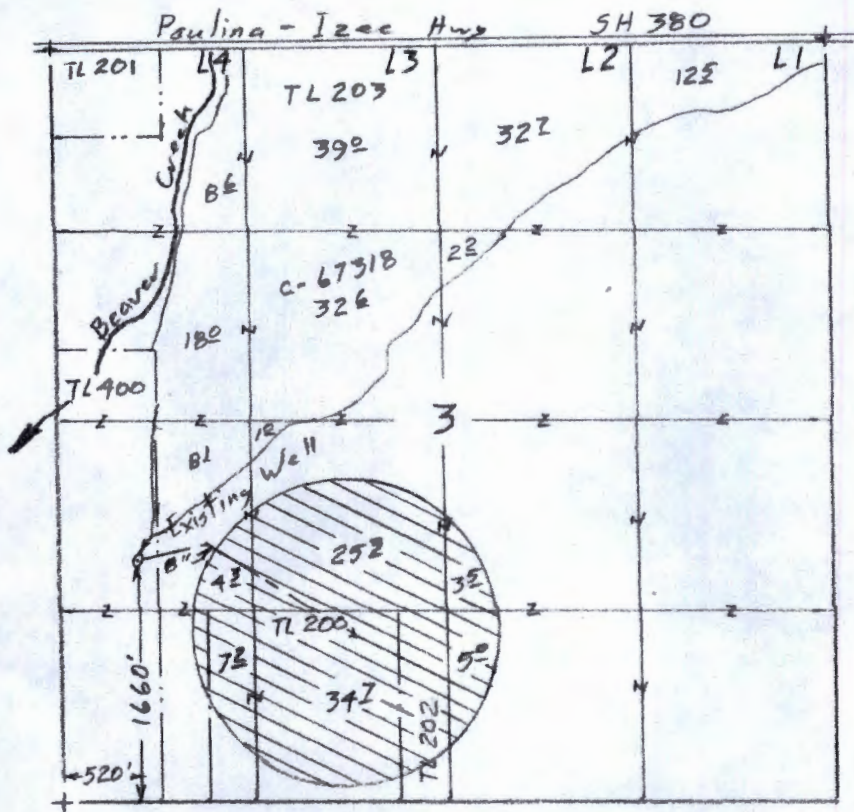

Scale 1"=1320'
(4"=1 mile)

⊗ 80[±] acres

Application Map
for
JOHN GIORGI


RECEIVED BY OWRD

SEP 18 2015

SALEM, OR

G-18142

This map is for the purpose of locating a water right only and has no intent to provide legal dimensions or the location of property lines.

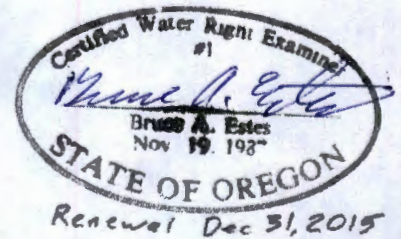

ESTES SURVEYS

PO Box 17616
Salem, OR 97305-7516
(503) 566-7000

60382 Arnold Rd
Bend, OR 97702
(541) 382-7391