


13 S. 3 W.

Section 23

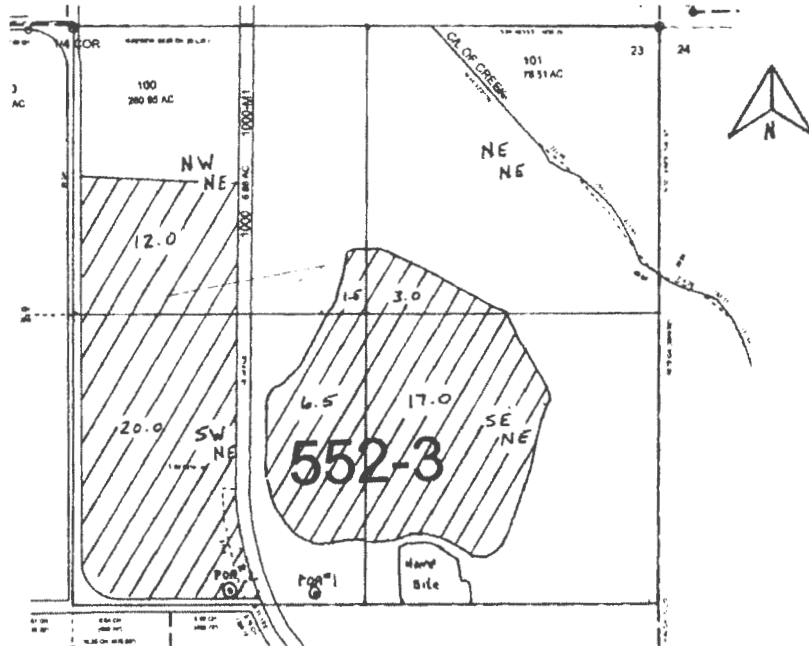

From the center of section 23:

P.O.A. 1- Approx. 1000' East and 75' North

P.O.A. 2- Approx. 700' East and 75' North

1" = 800'

Map prepared with the assistance of C.S.G. and is to demonstrate the location of a water right. It is not the intent of this map to indicate property boundaries or ownership.

RECEIVED

SEP 10 2015

WATER RESOURCES DEPT
SALEM, OREGON

HP Sept 2015

G-18138