

This map was prepared for assessment purposes only


SECTION 32 T3S R1E W.M.

CLACKAMAS COUNTY

1" = 400'

D.L.C. 2
C. PENDLETON NO. 58
LUCIUS A. SEELY NO. 57B 4B

3 IE 32
& INDEX

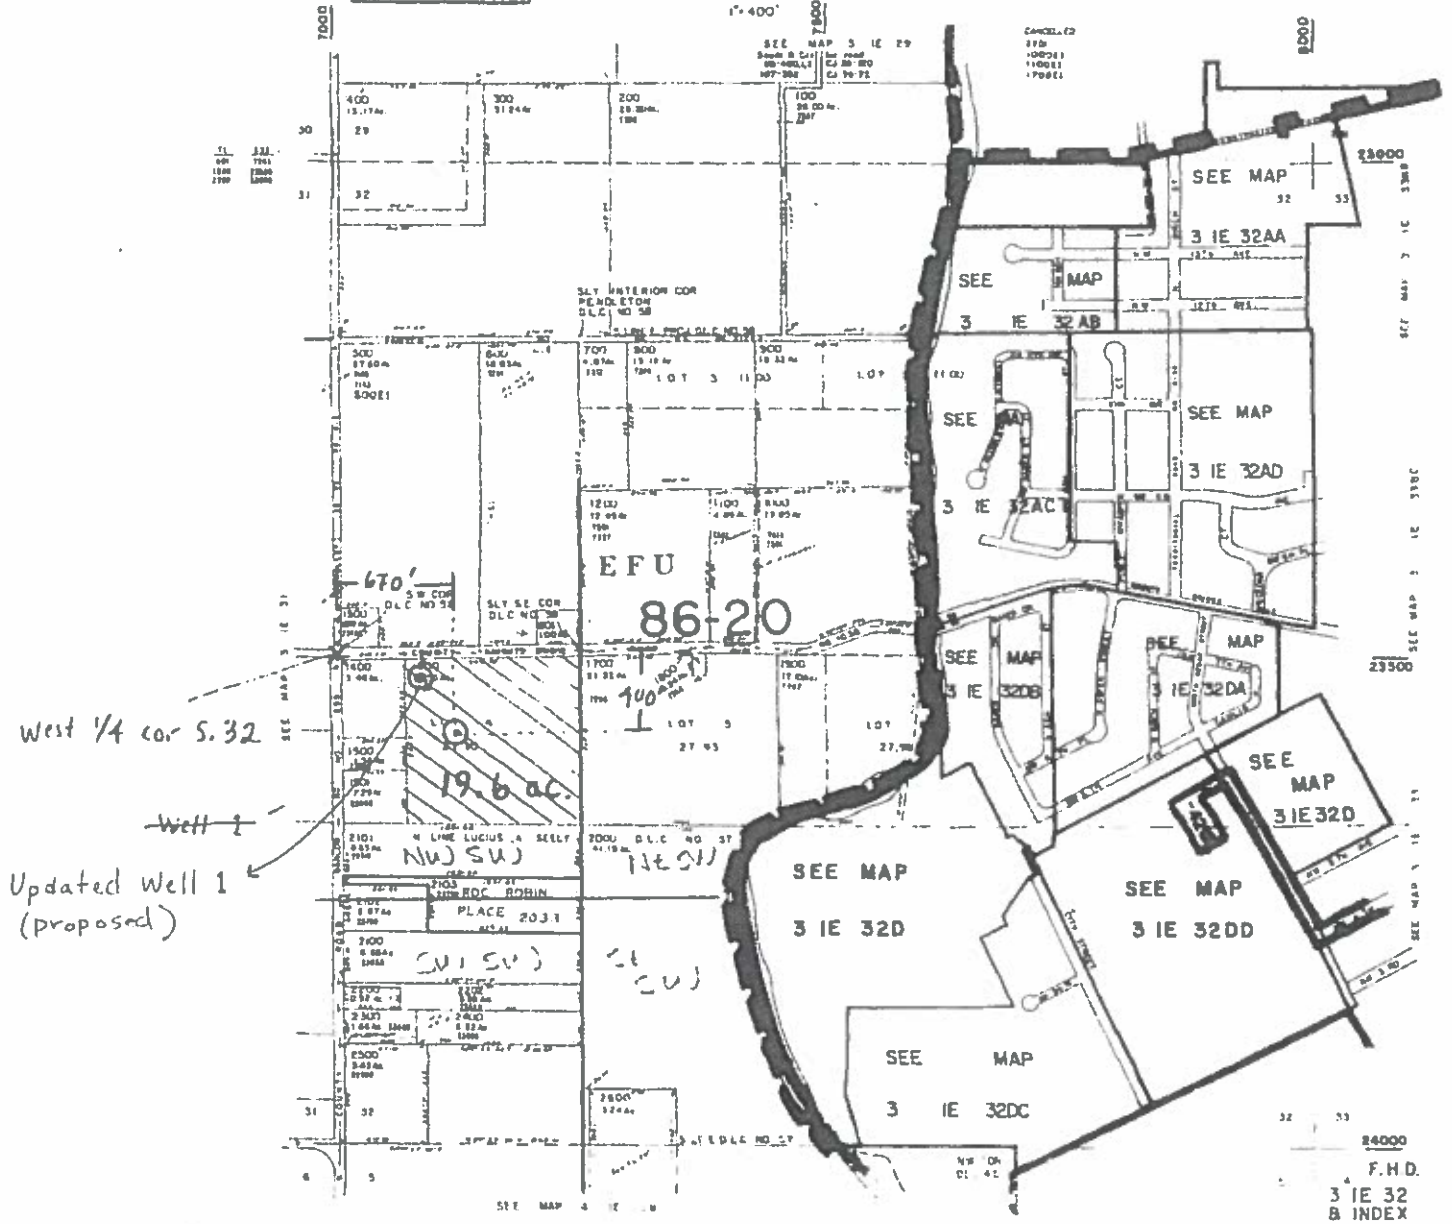

T3S R1E Section 32, TL 1600

NW-SW
450'E, 110'S (updated)
Well 1 located ~~670'E, 400'S~~
from West 1/4 cor. Section 32



Area to be irrigated

1" = 1000'

0 500' 1000' 2000'

RECEIVED
FEB 17 2016
OWRD

RECEIVED BY OWRD

UPDATED APPLICATION MAP

CH-19140