

RECEIVED

SEP 28 2015

WATER RESOURCES DEPT
Salem, Oregon

9-5

RES. LOCATED:
970 FT. NORTH
1600 FT. EAST
FROM
SW COR. SEC. 32

PARTITION

PLAT

2011-14

PARCEL 1

PARCEL 2

01N09W32

RIVER

ROAD

01N09W32D

PTN. PARCEL 1

PARTITION

PARTITION

RIVER

PTN. P.P. 601 P.2
2.80 AC.

602 2.70 AC. 1996-66

P.3
(OLD)

ROAD

PARTITION PLAT
2002-14

FOREST

PLAT

2002-14

PARCEL 2 S 1/4

HISTORICAL
1/16 COR

PORTION
PARCEL 1

KILCHIS RIVER
31

32

KILCHIS

700
4.40 AC.

205 OS
3.60 AC.

201

ROAD

207
15.60 AC.

01S09W06


FOREST 290 OS

204
24.96 AC.

01S09W

1" = 400 FT.

SEE MAP 1S:9W

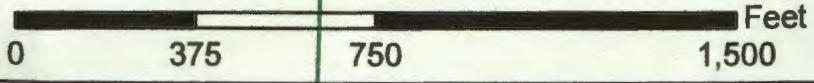

R-2813



9-2

RECEIVED

PARCEL 1
PARCEL 5

PARCEL 1
PARCEL 5

1000
1000
1000



RECEIVED

RECEIVED