

Oregon Water Resources Department
 725 Summer Street NE, Suite A
 Salem Oregon 97301-1266
 (503) 986-0900
 www.wrd.state.or.us

Certificate of Water Right Ownership Update

NOTICE TO SELLERS & BUYERS:

By law, all water belongs to the public (ORS 537.110). In almost every instance, a permit or water right certificate from the Water Resources Department is needed before using, diverting or storing water (ORS 537.130). However, most domestic wells do not require water rights. A certificate of water right stays with the land. In order to keep track of water right ownership, the Department requests that this form be submitted to the Department. *If for multiple rights, a separate form for each right will be required.*

Water that has been used for a long time in one place or that involves a water structure (like a dam) that already exists is no guarantee that there is a water right which would allow the water use to continue.

If you have any questions about this form or water right requirements, please contact your local watermaster or call the Water Resources Department at 503-986-0900.

Note: Please type or print legibly when filling in the following information. Use additional paper if necessary.

PROPERTY SELLER INFORMATION

Applicant(s): Dale Herr
First Last
 Mailing Address: 707 Foothill Drive
Ontario OR 97914
City State Zip
 Phone: 541-212-6021
Home Work Other

RECEIVED BY OWRD

PROPERTY BUYER INFORMATION

Applicant(s): Robert Milner
First Last
 Mailing Address: 2076 S. Union Rd.
Manteca CA 95337
City State Zip
 Phone: 209-479-3057
Home Work Other

JUL 24 2015

SALEM, OR

PROPERTY DESCRIPTION (attach additional pages if necessary):

County: Malheur Township: 18 S. Range: 46 E. Section: 2

Tax Lot Number(s): 1600

Street address of water right property: 737 Foothill Drive, Ontario, OR 97914

Water Right Information (attach copy of water right permit or certificate & final proof map):

Application #: 540778 Permit #: 30387 Certificate or Page #: Page 48281 - Vol 41

Will all the lands associated with this water right be owned by the buyer? Yes No part of

Name of individual completing this form: Sharon L. Miles Phone: 541-889-7625

Signature: Sharon L. Miles Date: 7-21-15

Please be sure to attach a copy of your property deed or legal description of the property.

Note: Seller was not sure of this water right however, watermaster told buyer it applies.

STATE OF OREGON

COUNTY OF

MALHEUR

CERTIFICATE OF WATER RIGHT

This Is to Certify, ThatSTANLEY C. CHANDLER, EDWARD P.
& JANET A. STANTON

of Rt. 3, Box 378, Ontario, State of Oregon, 97914, has made proof to the satisfaction of the Water Resources Director, of a right to the use of the waters of Malheur River

a tributary of Snake River
irrigation of 88.5 acres

for the purpose of

under Permit No. 30387 and that said right to the use of said waters has been perfected in accordance with the laws of Oregon; that the priority of the right hereby confirmed dates from April 19, 1965

that the amount of water to which such right is entitled and hereby confirmed, for the purposes aforesaid, is limited to an amount actually beneficially used for said purposes, and shall not exceed 2.2 cubic feet per second

or its equivalent in case of rotation, measured at the point of diversion from the stream. The point of diversion is located in the SE $\frac{1}{4}$ SW $\frac{1}{4}$, Section 2, T. 18 S., R. 46 E., W. M., North diversion-1350 feet South and 1070 feet West from the Center of Section 2; South diversion-20 feet North and 1280 feet West from the S $\frac{1}{2}$ Corner, Section 2

The amount of water used for irrigation, together with the amount secured under any other right existing for the same lands, shall be limited to one-fortieth of one cubic foot per second per acre, or its equivalent for each acre irrigated and shall be further limited to a diversion of not to exceed 3 acre feet per acre for each acre irrigated during the irrigation season of each year,

and shall

conform to such reasonable rotation system as may be ordered by the proper state officer.

A description of the place of use under the right hereby confirmed, and to which such right is appurtenant, is as follows:

27.6 acres SE $\frac{1}{4}$ SW $\frac{1}{4}$
19.4 acres NW $\frac{1}{4}$ SE $\frac{1}{4}$
38.2 acres SW $\frac{1}{4}$ SE $\frac{1}{4}$
3.3 acres SE $\frac{1}{4}$ SE $\frac{1}{4}$
Section 2

T. 18 S., R. 46 E., W. M.

RECEIVED BY OWRD


JUL 24 2015

SALEM, OR

The right to the use of the water for the purposes aforesaid is restricted to the lands or place of use herein described and is subject to the existing minimum flow policies established by the Water Policy Review Board.


WITNESS the signature of the Water Resources Director, affixed

this date. July 3, 1979

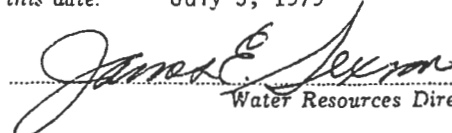
Water Resources Director

Recorded in State Record of Water Right Certificates, Volume 41, page 48281

T. 18 S. R. 46 E. W. M.

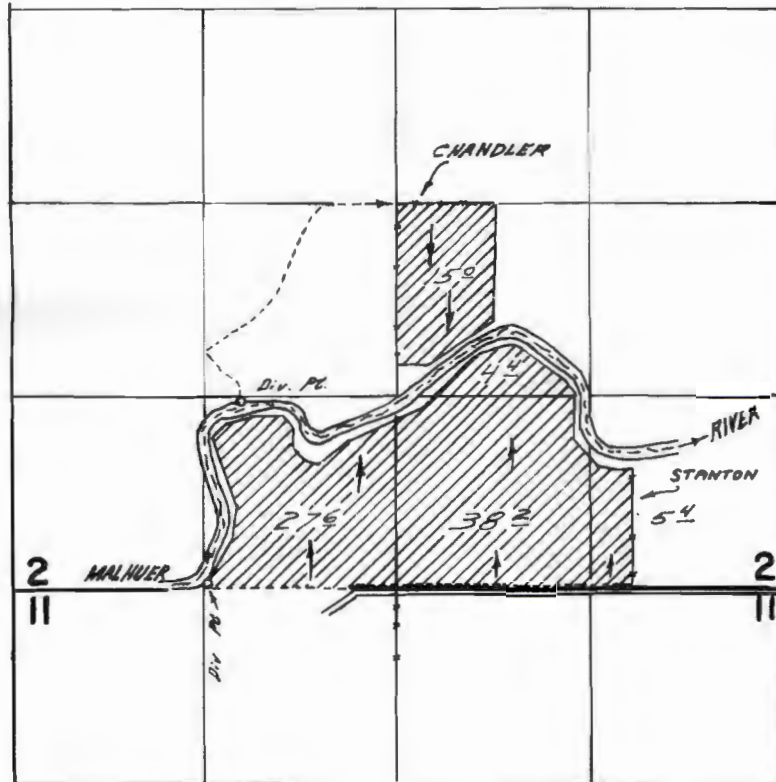

North diversion point located 1350 ft. S & 1070 ft. W. from
NW Corner of SE 1/4 Section 2.

South diversion point located 20 ft. N. & 1280 ft. W. from
S. 1/4 Corner Section 2.

RECEIVED BY OWRD

JUL 24 2015

SALEM, OR

FINAL PROOF SURVEY UNDER

Application No. 40772 Permit No. 30387
IN NAME OF

STANLEY C. CHANDLER, EDWARD P. & JANET A. STANTON

Surveyed Oct. 25, 1967, by W. d. Ruppert
Nov. 2

(G#45-5)

PTS-1967-A
PTS-1967-P