


Christopher Barnes

1" = 1320'

Tax Lot:

Township 3 South, Range 5 West, Section 15, SWSW, Tax Lot 700

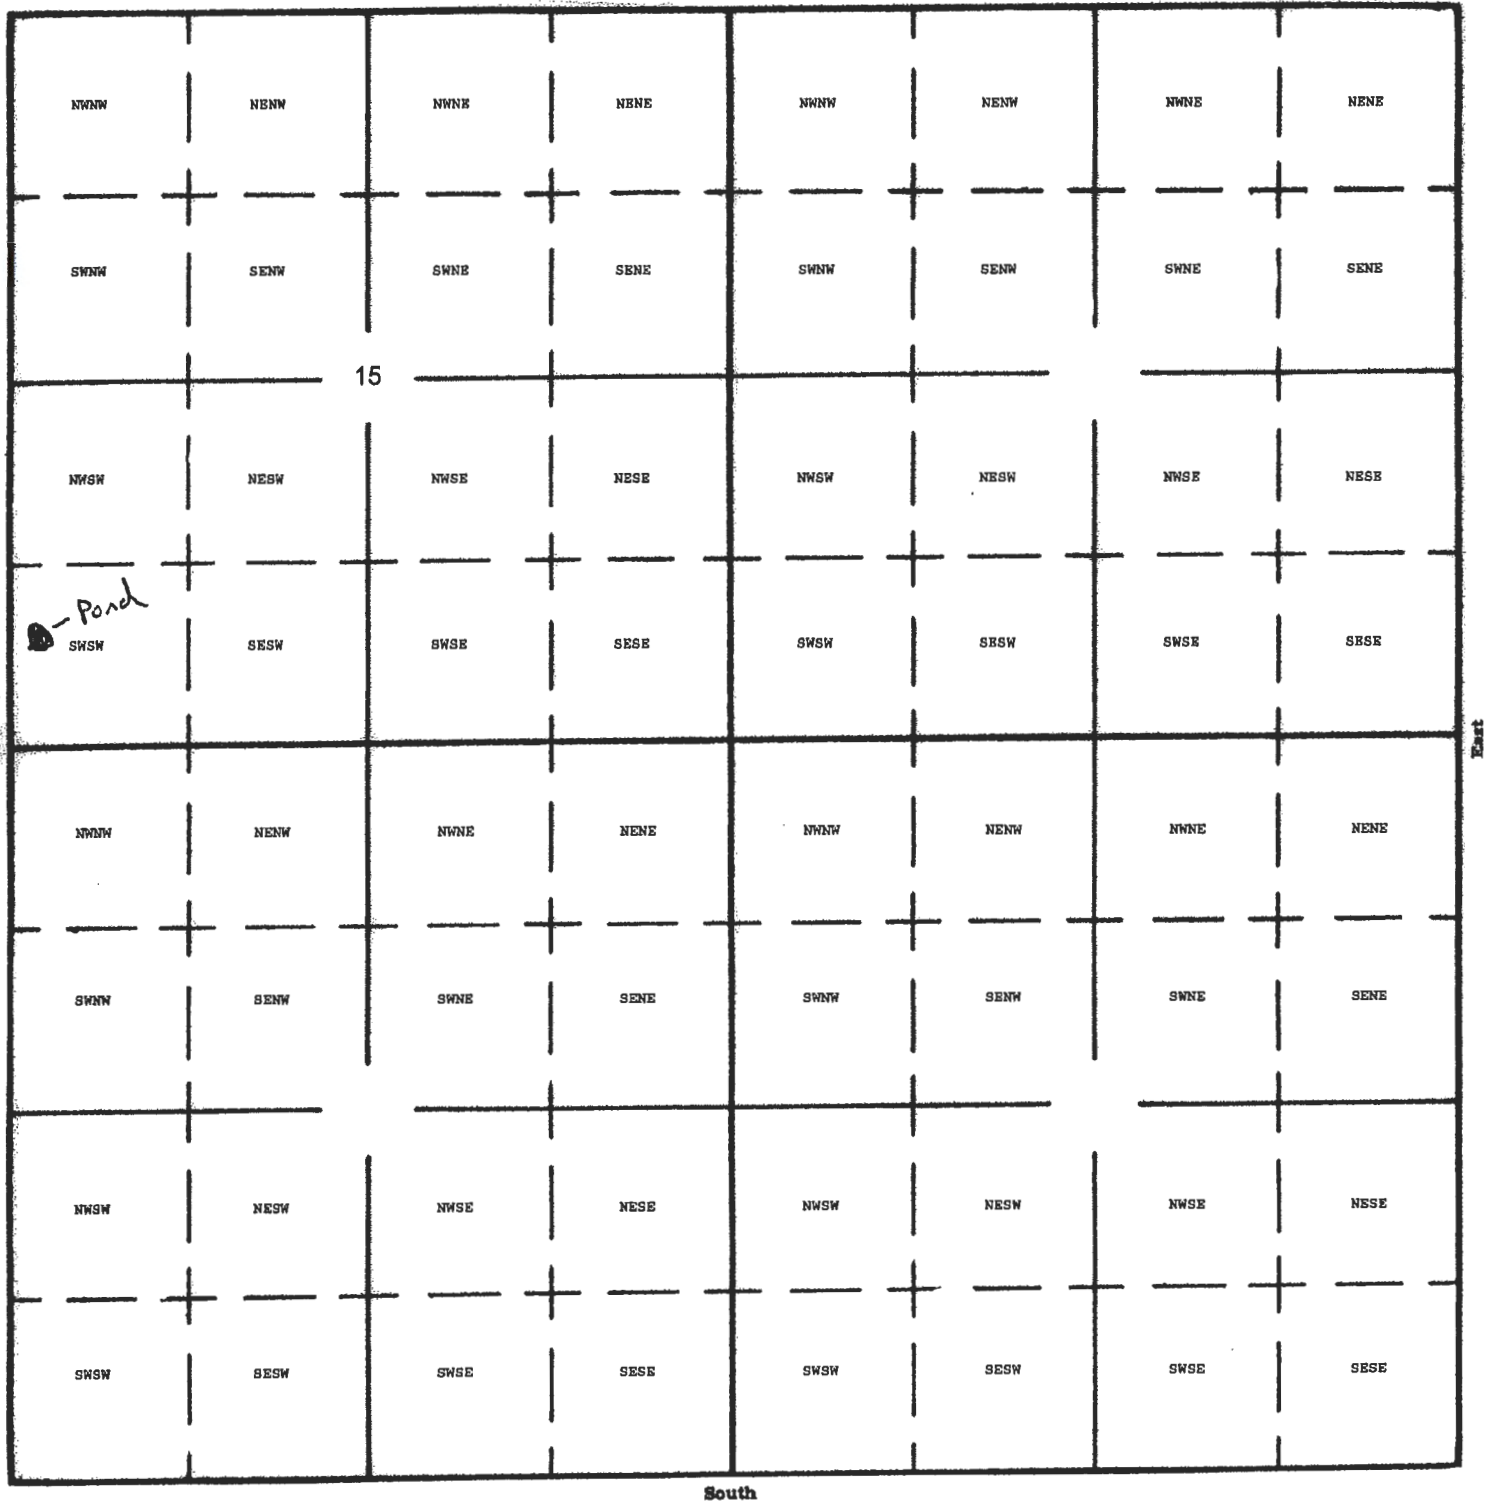

Dam Location: 710 Feet North and 230 Feet East from SW Corner Section 15

RECEIVED BY OWRD

OCT 07 2015

SALEM, OR