


RECEIVED BY OWRD

SEP 30 2015

SALEM, OR

T 18 S., R 3 W

Section 29

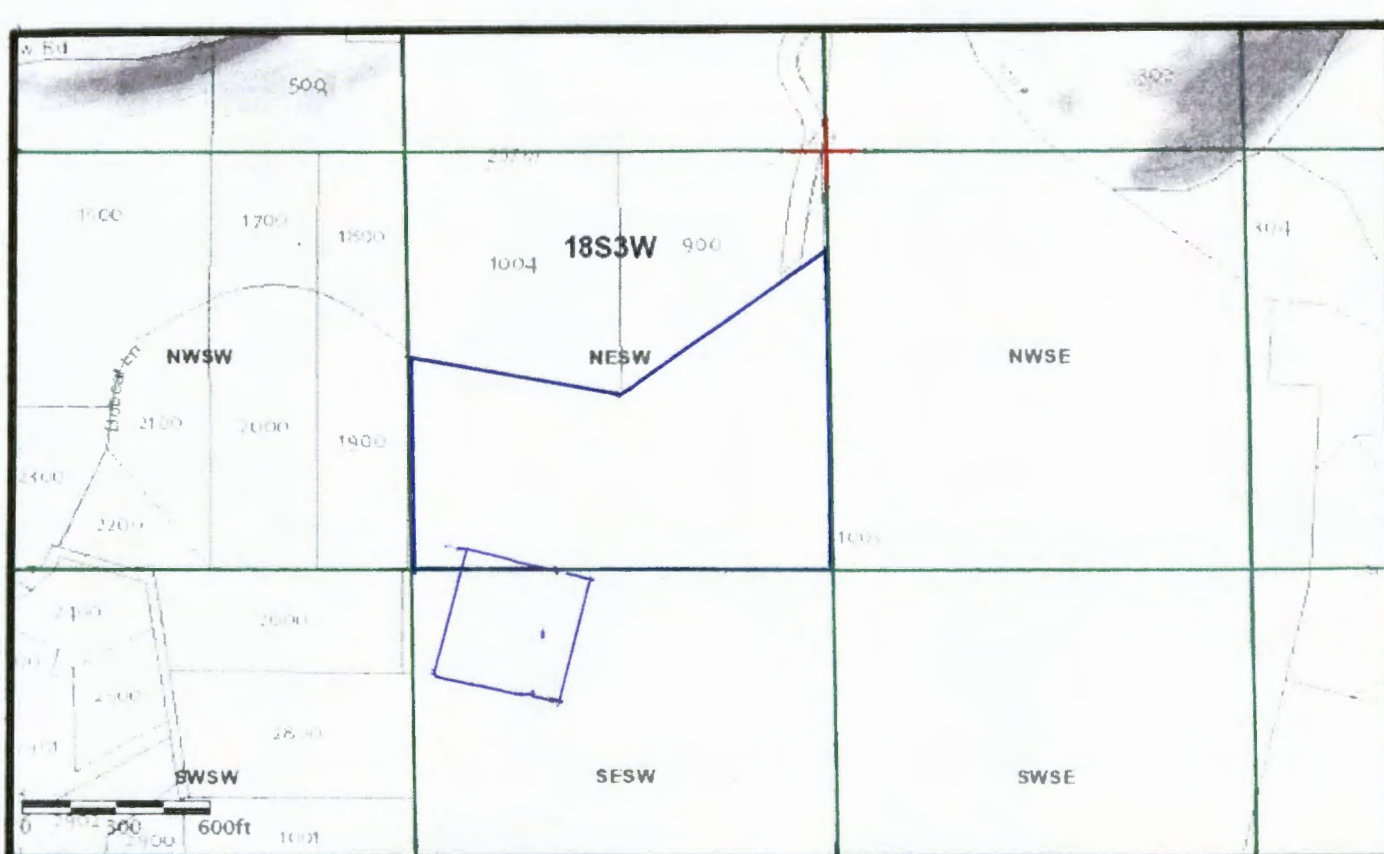

Center of dam located 1425 feet South and 890 feet West from the center of Section 29, Township 18 S, Range 3W.

Center of dam is (GPS) 10T 0493483
486 8679 WGS 84

Scale: 1" = 600'

R-00155-