


T. 40 S. R 19 E W.M.

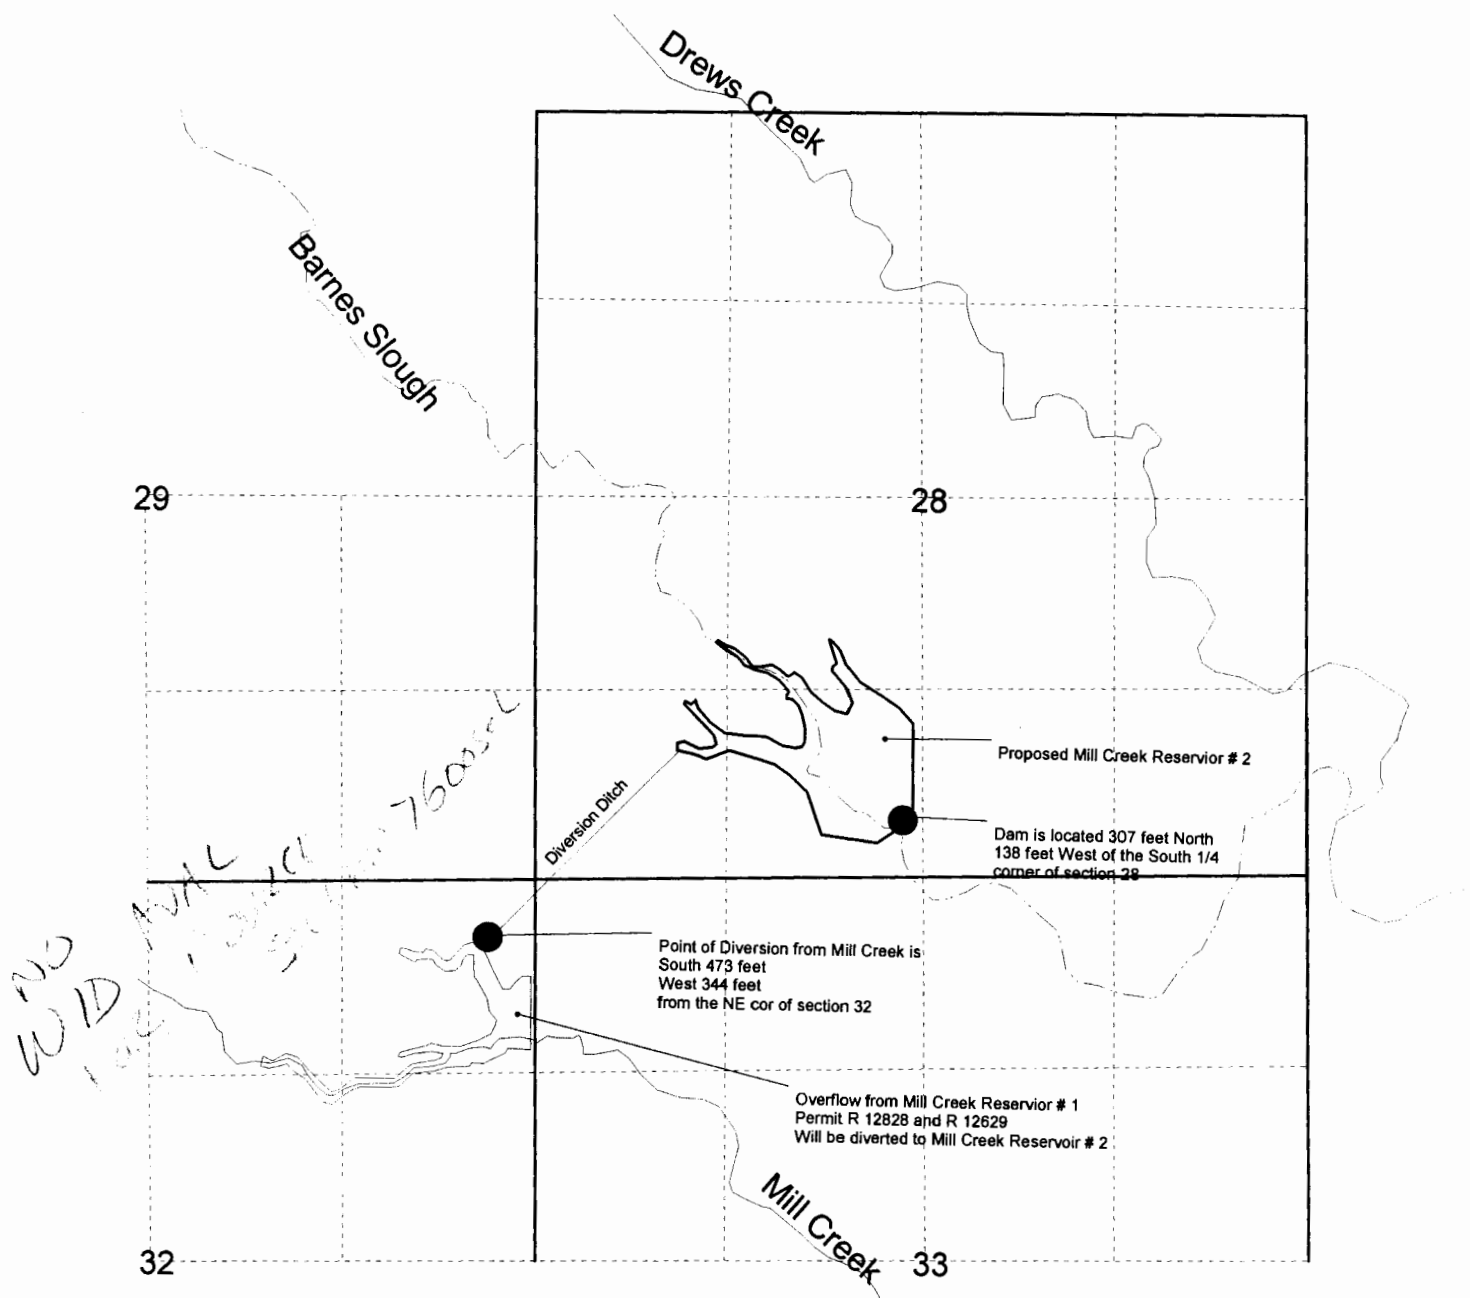

Point of Diversion and Reservoir are located in
Tax Lot 40S19E 0 Lot 7000

RECEIVED

MAR 20 2001

**WATER RESOURCES DEPT.
SALEM, OREGON**



Scale 1" = 1320'