

ENVIRONMENTAL QUALITY SECTION

PLANNING & DEVELOPMENT SERVICES • 10 SOUTH OAKDALE • MEDFORD, OREGON 97501 • (503) 776-7554

Name: WENDELL R. BALDWIN

Twp: 39S Range: 4W Section: 08 Tax Lot: 500

Address (location) 4835 THOMPSON CR. RD.

System Type STANDARD

PERMIT# 15-489-94N

<p>TANKS AND SEWER LINES</p> <p>Effluent Sewer <u>NA</u> Pressure Transport Pipe <u>595' 2" PVC</u> Septic Tank Size <u>1600 Dbl X</u> Material & Manuf. <u>CEM. - RIVERSIDE</u> Dosing Tank Size <u>2ND COMPARTMENT</u> Material & Manuf. Fittings, Connections <u>OK</u> Riser(s) <u>1 CEM, 1 PVC</u> Tank to House <u>16'</u></p>	<p>DRAINFIELD</p> <p>Staking Date <u>NA</u> Install Date <u>7-14-95</u> Trench Width <u>24"</u> Trench Depth <u>24" - 32"</u> Gravel Depth <u>12"</u> Lines Level <u>OK</u> Distance Between Lines <u>11'</u> Overflows <u>OK</u> Undisturbed Earth <u>OK</u> Drop Boxes <u>NO</u> Line End Caps <u>OK</u> Total Lineal Feet <u>380'</u> Distance Well to: Tank <u>>100'</u> Drainfield <u>180'</u></p>	<p>PUMP/SIPHON SYSTEMS</p> <p>Date <u>7-14-95</u> Type & H.P. <u>Franklin 1/2 HP</u> Floats: Sgl <u>X</u> Dbl Valves: Check <u>X</u> Gate <u>X</u> Safety Line <u>X</u> Screen <u>X</u> Quick Disconnect <u>X</u> Block <u>X</u> Alarm <u>X</u> Alarm Float <u>X</u></p>
<p>ETA</p> <p>Bed Ck Date <u>NA</u> Bed Depth: up dn Length Width Gravel & Pipe Cover Depth Date</p> <p>LOW PRESSURE DISTRIB.</p> <p>Pressure Test Date <u>NA</u> Hole Spacing Discharge Filter Fabric Hydrosplitter</p> <p>CAPPING FILL</p> <p>Scarified Date <u>NA</u> Cap Depth Date</p>	<p>SAND FILTER/TRENCH</p> <p>Trench: Date <u>NA</u> Width Depth Box Inspect Date <u>NA</u> Size Pres. Date Discharge Sand Sieve Analysis Filter Fabric Effluent Sewer/Pres. Pipe Cover Depth Date</p> <p>FILTER PUMP SYSTEM</p> <p>Type & H.P. Date <u>NA</u> Floats: Sgl Dbl Fabric Under Vault Valves: Check Gate Safety Line Quick Disconnect Alarm Alarm Float Primary Pump Shutoff</p>	<p>TILE DEWATERING</p> <p>Staking Ck Date <u>NA</u> Trench Ck Date Rock & Pipe Date Silt Trap Dia. Flapgate Sch 80 Backfill Date</p> <p>CURTAIN DRAIN</p> <p>Date <u>NA</u> Depth Rock Depth Visqueen Screen Sch.40 End(s) Vditch Berm</p>

INSTALLER: MIKE OFFENBACHER


INSPECTION DATES: 7-14-95 KC
7-14-95 KC

SYSTEM CONSTRUCTION DIAGRAM

RECEIVED

JAN 31 1997

WATER RESOURCES DEPT.
 SALEM, OREGON

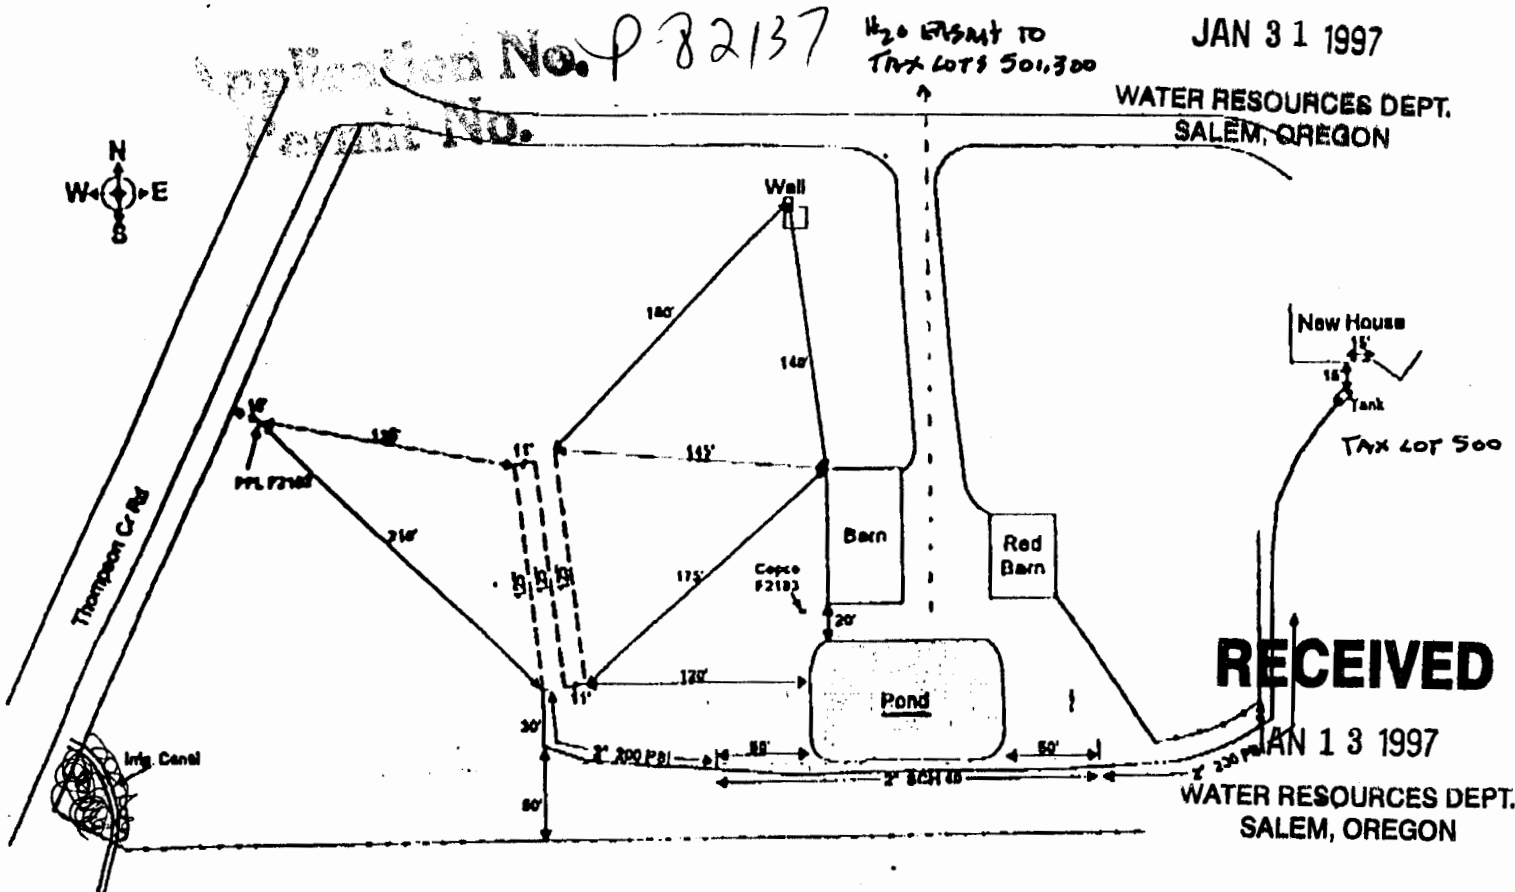

RECEIVED

JAN 13 1997
 WATER RESOURCES DEPT.
 SALEM, OREGON

V39-072240

RECEIVED



SECTION 8 T39S R4W

JAN 31 1997

SCALE 1"=400'

WATER RESOURCES DEPT.
SALEM, OREGON

39 4W 5

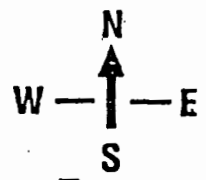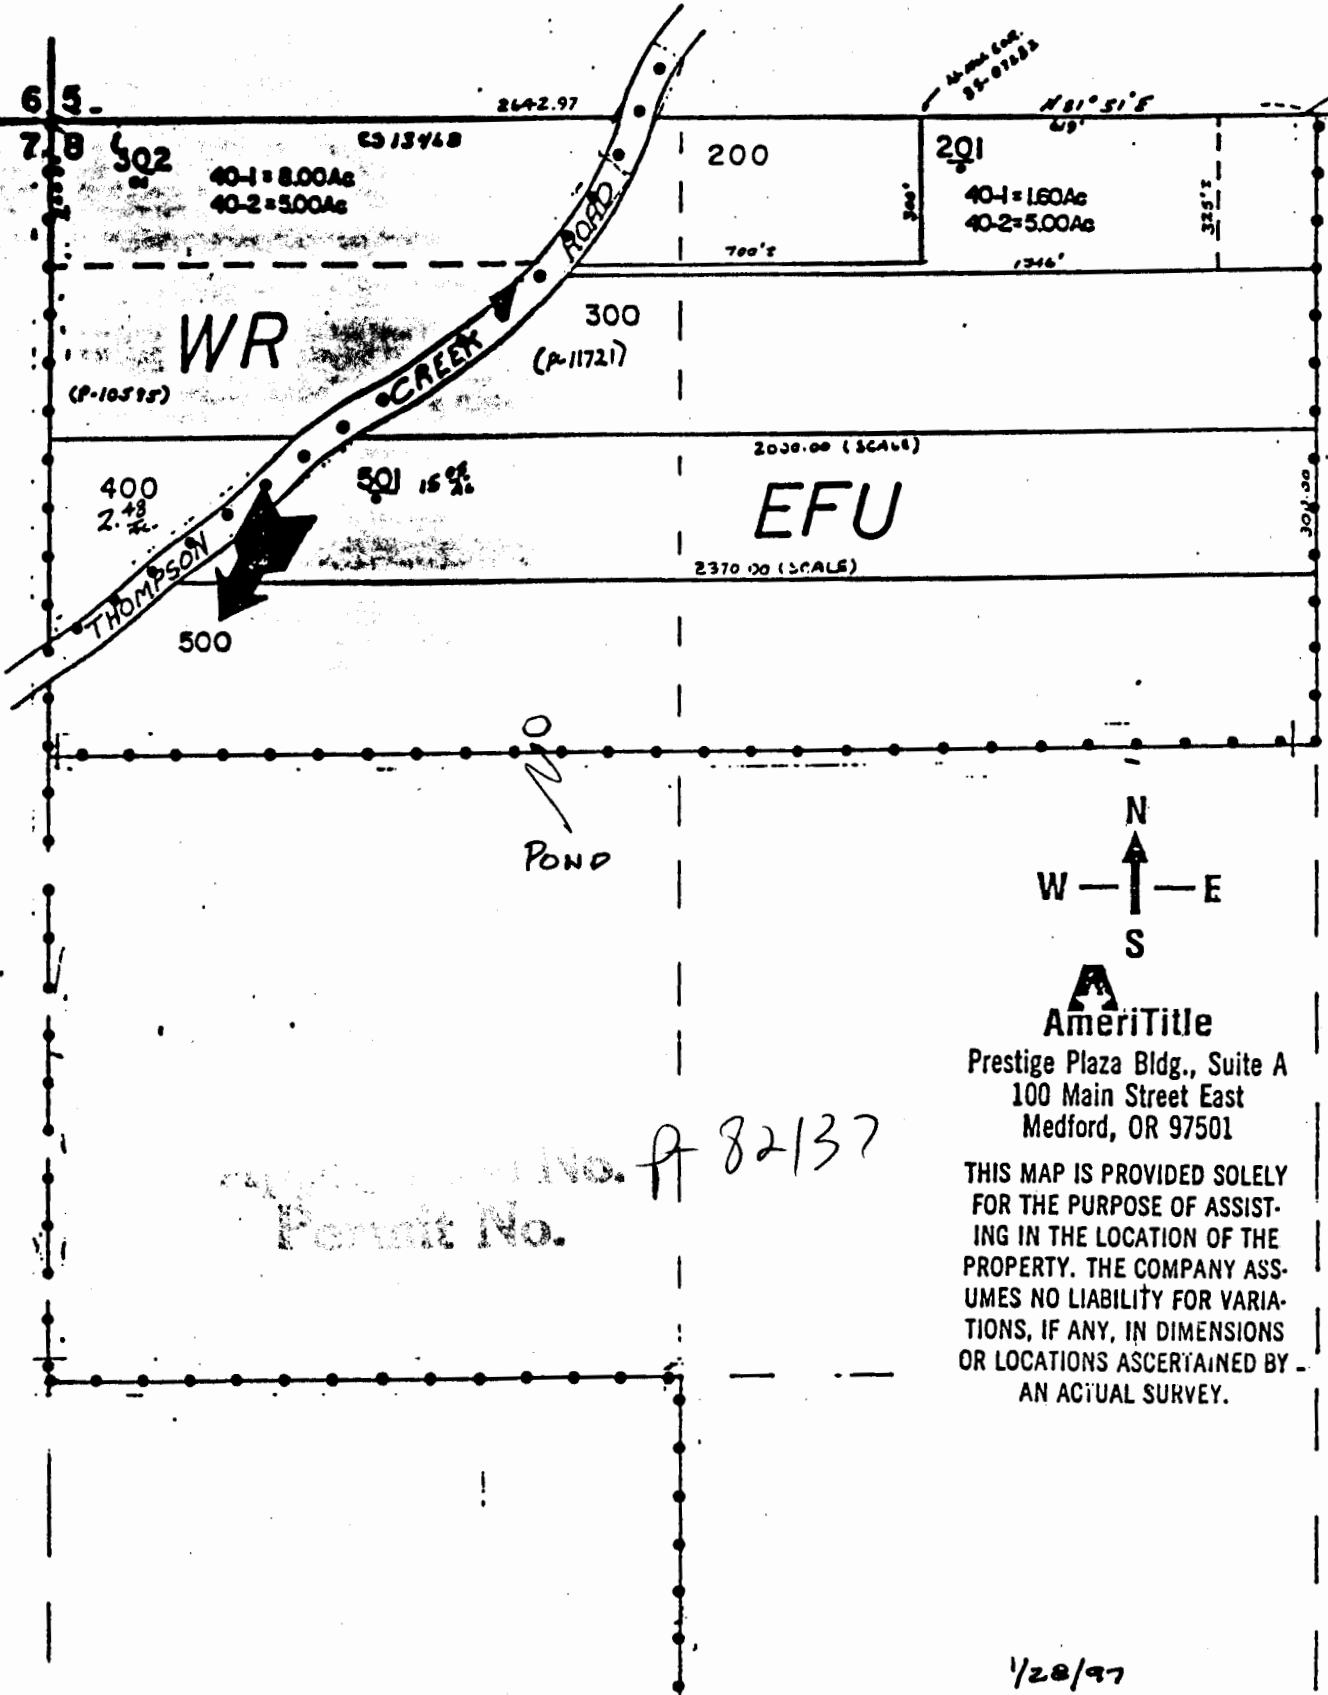

AmeriTitle

Prestige Plaza Bldg., Suite A
100 Main Street East
Medford, OR 97501

THIS MAP IS PROVIDED SOLELY
FOR THE PURPOSE OF ASSIST-
ING IN THE LOCATION OF THE
PROPERTY. THE COMPANY ASS-
UMES NO LIABILITY FOR VARI-
ATIONS, IF ANY, IN DIMENSIONS
OR LOCATIONS ASCERTAINED BY
AN ACTUAL SURVEY.

A 82137

Permit No.

1/28/97