


ATTACHMENT
A.

Map of Fish Pond Location 9S21E; Section 22; NE-SW; TL 101

Big Bottom Ranch; 40607 Rowe Creek Road
Twickenham, Oregon



SCALE: 1"=1320'

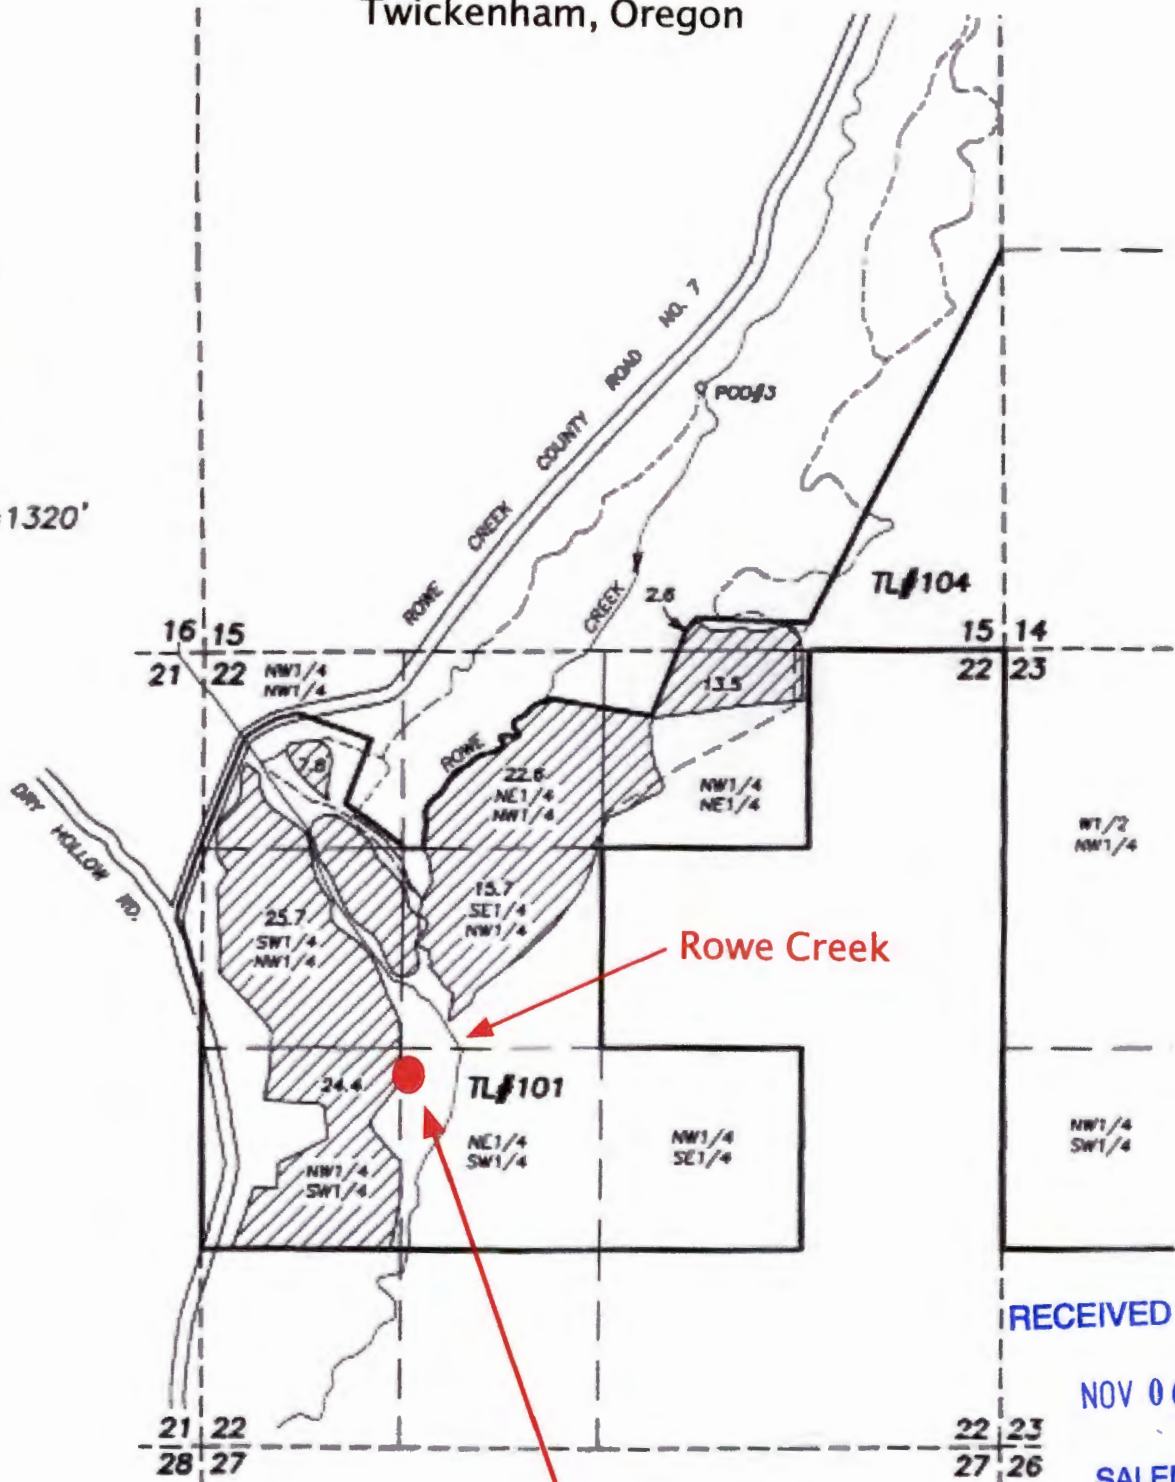

RECEIVED BY OWRD

NOV 06 2015

SALEM, OR

Center of Pond is approximately 2900 feet South
& 1300 feet East of NW Corner, Section 22

LATITUDE - 44.773027

LONGITUDE - 120.198848


R-00146

R-88x46

Attachment
B

Cross-Section of Fish Pond Location

9S21E; Section 22; NE-SW; TL 101

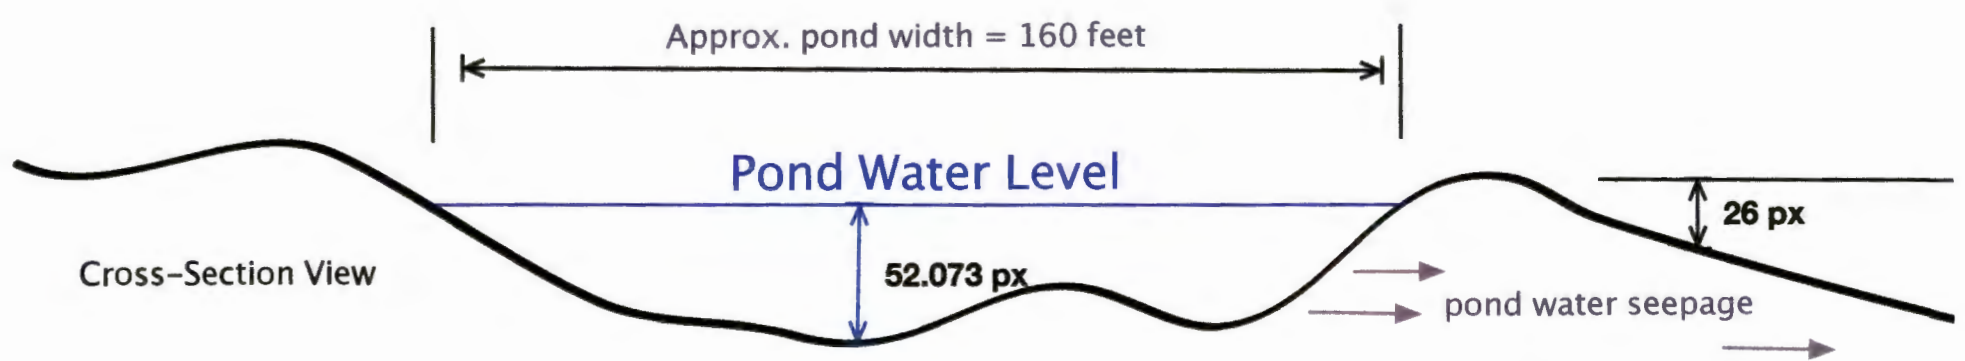

LEGEND

52.073 px = Max. Pond Depth, approx. 10 feet
26 px = Height of berm, approx. 6 feet

- X = Location of over flow
- = Direction of outflow ditching
- = Direction of pond water seepage

RECEIVED BY OWRD

NOV 06 2015

SALEM, OR



Surface Area View

North
↑

POND LOCATION

9S21E; Section 22; NE-SW; TL 101

Direction - from NW Corner of Section 22,
center of pond (X) is approx. 2900 feet south
and 1300 feet east.

Scale of Photo Map - 1 inch = 160 feet

R-8846

County

ROADS

SALEM, OH

NOV 06 2015

RECEIVED BY OWRD

09S21E

101

X

Fish Pond

ROWE CREEK



NORTH

Attachment