


# Groundwater Application Map for Jonoah Murphy

## 5 Acres of Nursery Use

### Map ID: 37S-2W-28-SW/SW-tax lot 1300

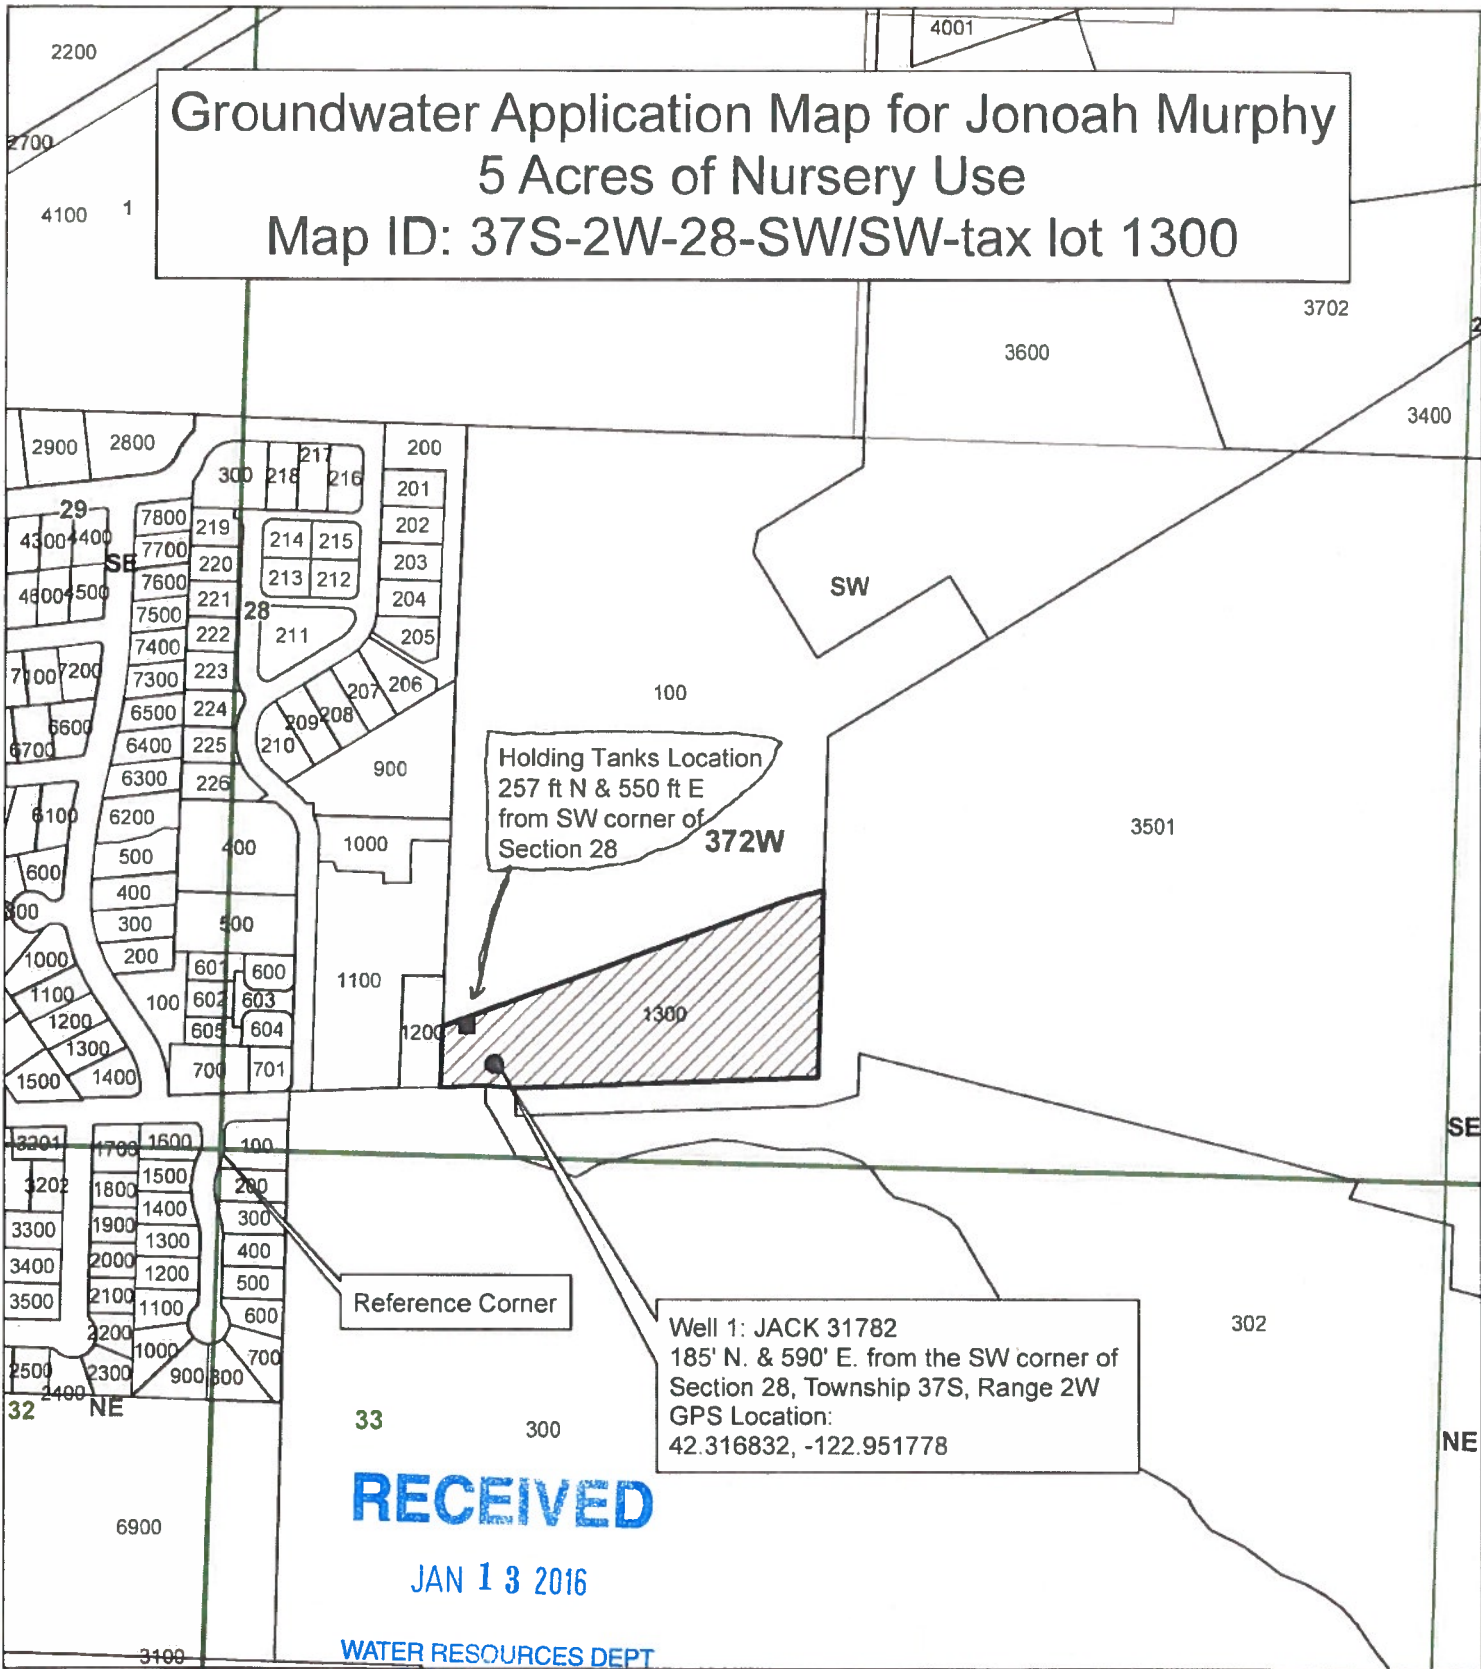

RECEIVED

JAN 13 2016

WATER RESOURCES DEPT  
SALEM, OREGON

#### Legend

- Holdig Tanks Location
- Well Location
- Place of Use (5 Acres of Nursery Use)
- Taxlot 1300
- Taxlots
- Townships
- Sections
- Quarter Sections
- Quarter Quarter Sections

1 inch = 400 feet



**JACKSON COUNTY  
WATERMASTER**

Prepared by Travis Kelly

This map is based on a digital database compiled by Jackson County from a variety of sources. Jackson County cannot accept responsibility for errors, omissions, or positional accuracy. There are no warranties, expressed or implied.